


PLAN NO. 1.

PLAN  
 Showing Portion of the  
 BAILEY, WILSON & CO.  
 COAL WORKINGS.  
 from the  
 MONONGAHELA RIVER TO THE PRESENT WORKINGS.  
 SITUATED IN HOFFMAN TOWNSHIP ALLEGHENY CO. PENN.  
 1862

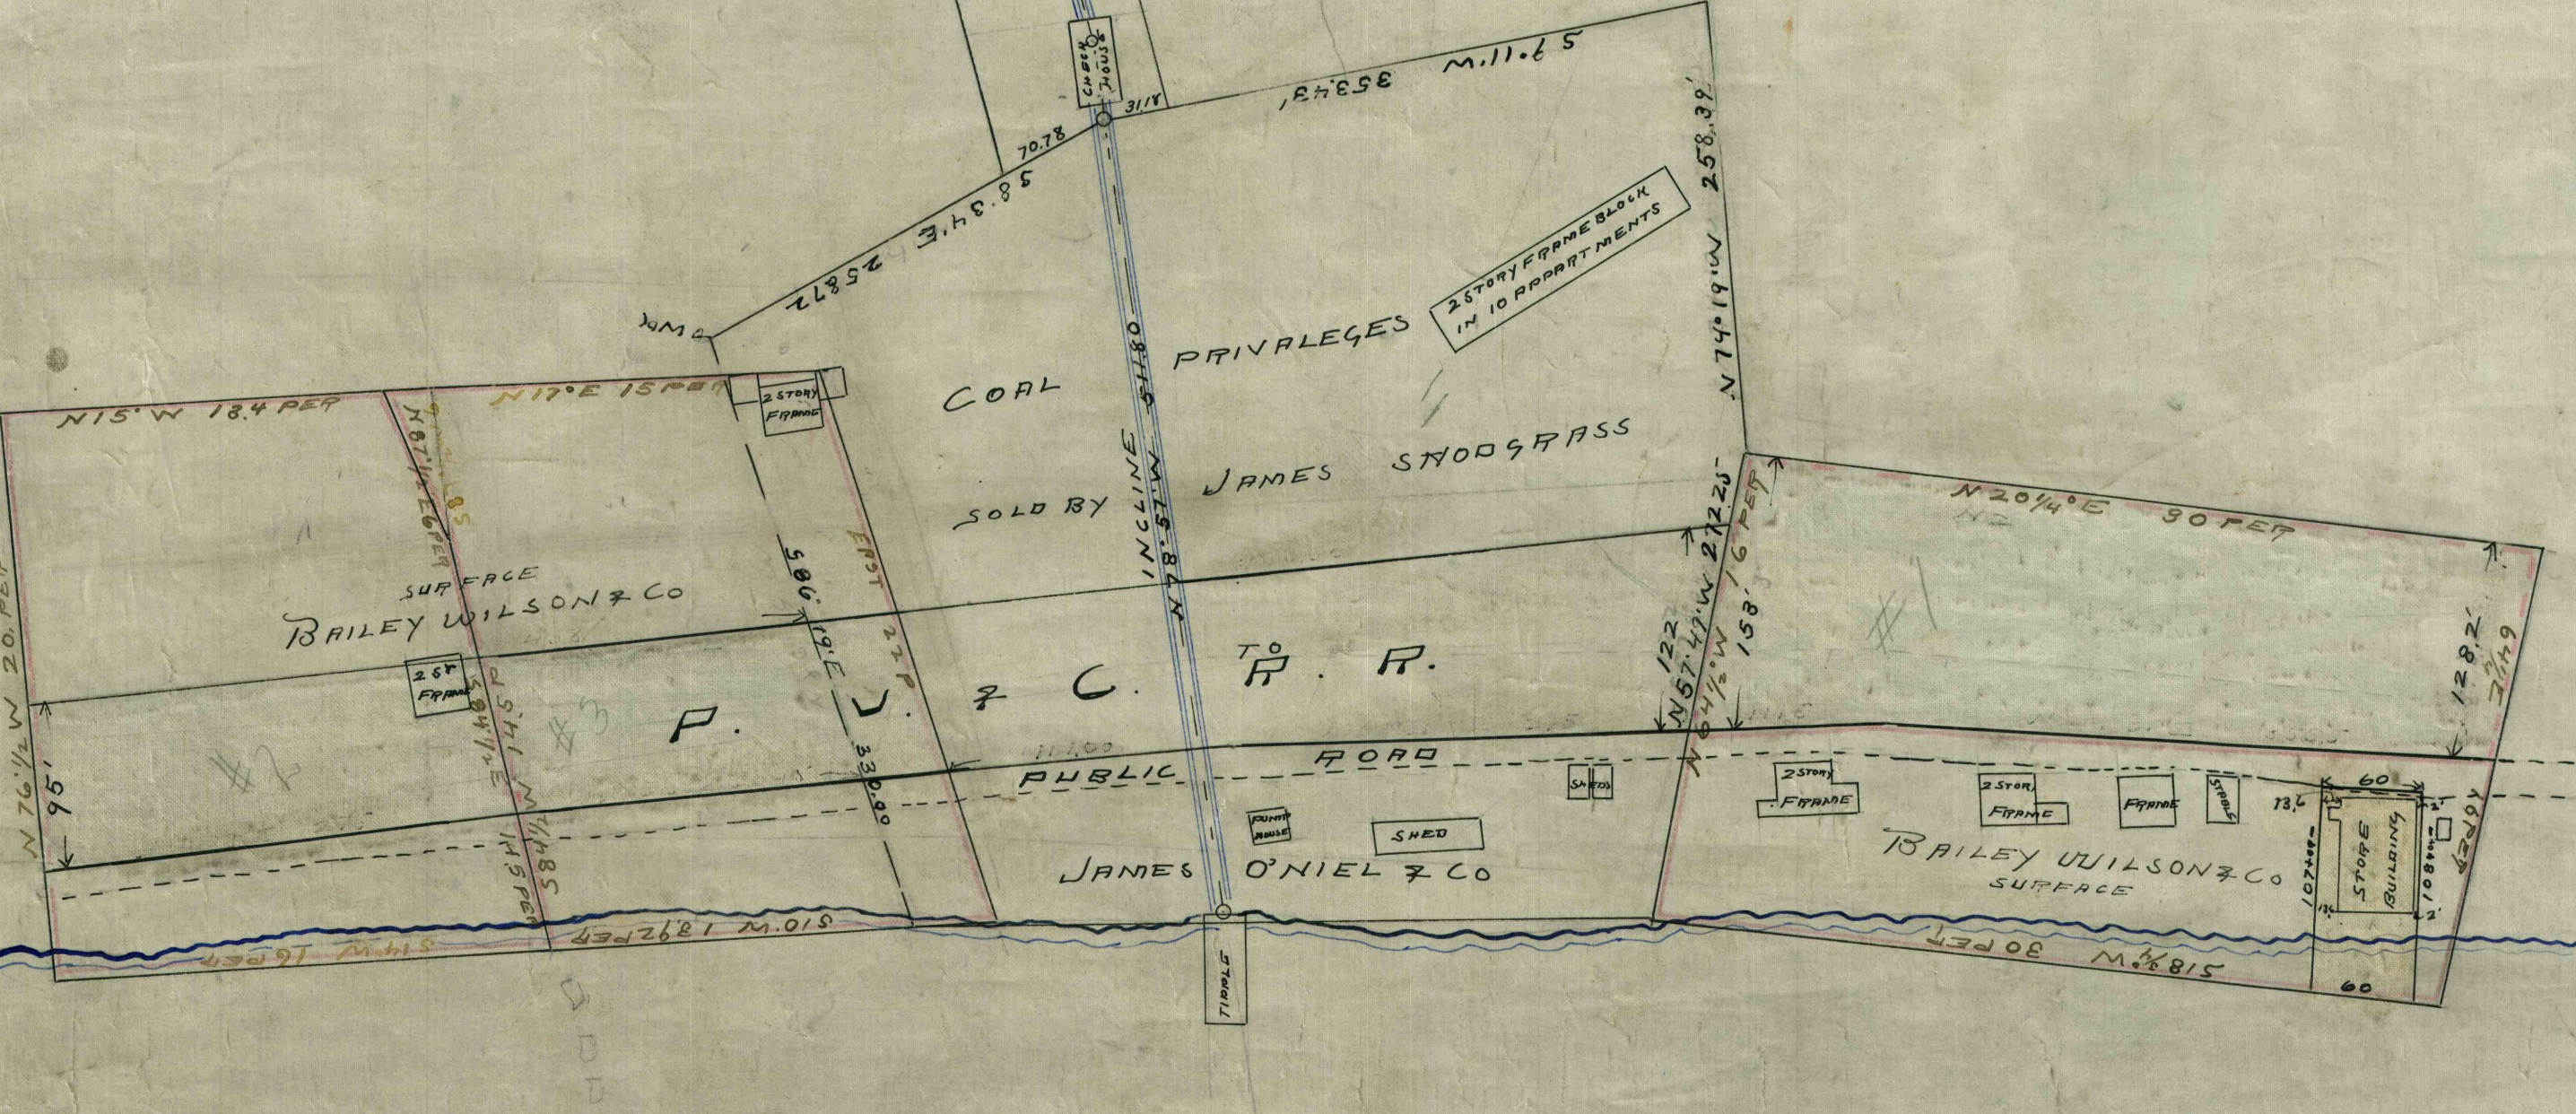

MONONGAHELA RIVER.