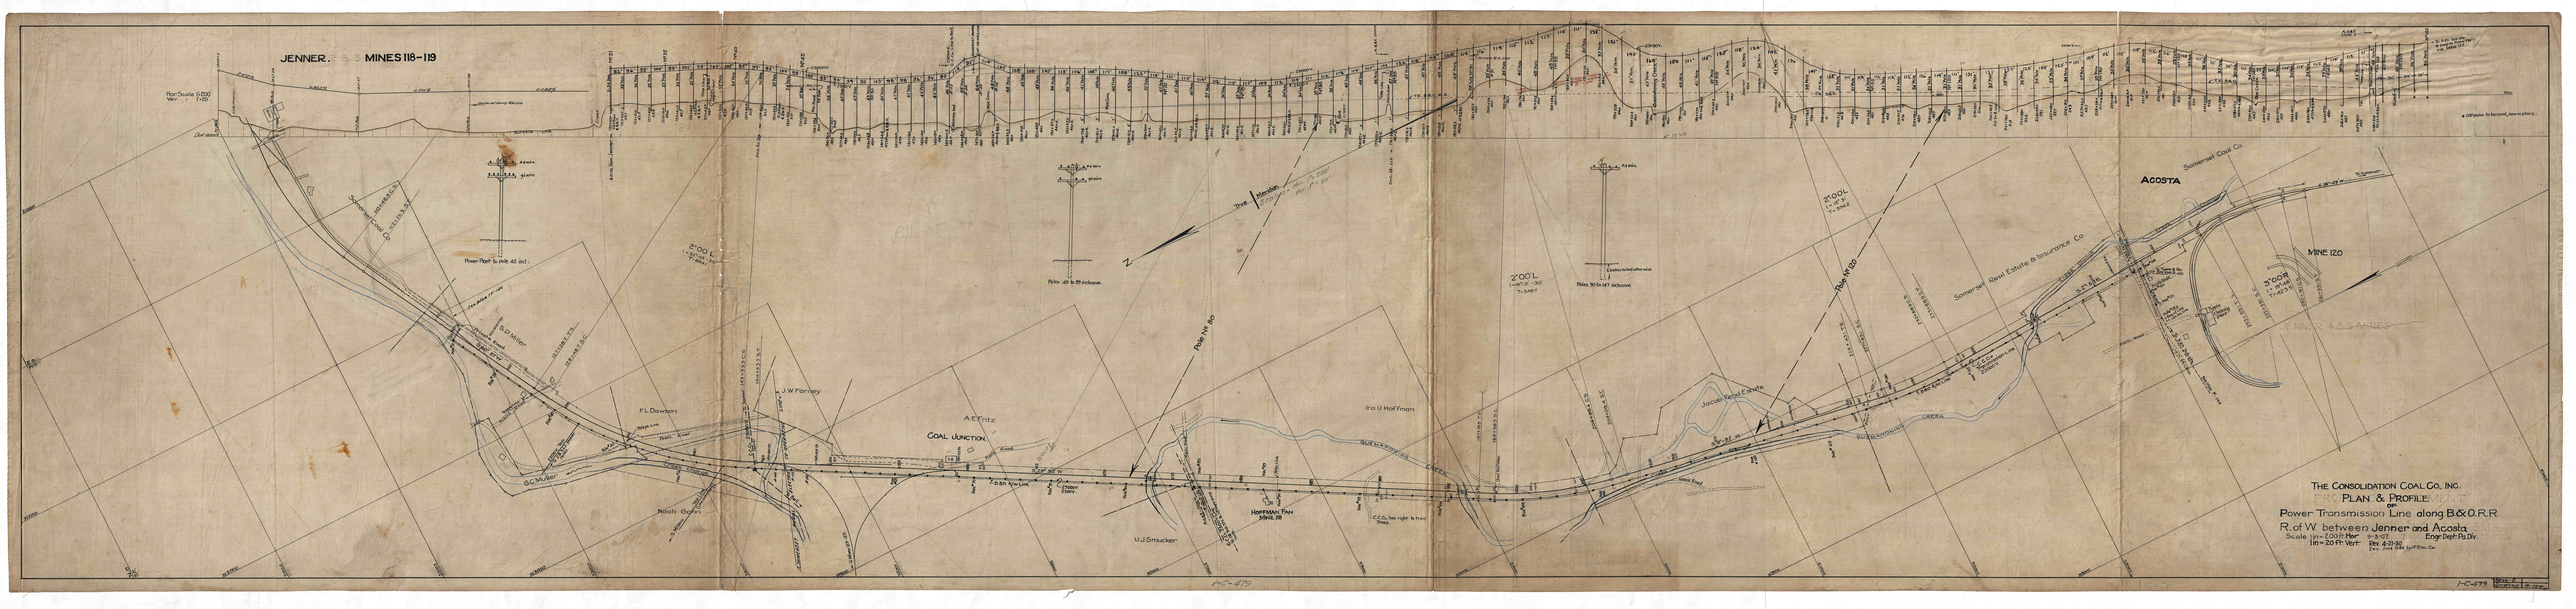
JENNER. MINES 118-119
Somerset Coal Co
Power Pipe 16 inch. 42 ind.
S.D. Miller
J.W. Forney
F.L. Dawkins
G.C. Muller
Road Gap
A.E. Fritz
COAL JUNCTION
Ira U. Hoffman
Jonas Feltz Estate
U.J. Smucker
HOFFMAN FAN MINE 18
Rock Run
QUEMAHONING CREEK
Somerset Real Estate & Insurance Co
ACOSTA
Somerset Coal Co
MINE 120
