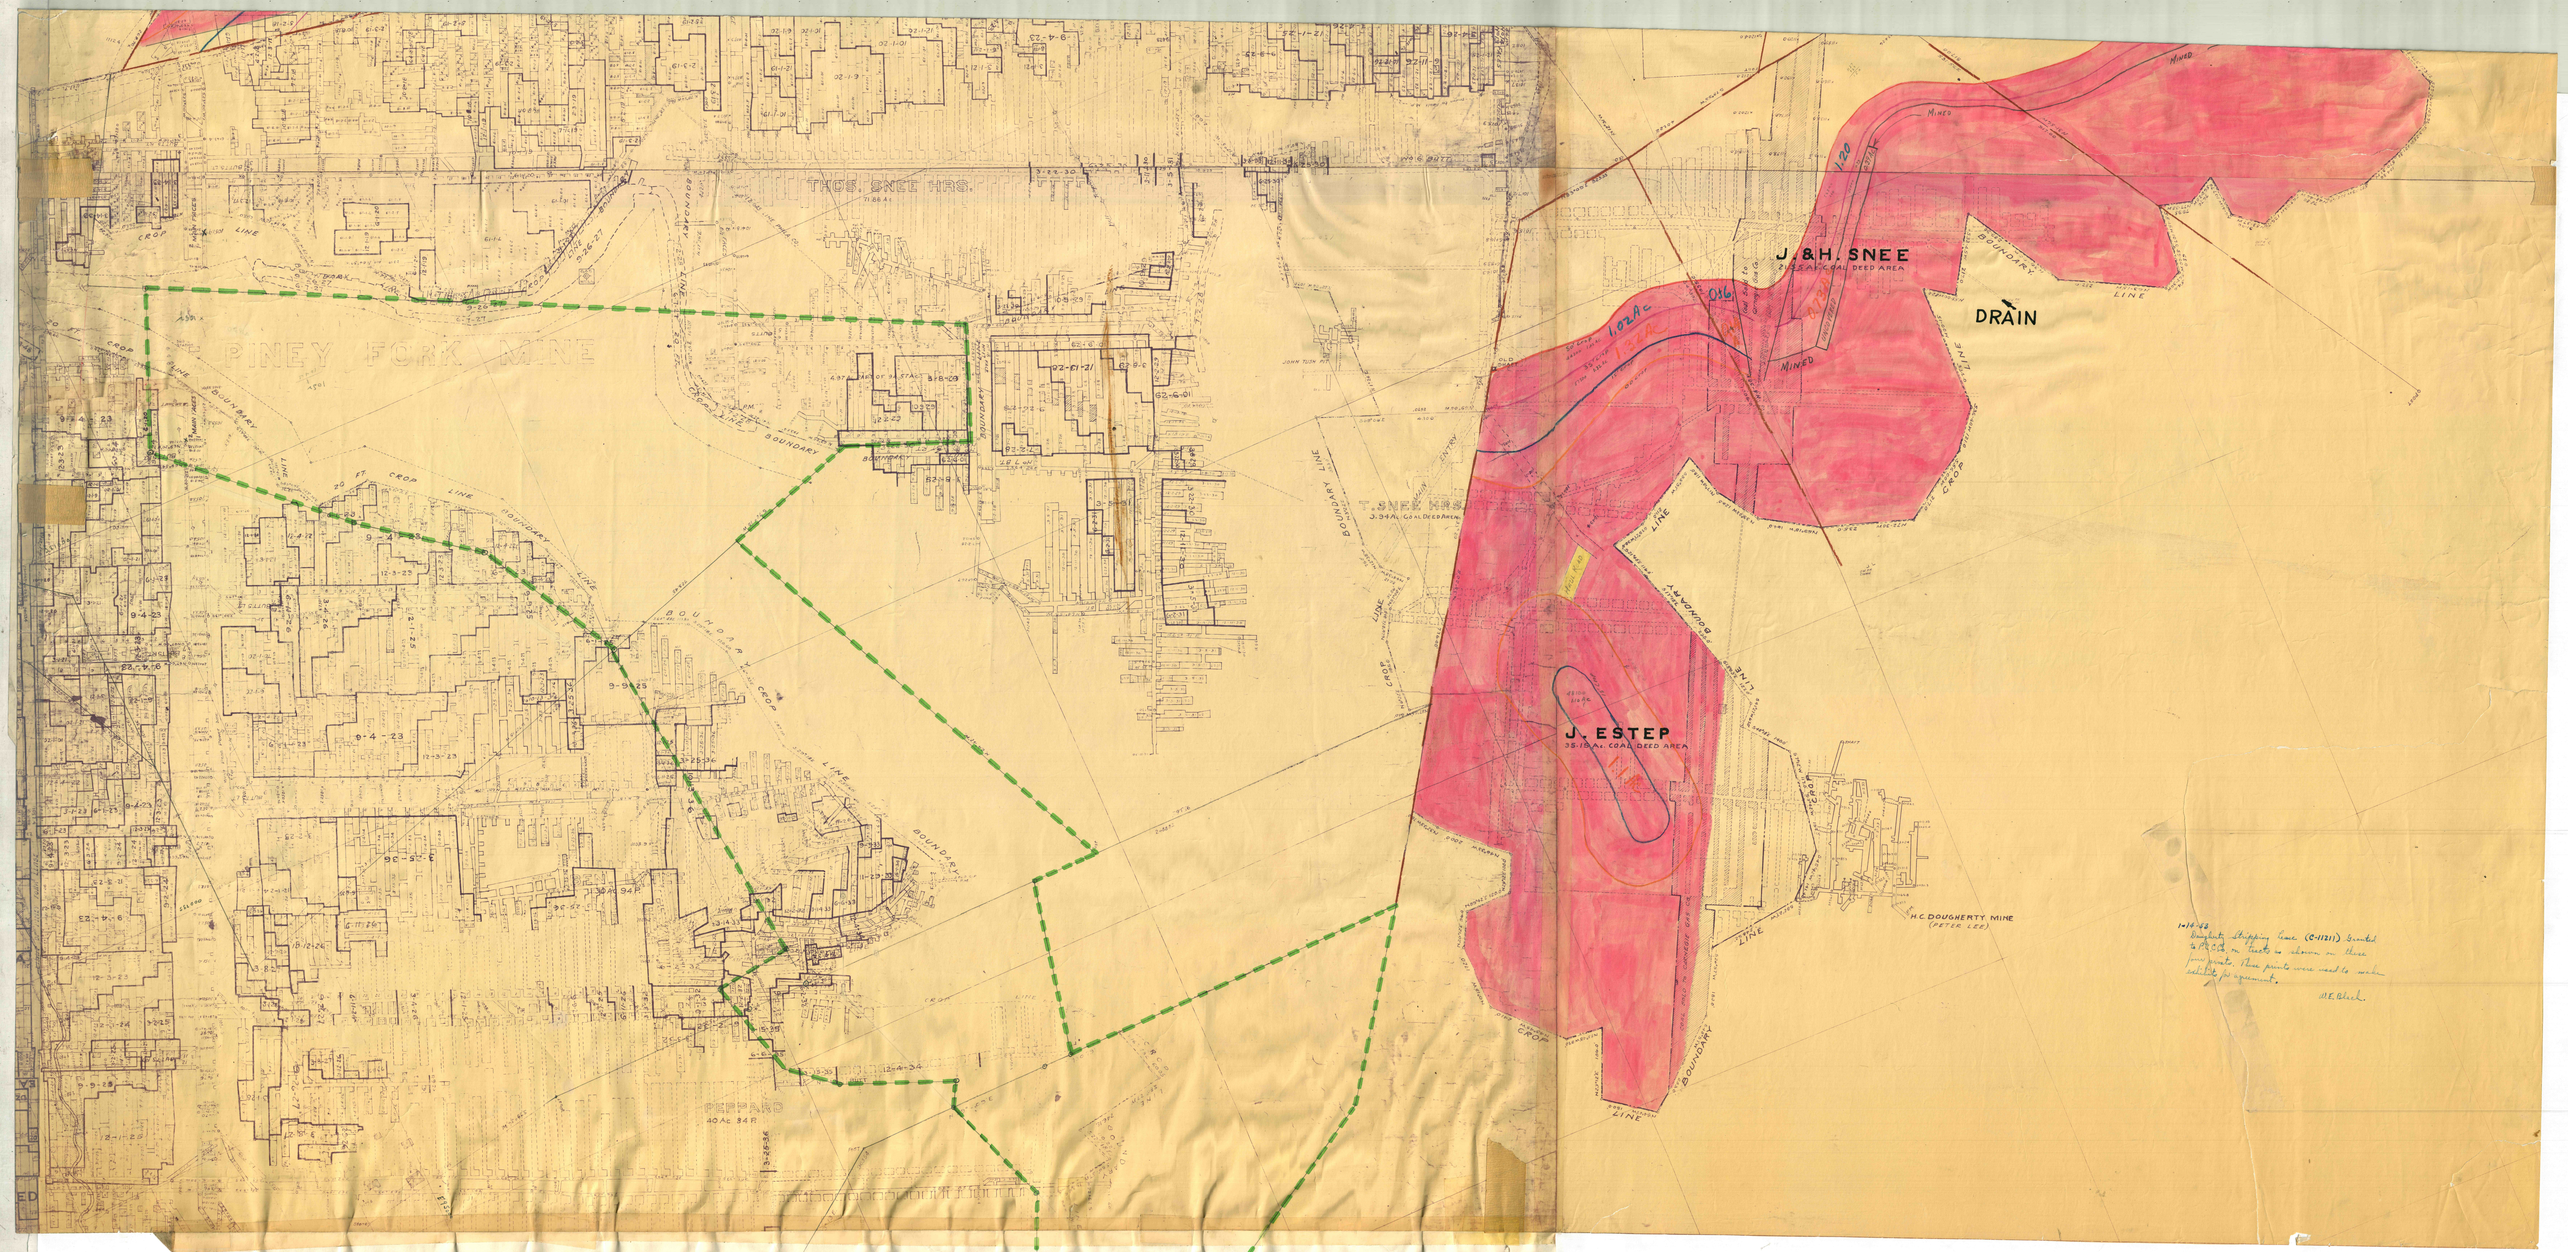
THOS. SNEE HRS.
PINEY FORK MINE
J. & H. SNEE
21.23 A. COAL DEED AREA
DRAIN
MINED
T. SNEE HRS.
3.34 A. COAL DEED AREA
J. ESTEP
35.18 A. COAL DEED AREA
H.C. DOUGHERTY MINE
(PETER LEE)
PEPPARD
40 AC 84 P
BOUNDARY
CROP
LINE
1-16-48
Daughert Shipping Mine (C-11211) Granted to P.R.C. on tracts in adition on these four pages. These points were used to make solids for experiments.
W.E. Reich