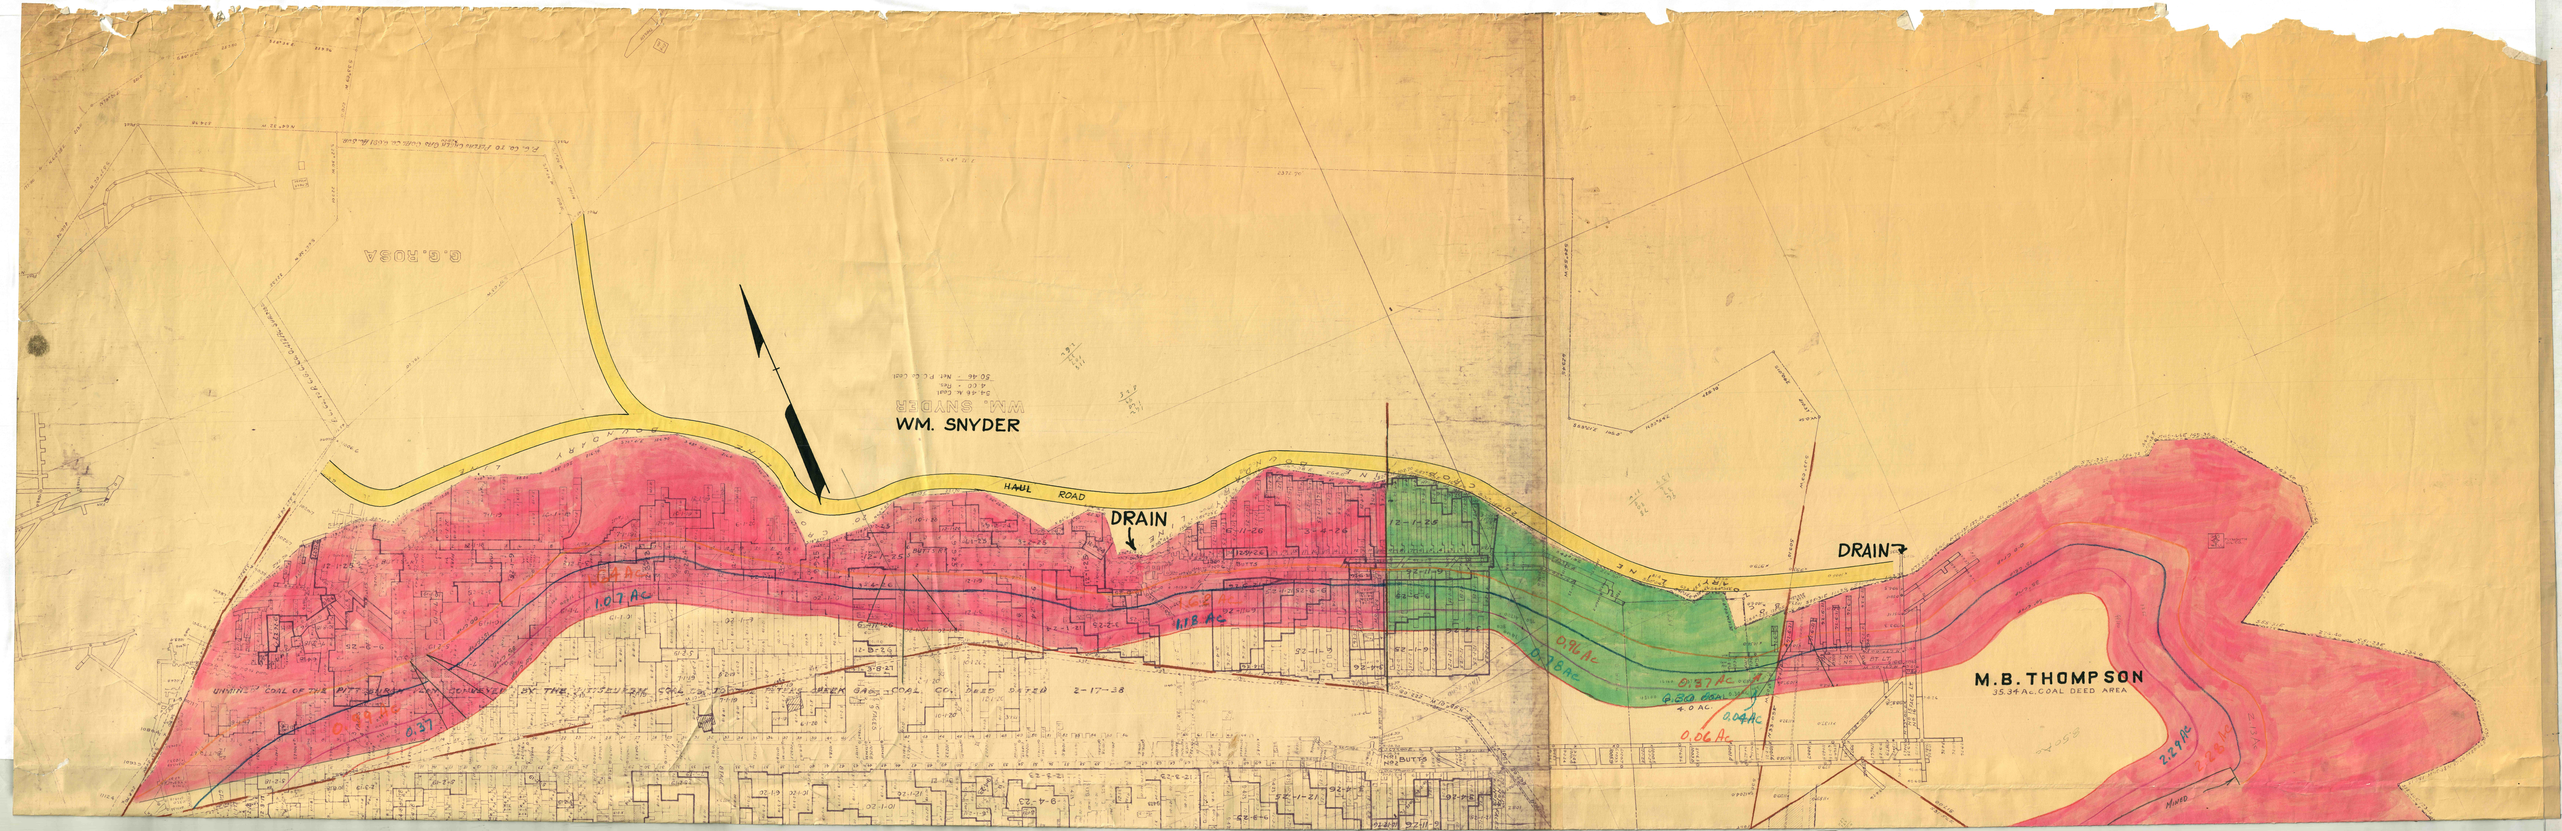
WM. SNYDER
HAUL ROAD
DRAIN
DRAIN
M.B. THOMPSON
35.34 Ac. COAL DEED AREA
1.07 Ac
1.18 Ac
0.96 Ac
0.78 Ac
0.87 Ac
0.50 Ac
4.0 AC
0.04 Ac
0.06 Ac
2.29 Ac
2.26 Ac
0.37
BUTTS
MINED