


PLAN

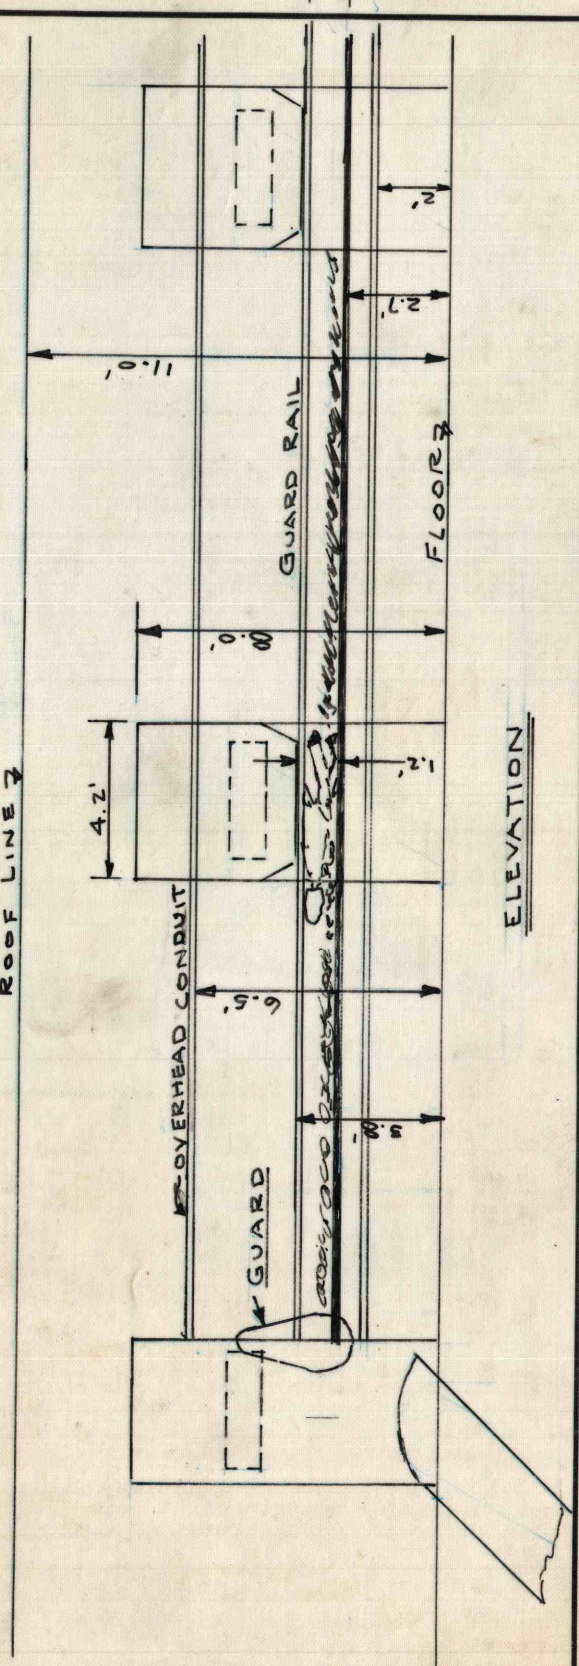

ELEVATION

JONES & LAUGHLIN STEEL CORPORATION PITTSBURGH, PA.		SCALE 1" = 5'
VESTA SHANNOPIN COAL DIVISION LABELLE PREP PLANT		CHK. BY GAN/rot
FATAL THEODORE LOZOSKY AT 306-A BELT LINE 9-22-77		DATE 9-24-77
		D-1714-2