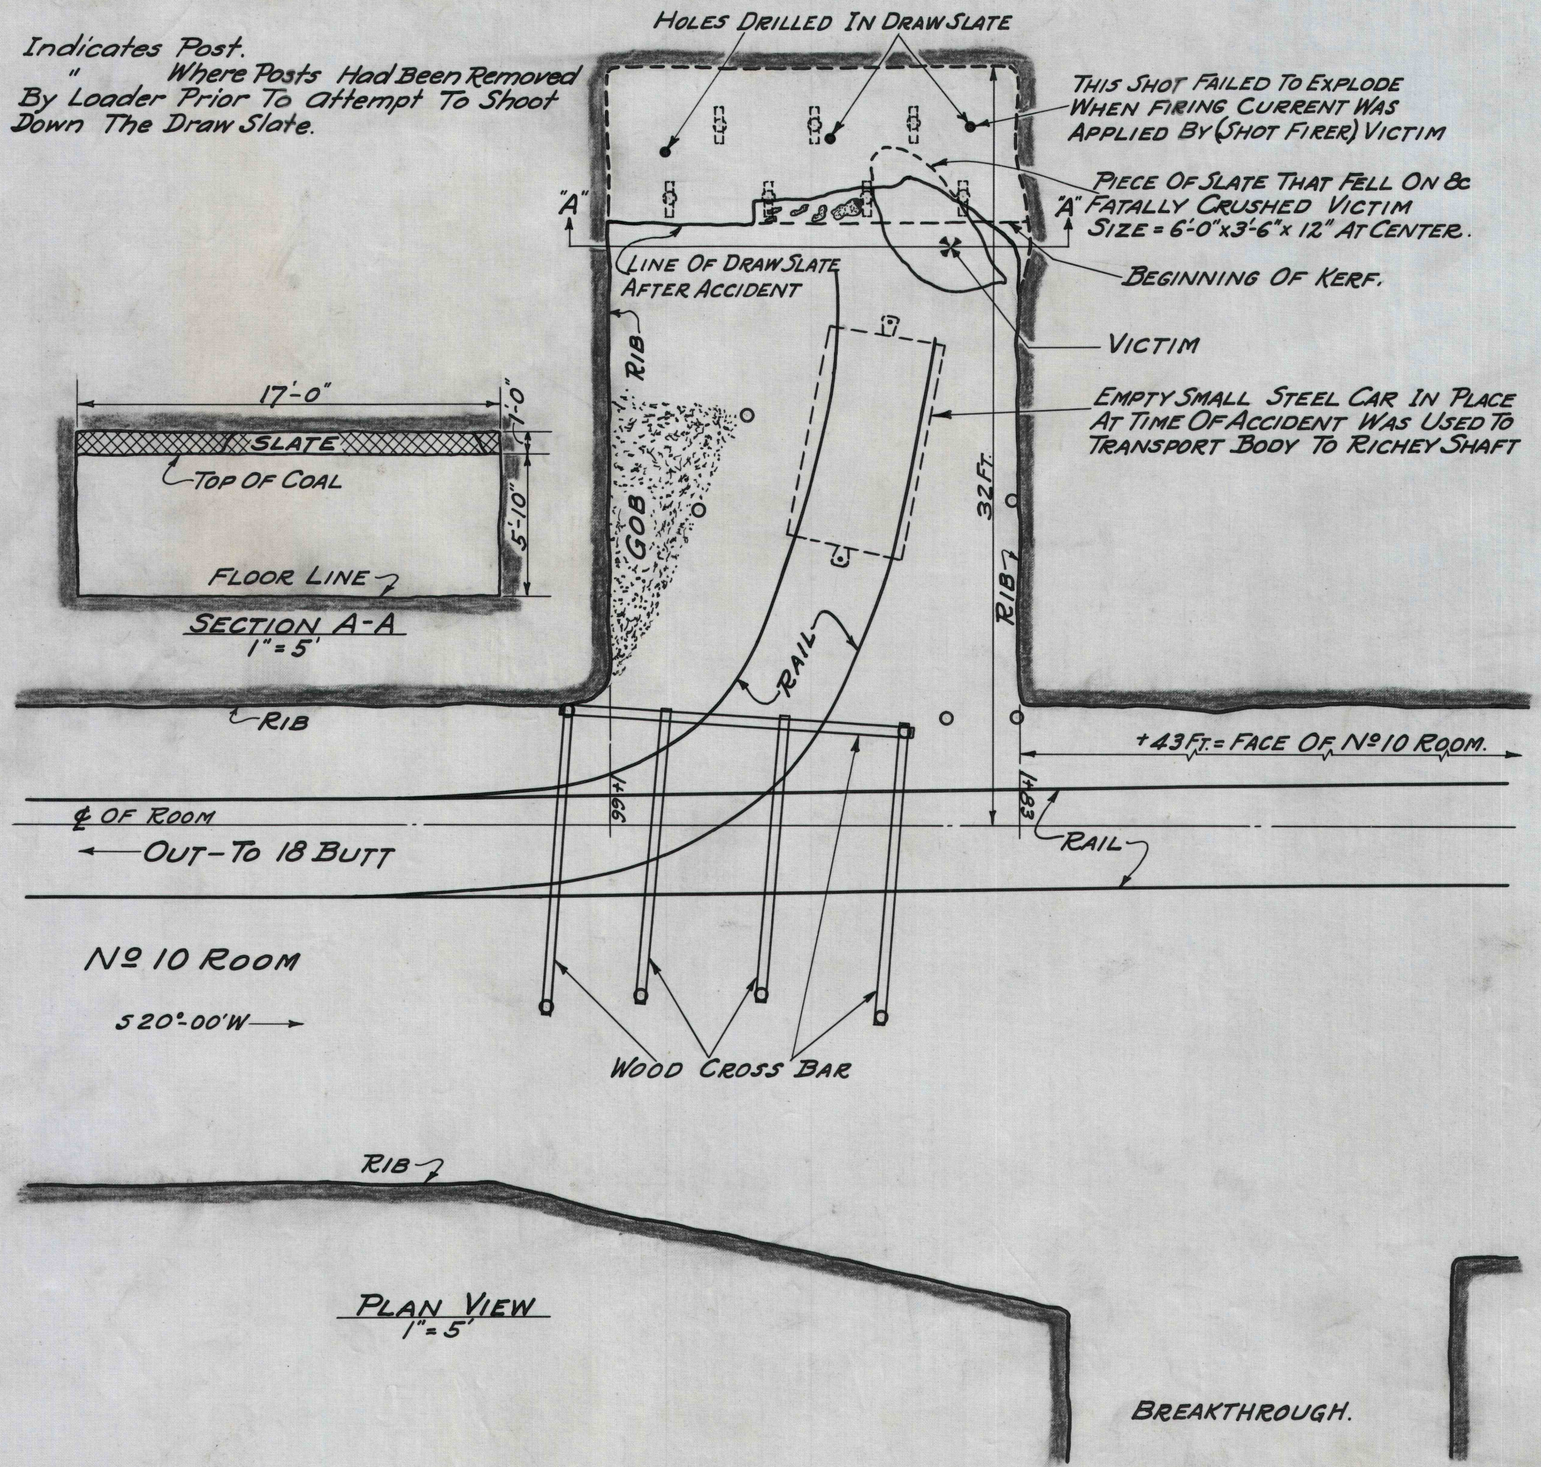

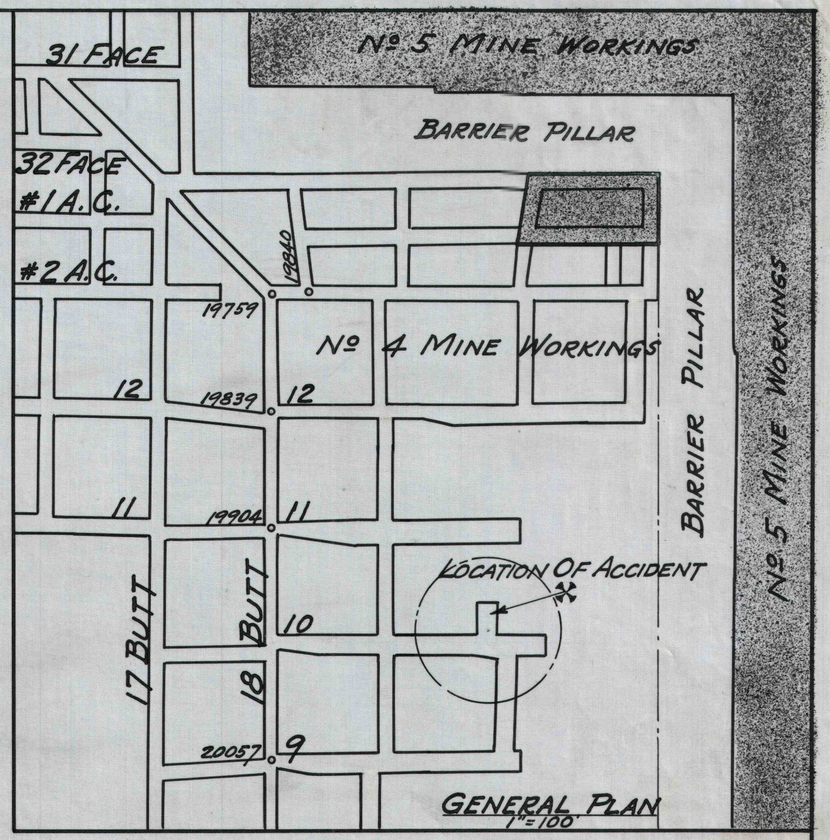

Victim - William J. Dedeur - Age 54 Years.
Occupation - Shot Firer - Check Nº 3220.
Time Of Accident - Approx 11.00 a.m. May 13-1942.
Place " " 2nd Breakthro Nº10 Rm. 18 Butt 32 Face.
Crush Of Head & Chest Causing Instant Death.

The Place Had Been Cleaned Up By Loader And The Slate Had Been Posted As In Standard Practice, 3 Posts In Rear Row Next To Face Of Place And 4 " " Front ". Three Holes In Slate Were Tamped And Charged Ready For Shooting. Loader Then Knocked Out Seven Posts, And Shot Firer Attempted To Shoot Hole Next To Right Rib. Shot Failed To Explode And Victim Went Back Into Place To Inspect Cable When Piece Of Slate Fell Catching Victim And Causing Instant Death By Crush Of Head & Chest.

JONES & LAUGHLIN STEEL CORP.
VESTA COAL DIVISION
CALIFORNIA, PA.

MINE Nº 4. PLAN SHOWING LOCATION OF FATAL ACCIDENT TO WILLIAM J. DEDEUR

DR. G.H.E.	DATE 5/14/42	C-910
TR. G.H.B.	SCALE AS SHOWN	