

N20-00E

"A" FACE

To Sta. 779

Posts 1 & 2 Were Topped by Slab, Which fell at Time of Accident.

Posts 3, 4 & 5 Were Topped before Accident occurred, When Place Was Shot

These Posts Were not Replaced

Rib Prior to Shooting

Location of Holes Where Shots Were fired

Present Rib Line

S70-00E

Loaded Car.

Track

Car 1/2 Loaded


21'-0"

Present Rib Line


Place marked to be narrowed down here

PLAN

SCALE 1"=5'

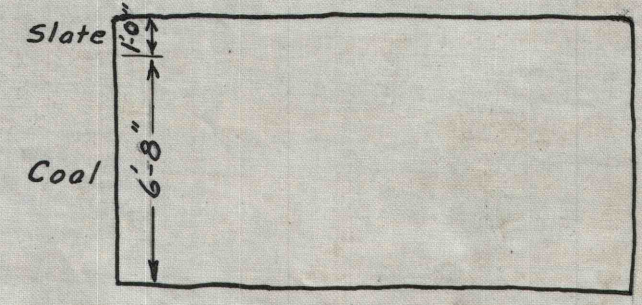

Section A-A

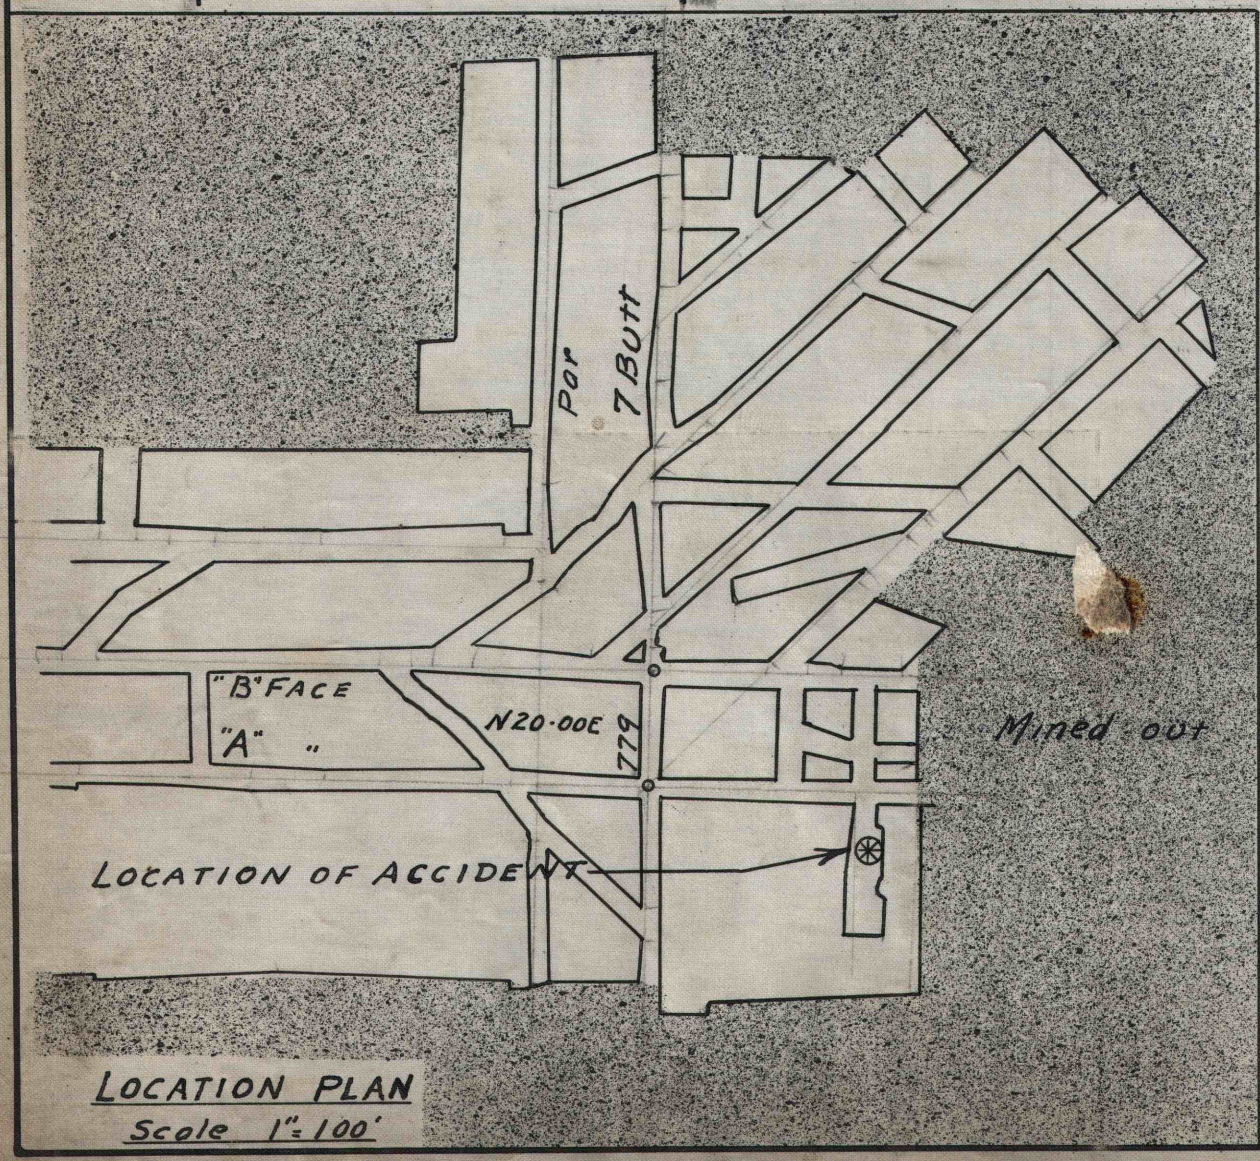

LOCATION PLAN Scale 1"=100'

Sept-8-1941 John Shubelka Loader, Check No. 47, Was Working at Point Marked ⊗ When Slab Topped over striking him and causing instant death. Victims buddy, Jennings Ewing, Check No. 121 Was standing at Point Marked ⊙ at Time of Accident. Accident occurred at 8-30 A.M.

⊗ Posts standing at time of Accident
 **** Loose Coal & Slate

JONES & LAUGHLIN STEEL CORP.		C-899
VESTA COAL DIVISION. CALIFORNIA, PA.		
MINE No 6, PLAN SHOWING LOCATION OF JOHN SHUBELKA FATAL ACCIDENT		
DR. E.R.C.	Date, Sept-9-1941	C-899
TR. G.H.E.	Scale as shown	