

JONES & LAUGHLIN STEEL CORPORATION-KEYSTONE WORKS

JOB MACHINE SHOP.

FOR VESTA COAL CO. - FLOREFFE PA.

Made by WR. Date

Checked by *CRH* Date

Order No. 1078-7

Revised Rivets


Open Holes unless noted

Sheet No. MS2

Paint

Inspection

Details of

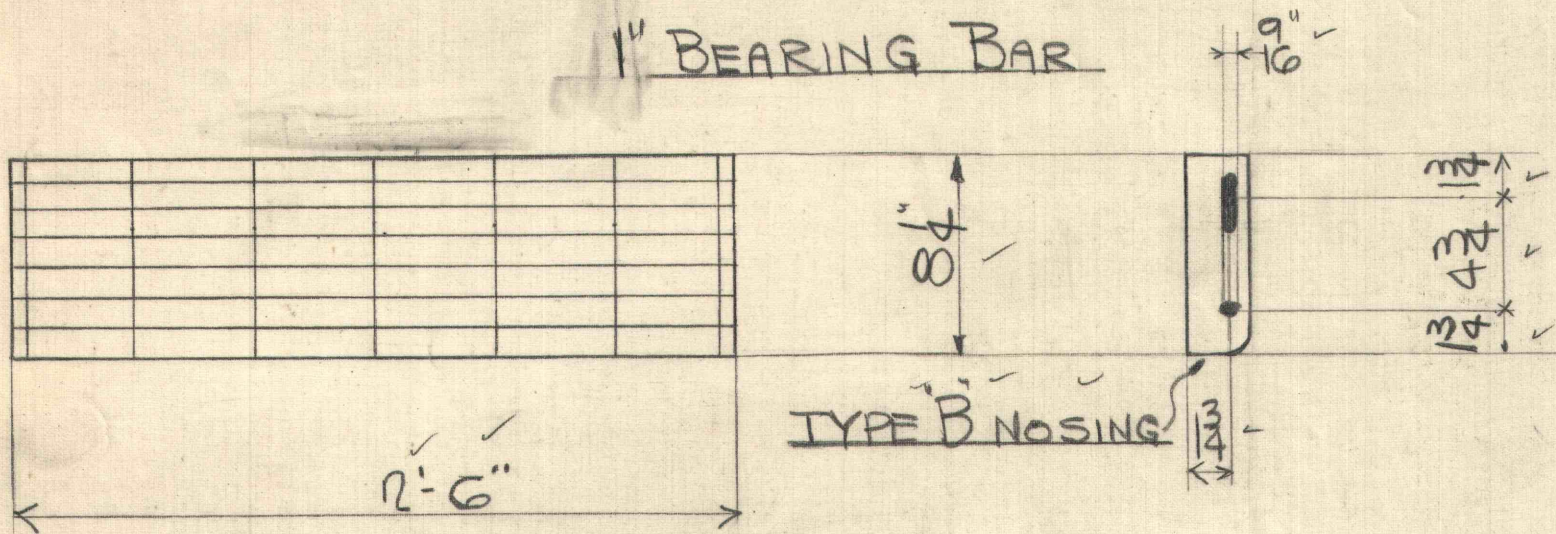

40 TRI-LOK SAFETY TREADS