

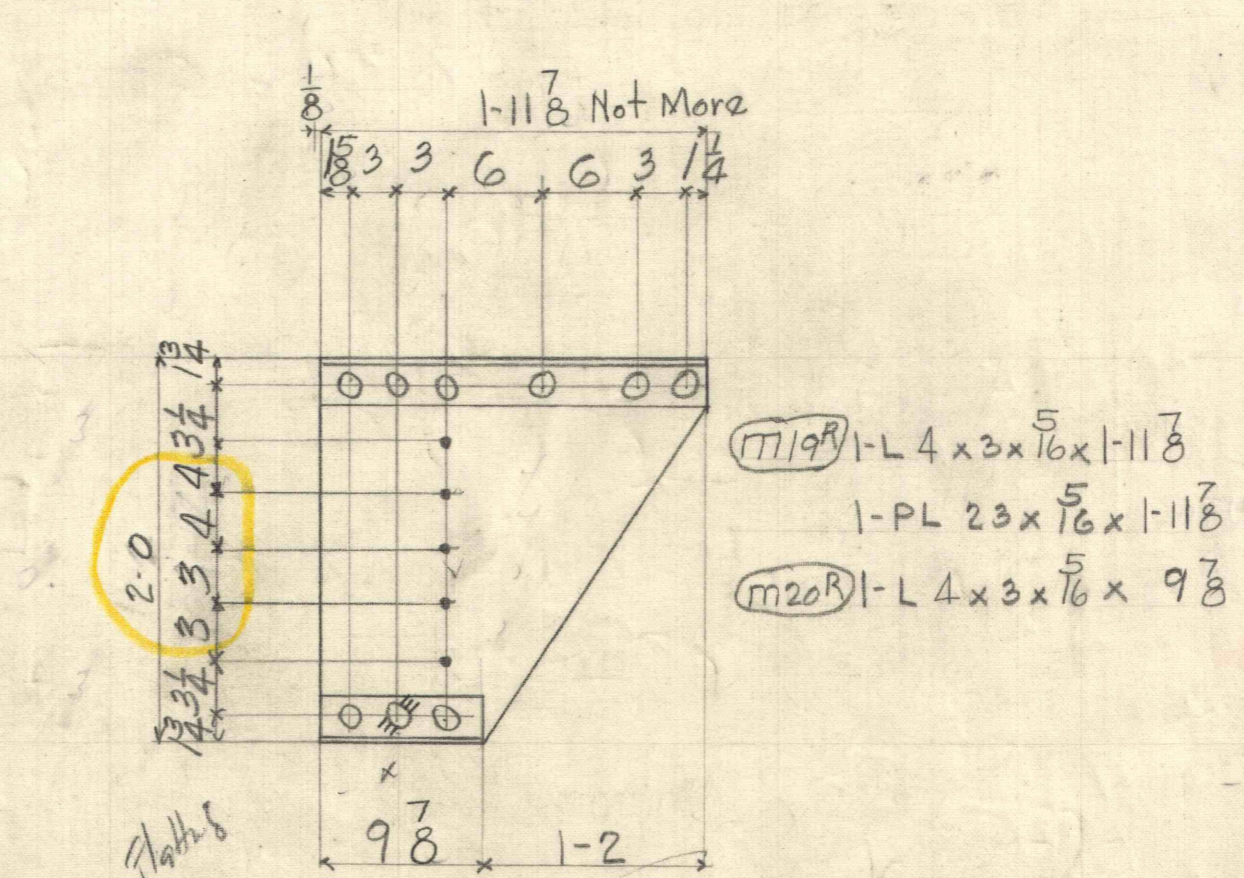


One Girder G12^R as shown
One do G12^L opp hand

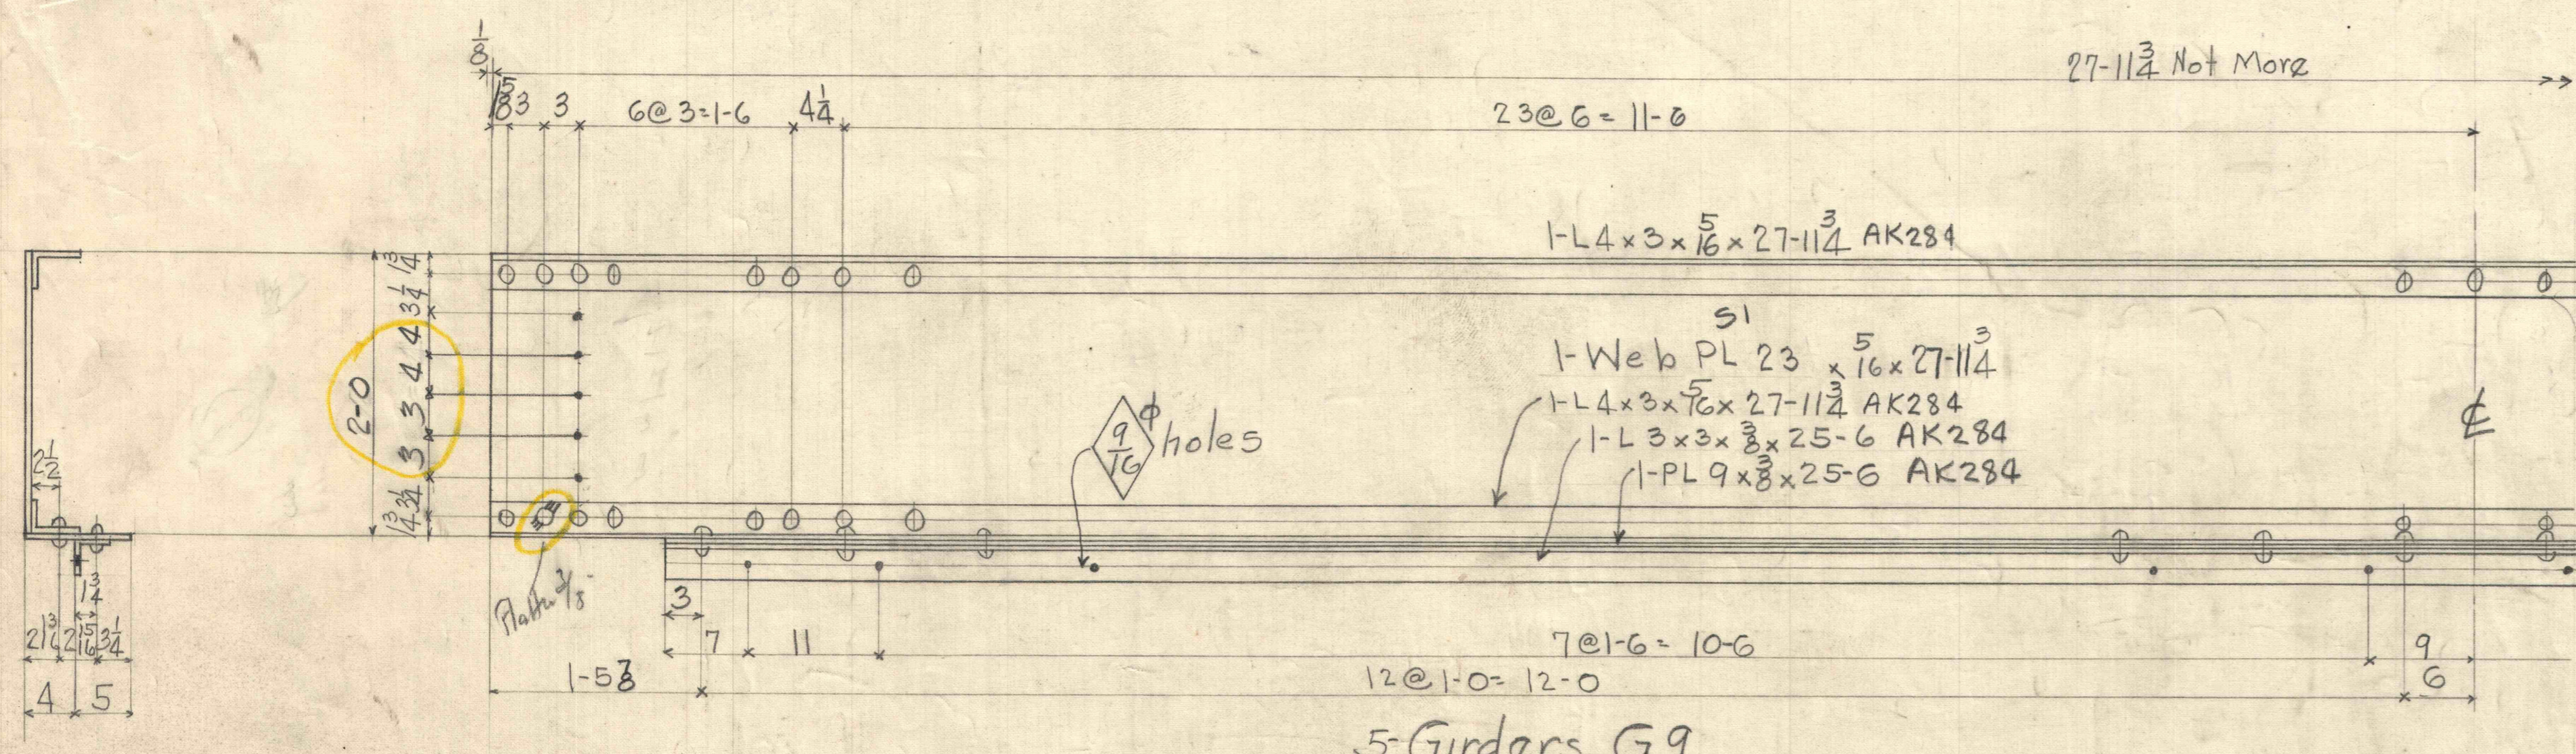

2- Girder G10^R as shown
2 do G10^L opp hand

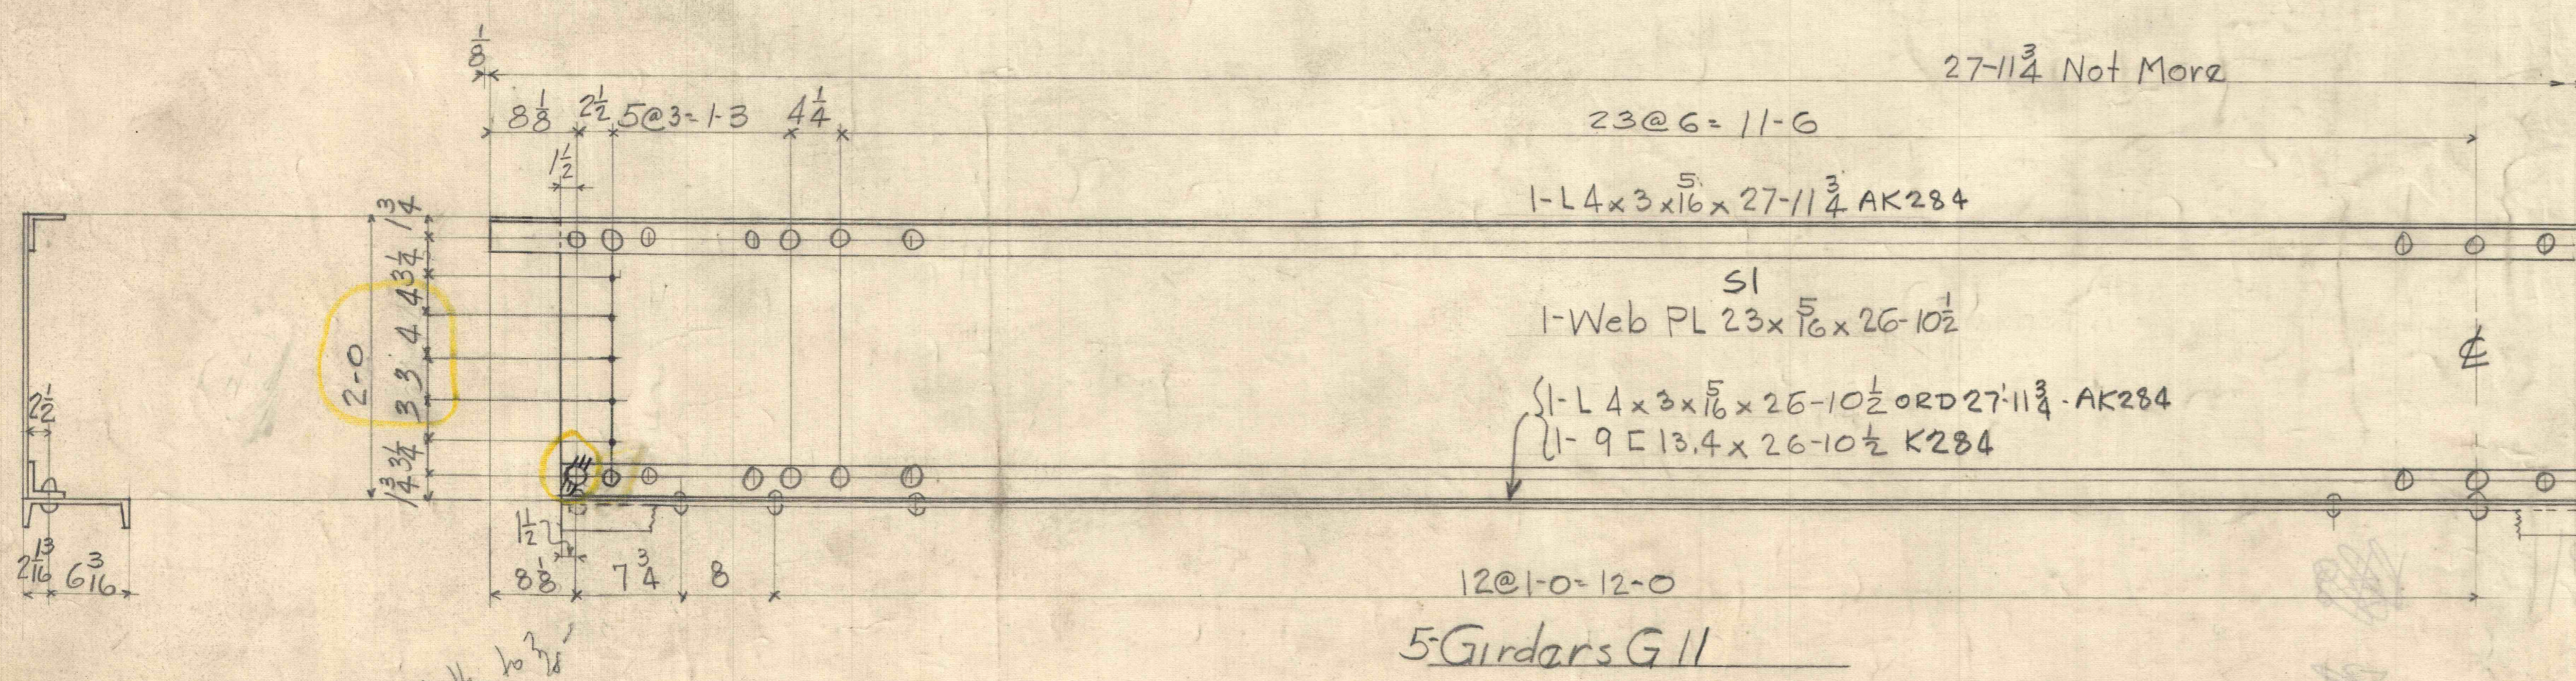

5 Girders G11

JONES & LAUGHLIN STEEL CORPORATION KEYSTONE DEPT.			
FOR Vesta Coal Co Floreffe Pa			
JOB Machine Shop			
DETAILS OF Girders Crane Stops Hook Bolts			
MADE <u>EBR</u>	DATE	TRACED	DATE
CH'K'D <u>CBH</u>	DATE <u>7-19-30</u>	REVISED	<u>7-25-30</u>
RIVETS <u>3/8</u>	OPEN HOLES <u>1/8</u>		
PAINT <u>One coat</u>			
INSPECTION			
DRAWING <u>C3</u>		SHEET No. <u>C3</u> ORDER NO. <u>1078-3</u>	
Total D'w'g's.	BILL SHT. <u>4</u>		

7/21/30