



MATHER COLLIERIES

MATHER, PA.

COAL PROPERTIES SITUATED IN MORGAN AND JEFFERSON
TOWNSHIPS AND JEFFERSON BOROUGH, GREENE COUNTY, PA.

SCALE 1/4" = 100'
PITTSBURGH, PA.

1" = 1000'

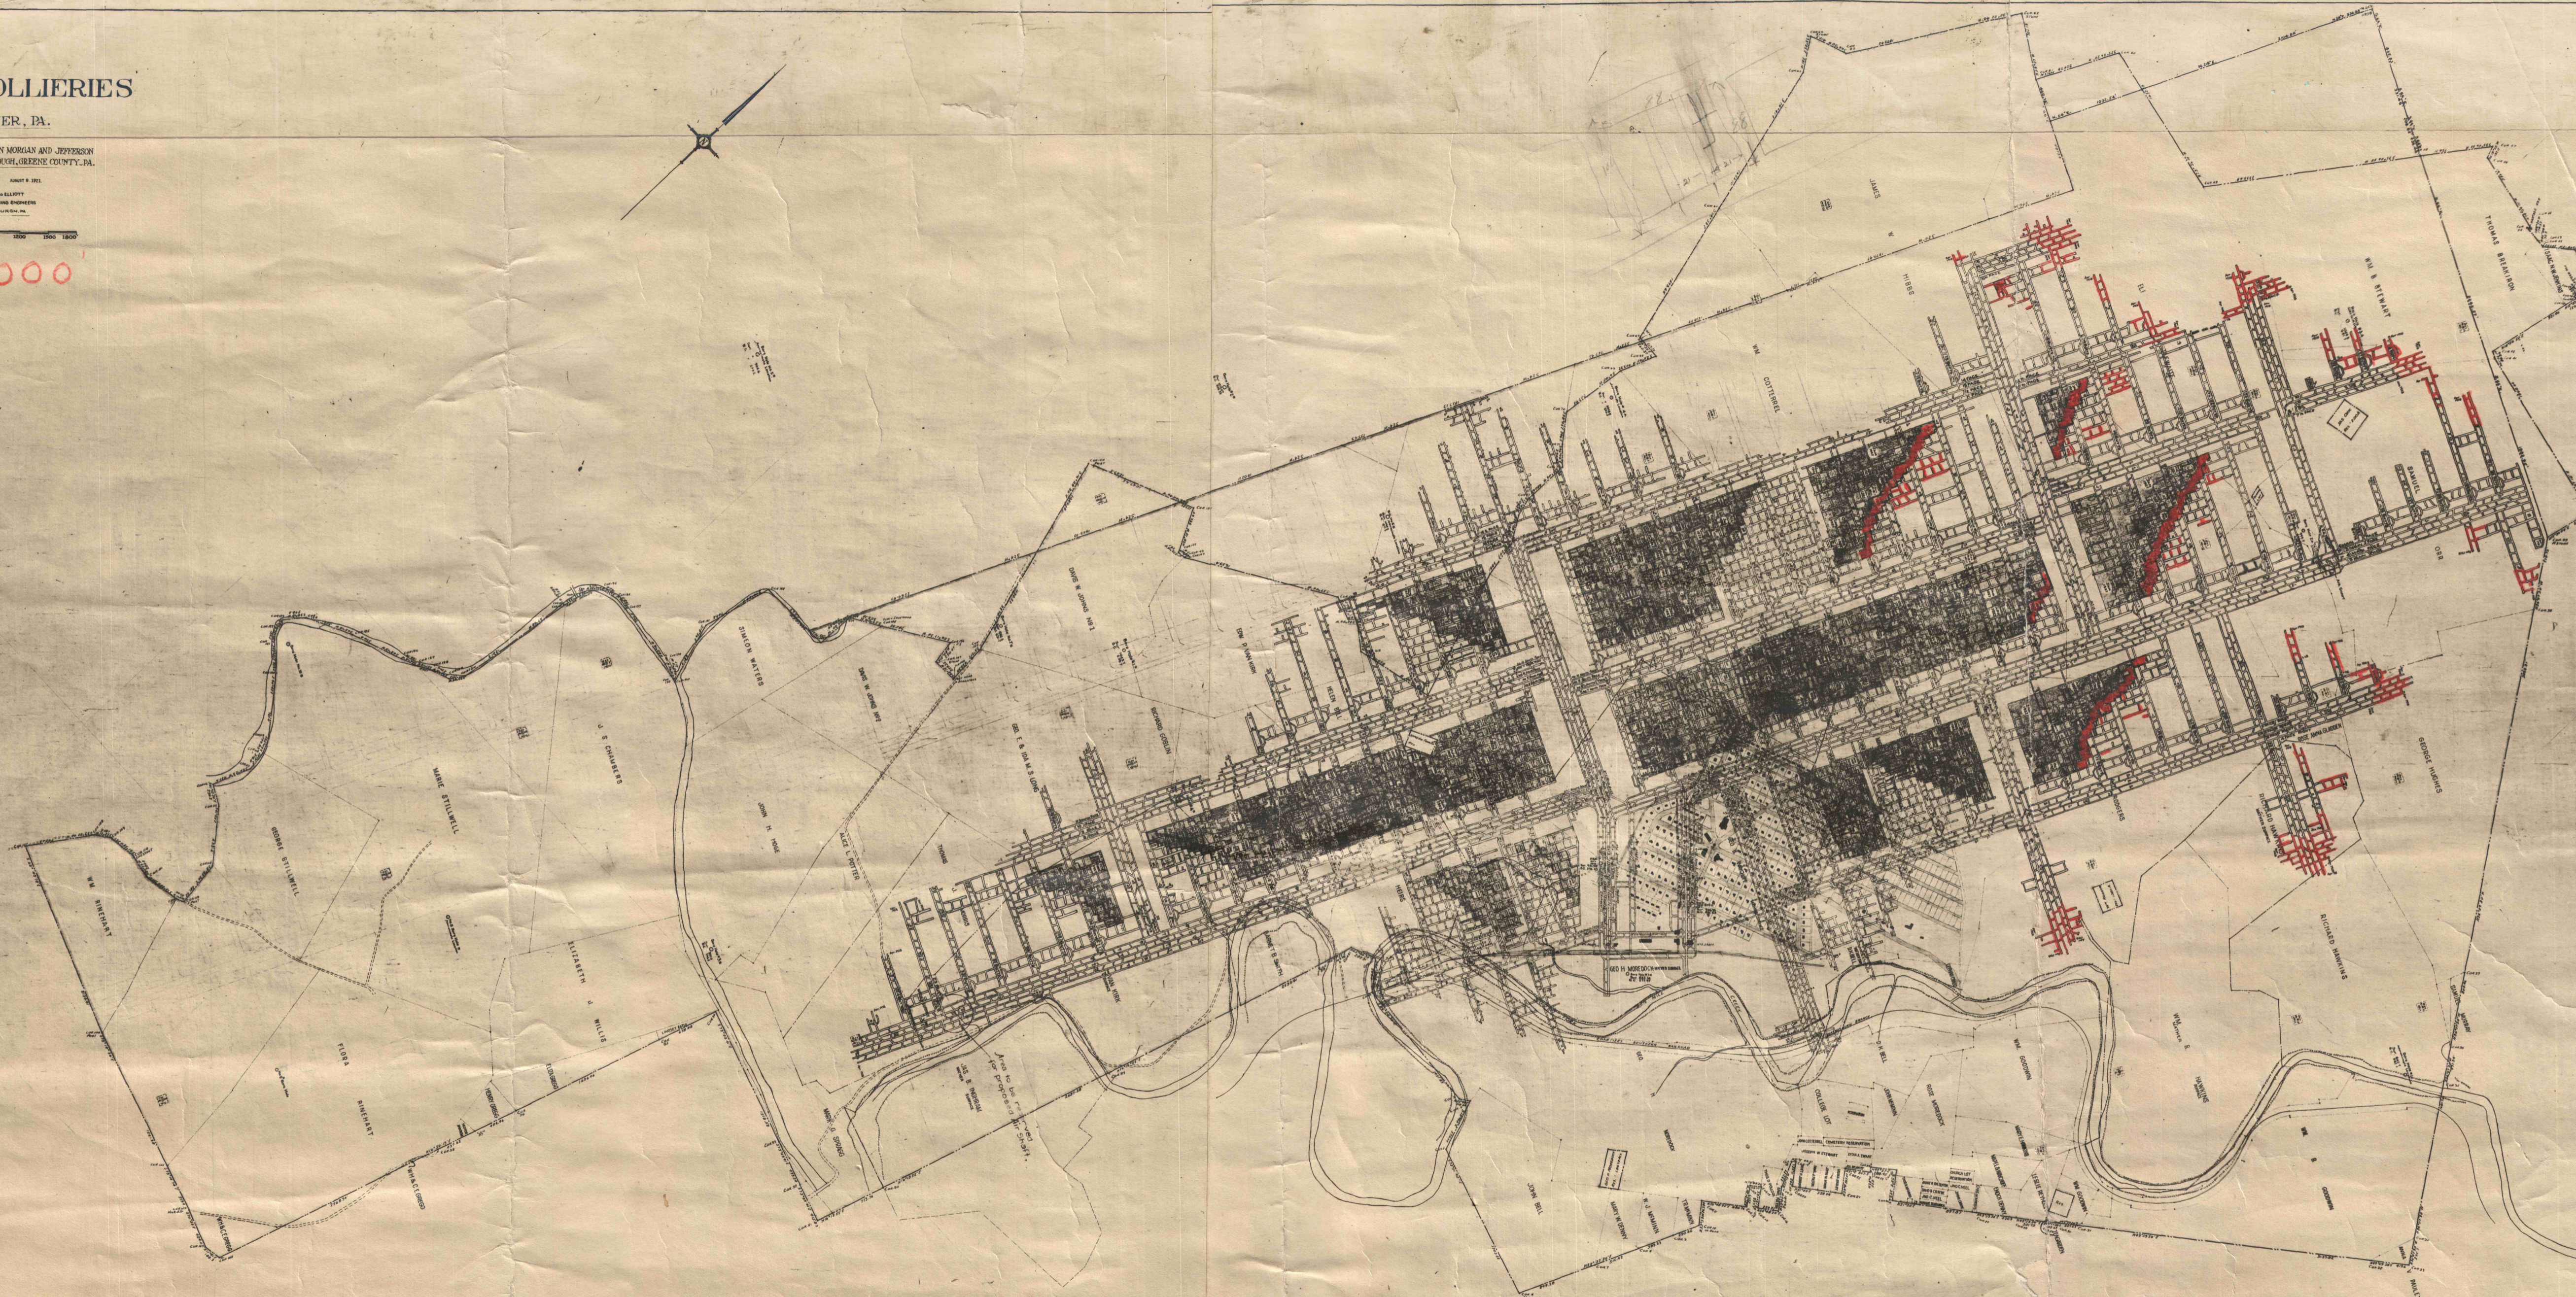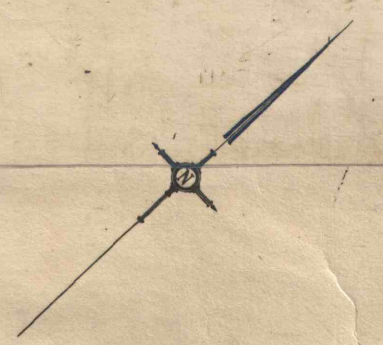

A-2052