

Section "F" New York & Cleveland Gas Coal Co's Plan of Lots, Patton Twp. Alleg. Co. Pa.

Rec. May. 5, 1876

Part I
Plan Book 6, P. 82 (out #)
See C-1471 F-16
" Sur. Trac 102

Scale 100ft. = 1 inch


Laid out Sept. 1875
B. F. Followay, M.E.

Additional pencil information from recorded plan,
plan as corrected in pencil now agrees with
plan Book 6, Part I, Page 82
Jhrw 2/15/39.

Note:
S. 18°-50'E. 176.15' and N. 65°-30'W. 188.28'
agrees with deed of N.Y. & C.G.C. Co. to Alex.
Erskine dated Sept 20, 1875 and recorded
in D. B. Vol. 763 P. 555. No course given in
deed for line between Lot #1 and Lot #2.
W. R. B. 7/14/24

Heirs of Robert Carothers

Peter Lirhart

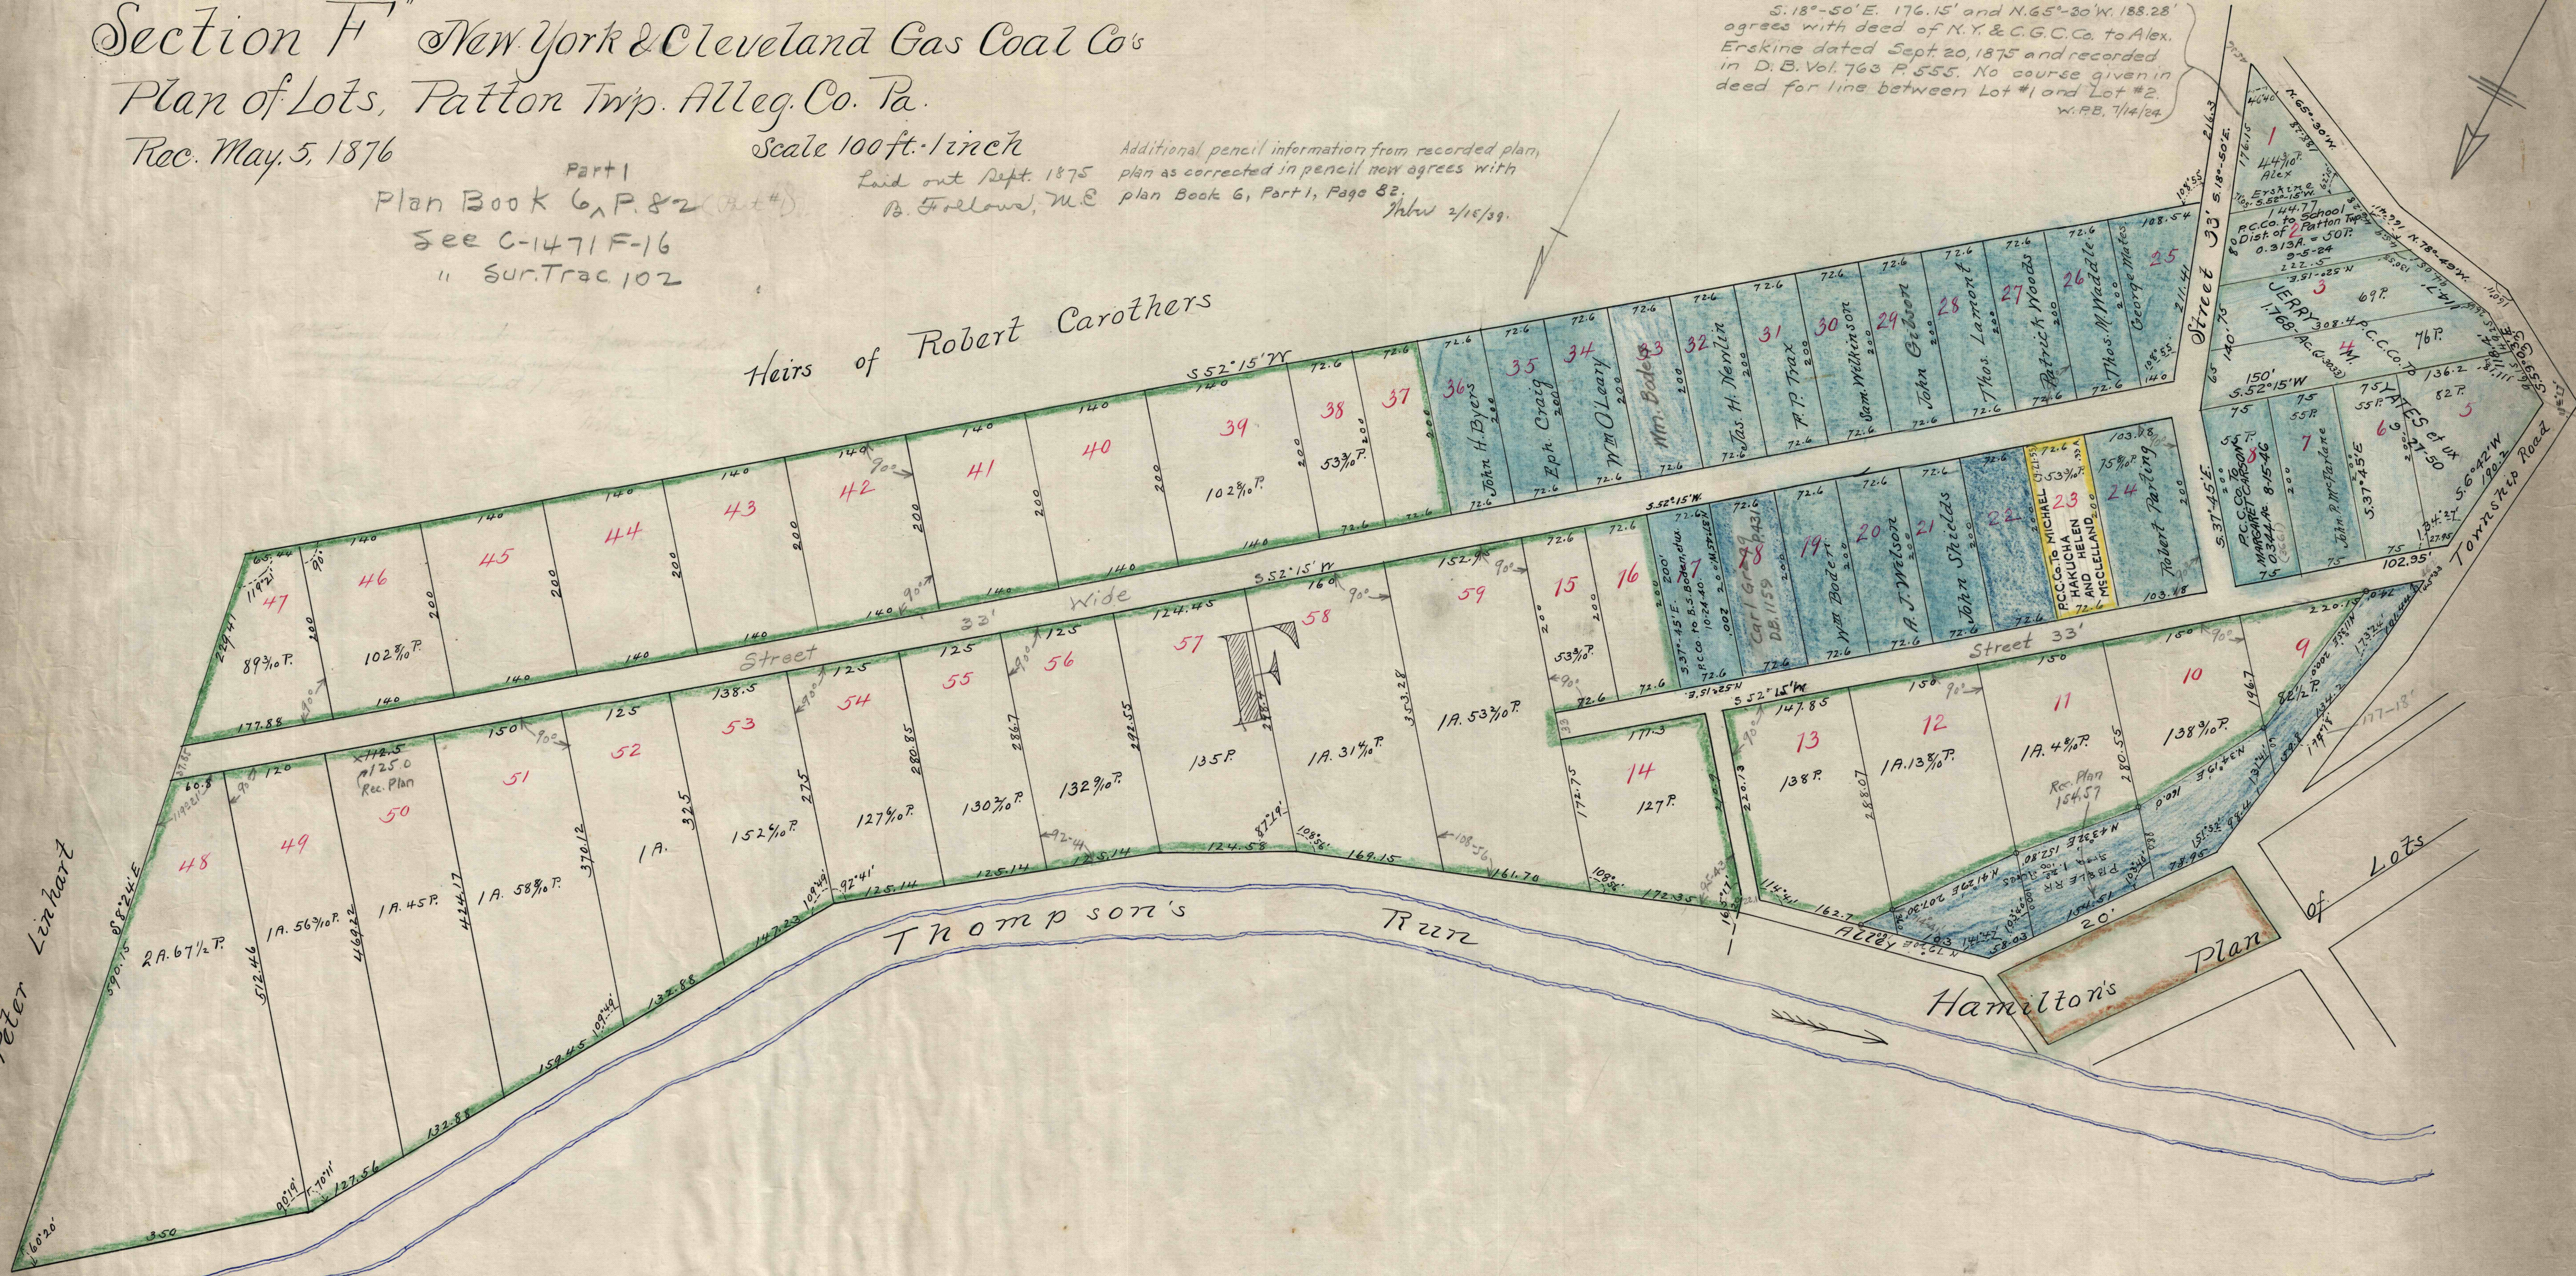

Hamilton's Plan of Lots

check this plan with recorded plan
in the book 6, p. 82

C 1874 G 18
C 1874 G 18