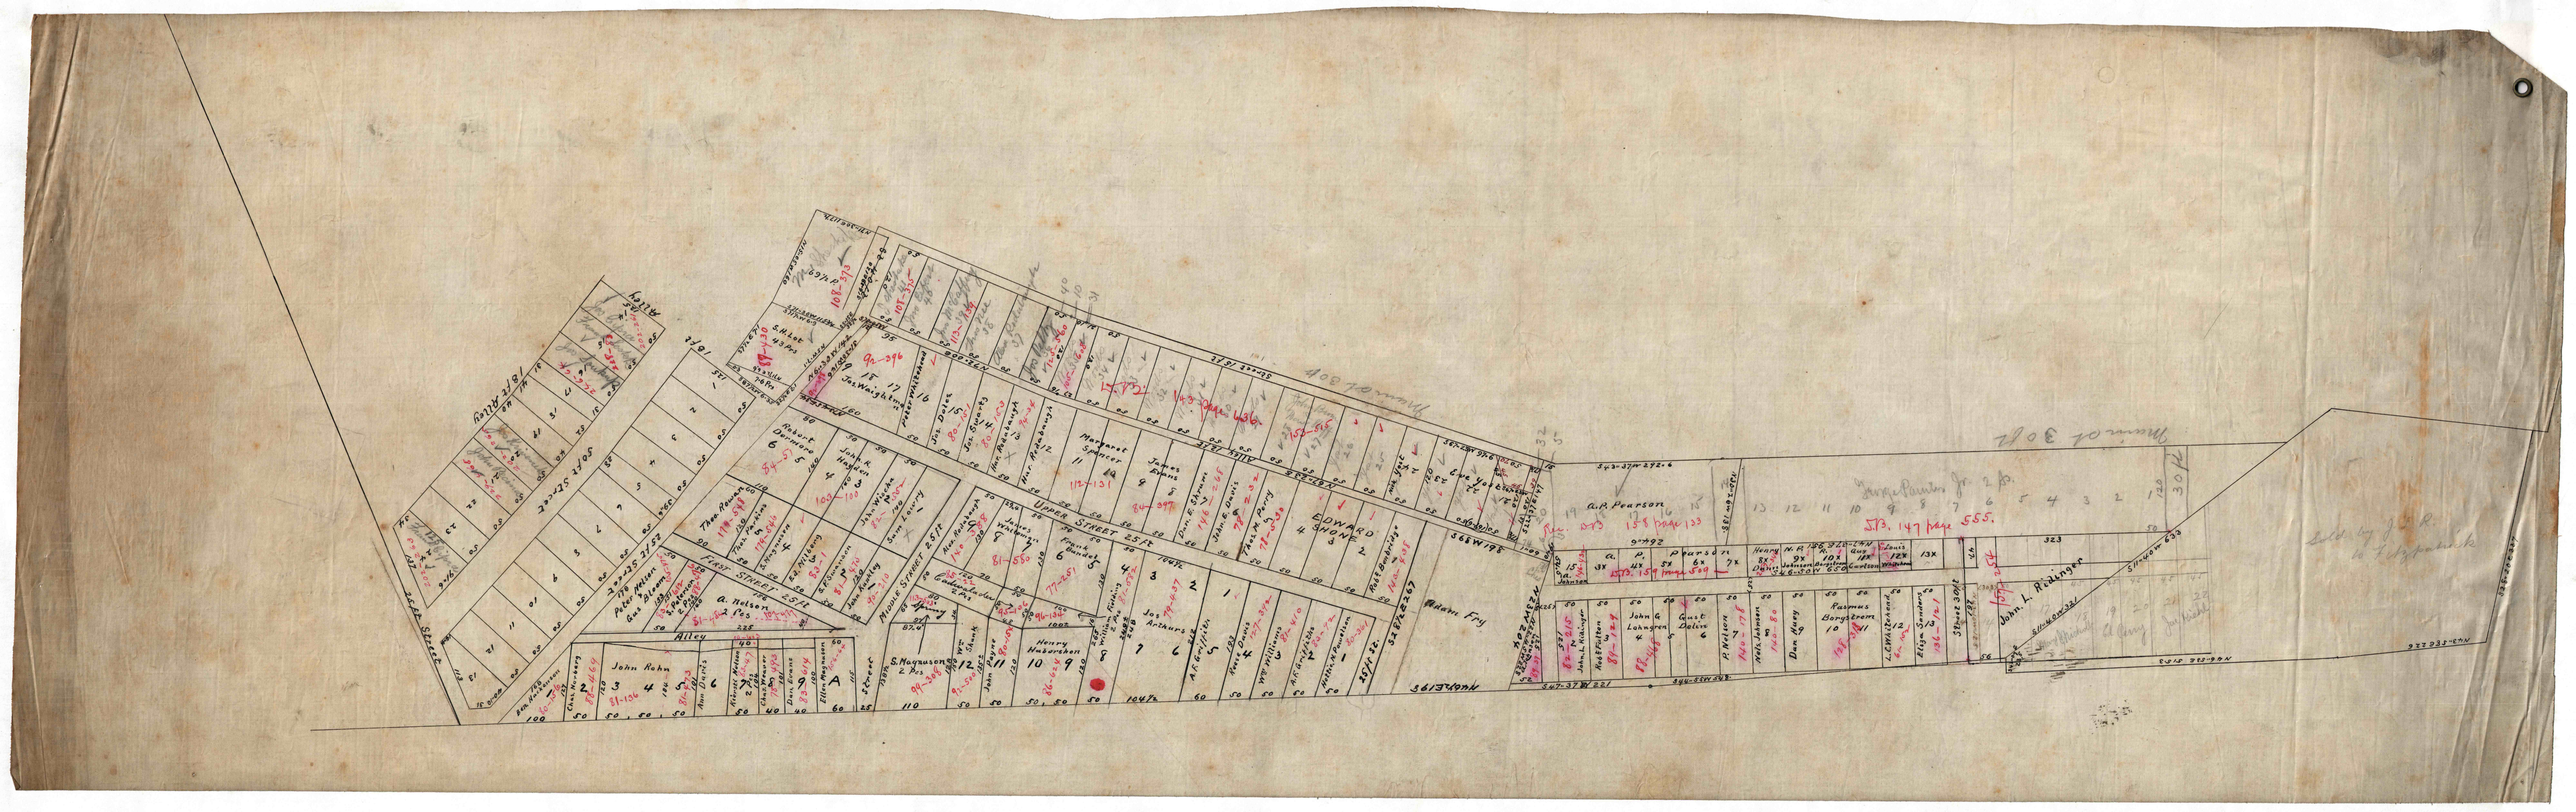
Upper Street 25 ft.
Alley
A.B. Pearson
Vol. 073 Page 133
Vol. 147 Page 555.
Henry Habersham
Thos. Rowan
Peter Nelson
Geo. Adams
John Rehn
Thos. Purse
Margaret Spencer
Jos. Bates
Jos. Stevens
Jos. Weightman
Jos. Arthurs
Wm. Williams
