


SKETCH

Showing proposed plan of lots
to be laid out at
HAHNTOWN

Scale 1"=100'

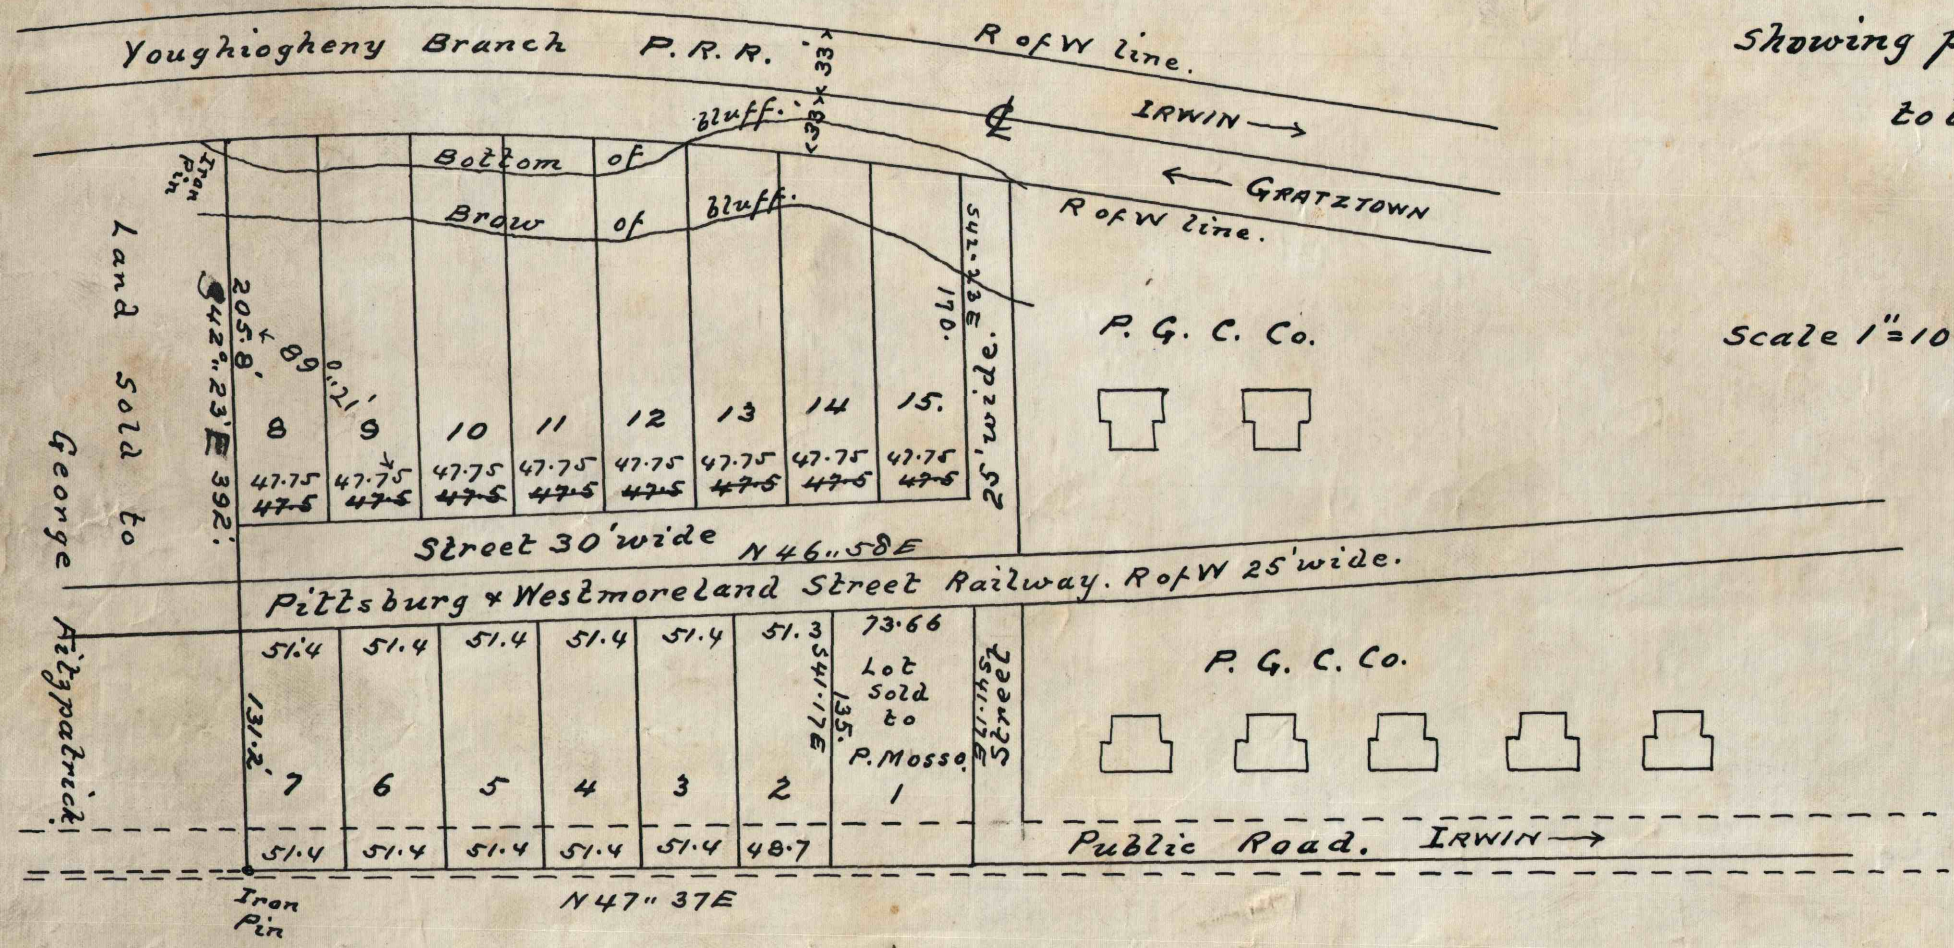

Hahntown.