


MINE N^o3.

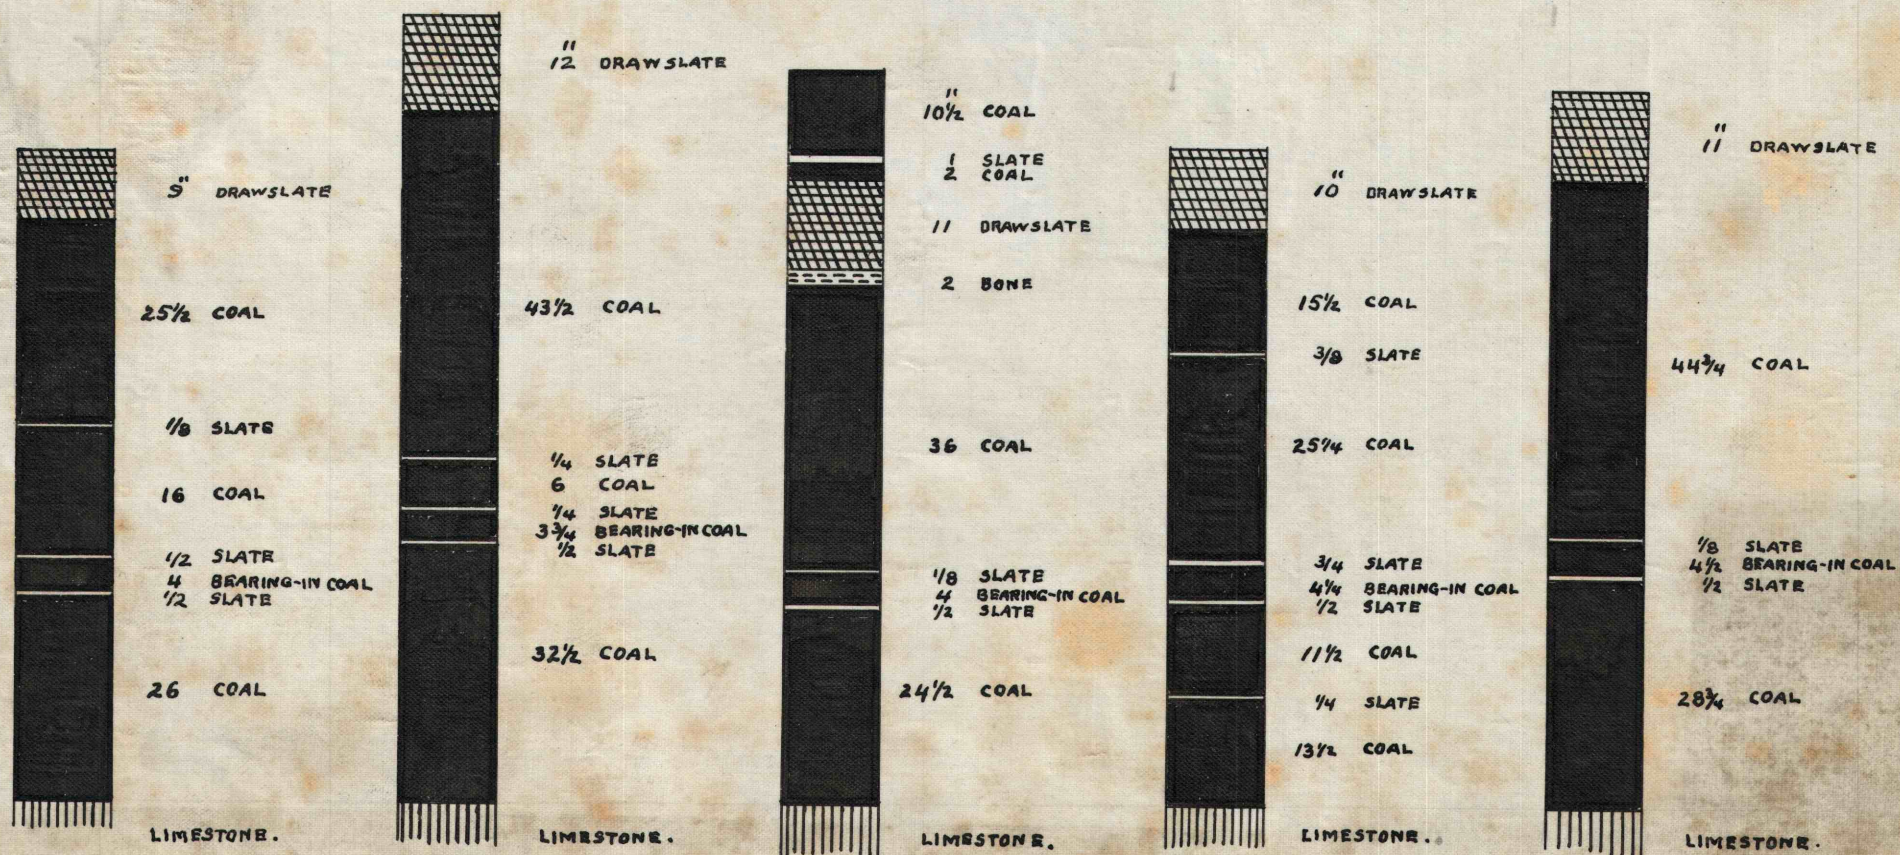

Supply Road
Entrance Junct.

N^o9 Room
East Butt

1st North Mains
N^o3 Butt.

2nd North Mains
N^o10 Butt.

N^o7 Butt
3rd North Mains.

Supply Road.

200ft up.