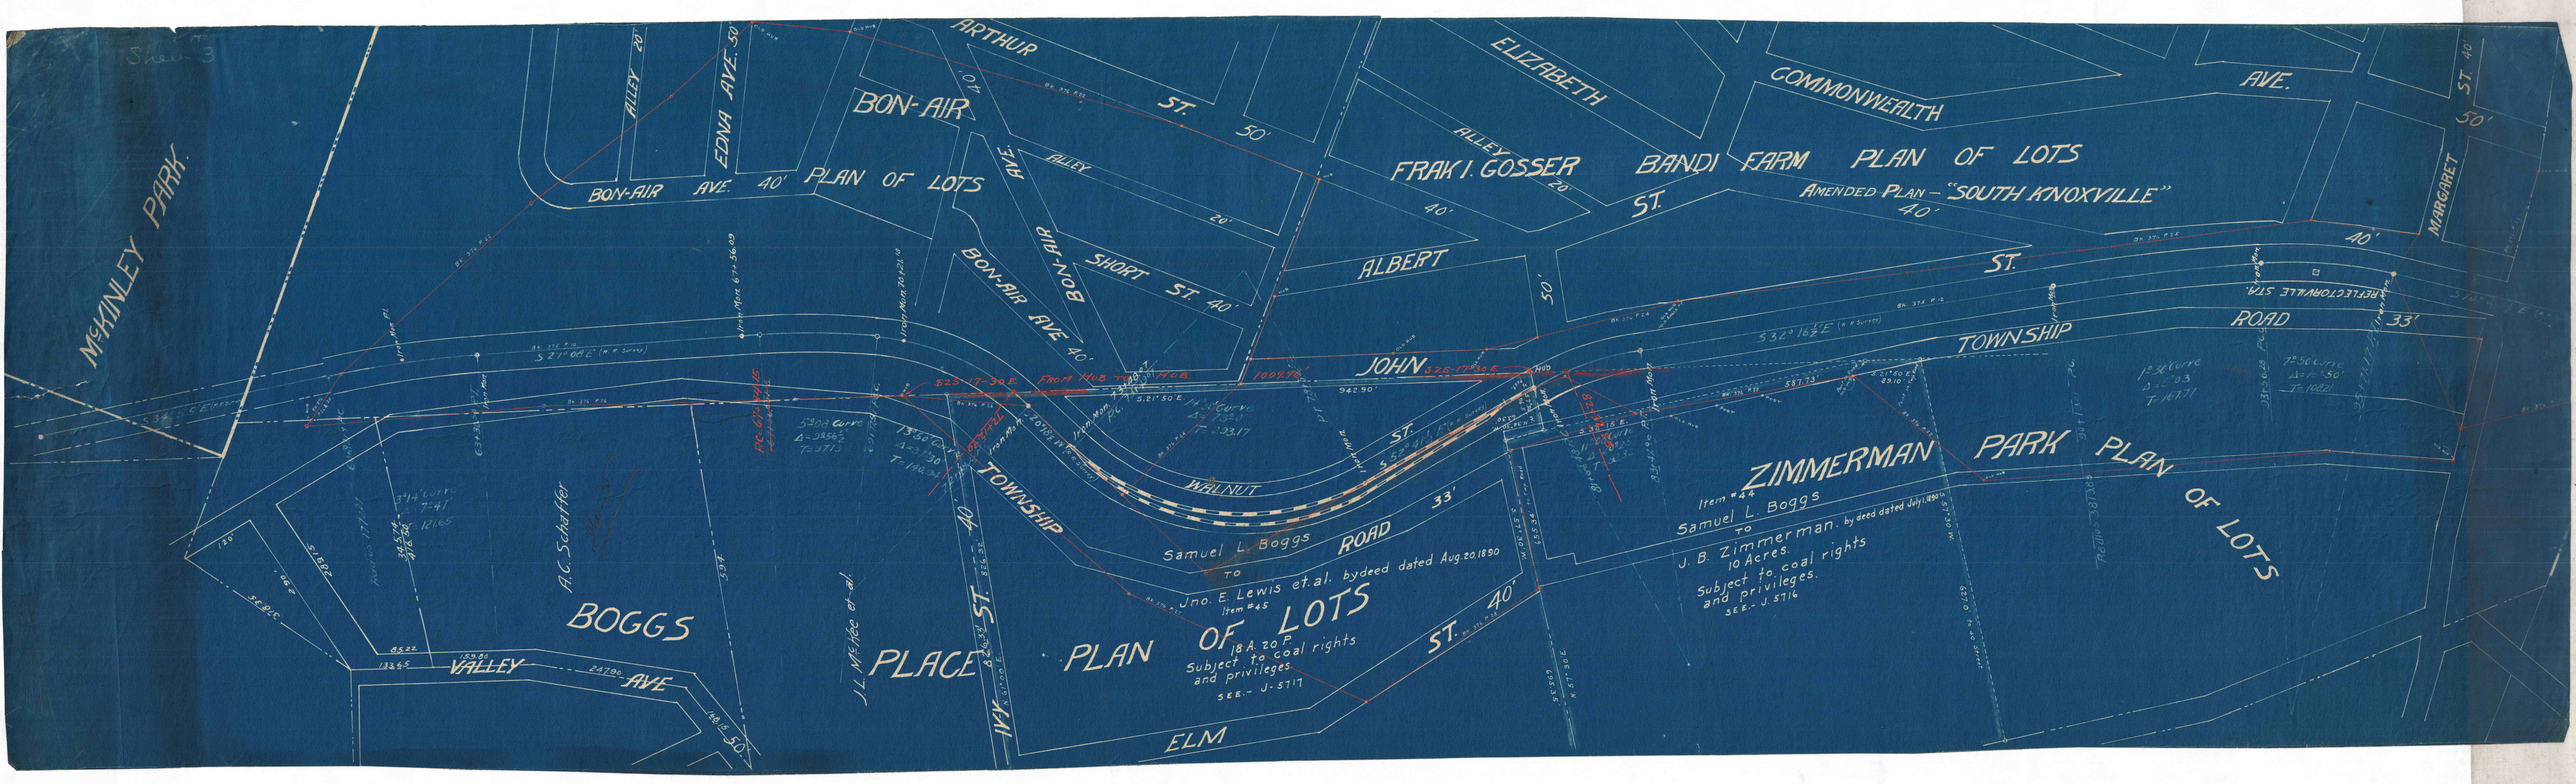
McKINLEY PARK.
ALLEY 20'
EDNA AVE. 50'
ARTHUR ST. 50'
BON-AIR
BON-AIR AVE. 40' PLAN OF LOTS
ALLEY 20'
BON-AIR AVE. 40'
BON-AIR SHORT ST. 40'
ELIZABETH
ALLEY 20'
FRAK I. GOSSER BANDI FARM PLAN OF LOTS
AMENDED PLAN - "SOUTH KNOXVILLE"
COMMONWEALTH AVE.
MARGARET ST. 40'
ALBERT ST. 40'
JOHN ST. 40'
WALNUT ST. 40'
ELM ST. 40'
REFLECTORVILLE STA.
TOWNSHIP ROAD 33'
Samuel L. Boggs TO Jno. E. Lewis et.al. bydeed dated Aug. 20. 1890 Item #45
18 A. 20 P.
Subject to coal rights and privileges.
SEE.- J-571?
ZIMMERMAN PARK PLAN OF LOTS
Item #44
Samuel L. Boggs TO J. B. Zimmerman. by deed dated July 1. 1890
10 Acres.
Subject to coal rights and privileges.
SEE.- J. 5716
A.C. Schaffer
BOGGS
J.L. McGhee et al
PLACE
PLAN OF LOTS
VALLEY AVE.
S 21° 00 E (N R Survey)
S 32° 16½ E (N R Survey)
S 21° 50 E
S 32° 17' 30 E
FROM HUB
100' TO HUB
942.90'
587.73'
S 55° 41' W (N R Survey)
S 55° 41' W
N 34° 19' W
N 55° 41' E
S 34° 19' E
N 34° 19' W
S 55° 41