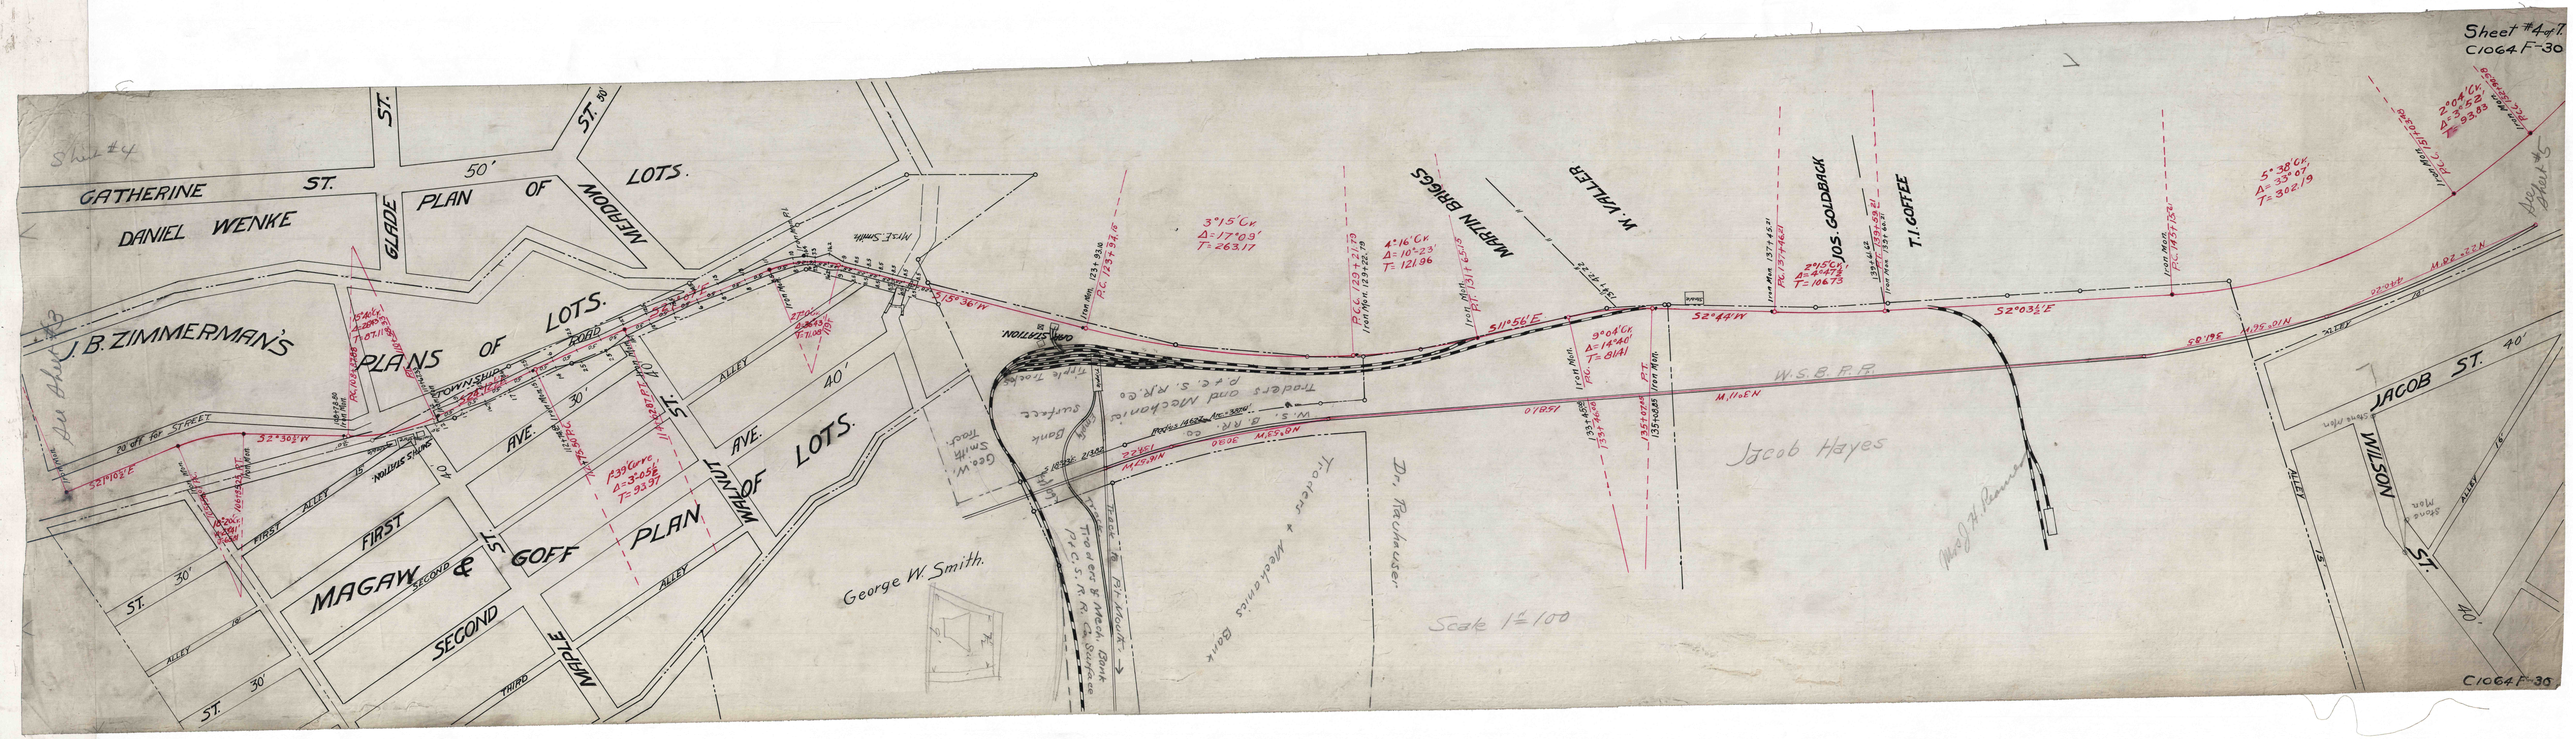
Sheet #4-17
C1064 F-30
Sheet #4
CATHERINE ST.
DANIEL WENKE
GLADE
PLAN OF
MEADOW
LOTS.
J. B. ZIMMERMAN'S
PLANS OF LOTS.
TOWNSHIP ROAD
ALLEY
40'
30
FIRST
MAGAW
SECOND
&
GOFF
PLAN
MAPLE ST.
THIRD
MAPLE ST.
LOTS.
George W. Smith.
Dr. Rachmuser
Jacob Hayes
W. VALLER
MARTIN BRIGGS
JOS. GOLDBACK
T. I. GOFFEE
W.S.B.R.R.
Scale 1"=100
JACOB ST. 40'
WILSON ST.
Stone Mon.
Sheet #5
C1064 F-30