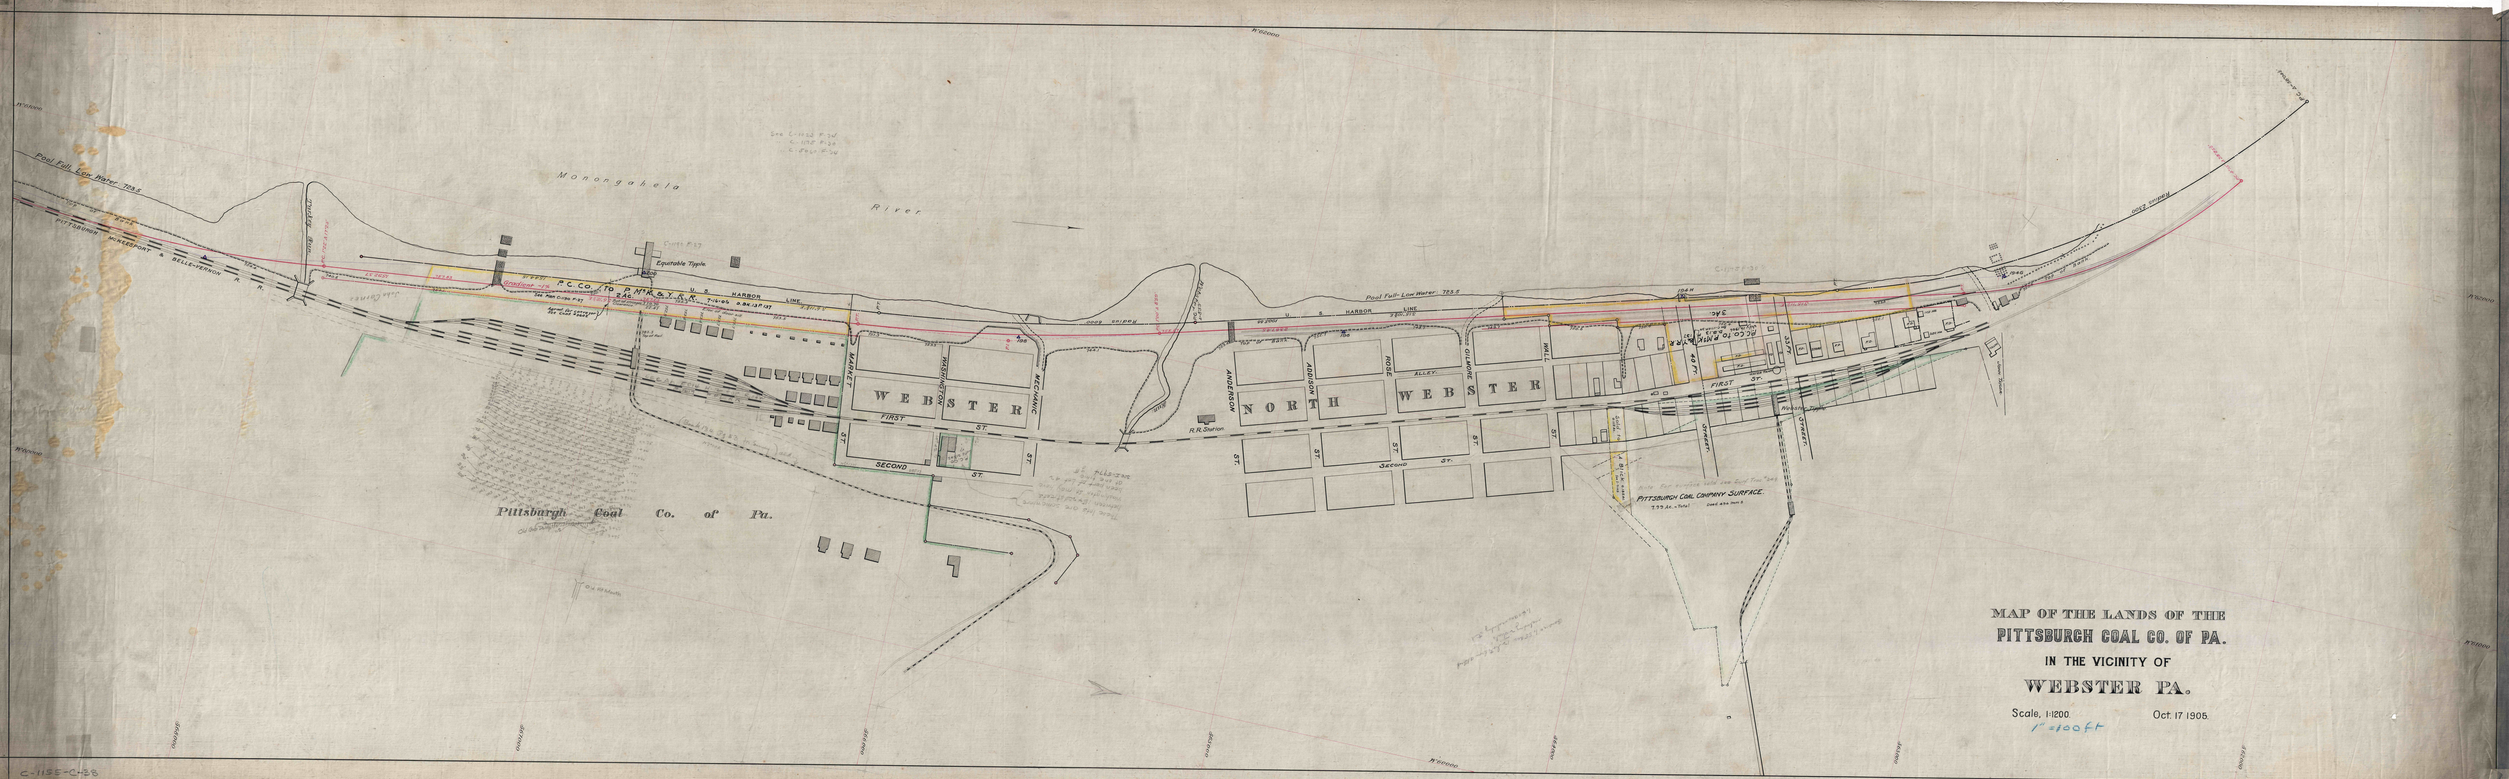

MAP OF THE LANDS OF THE PITTSBURGH COAL CO. OF PA. IN THE VICINITY OF WEBSTER PA.

Scale, 1:1200. 1" = 100 ft

Oct. 17 1905.

C-1155-C-138