



D. D. H. No 119
H.C. SHAFFER TR

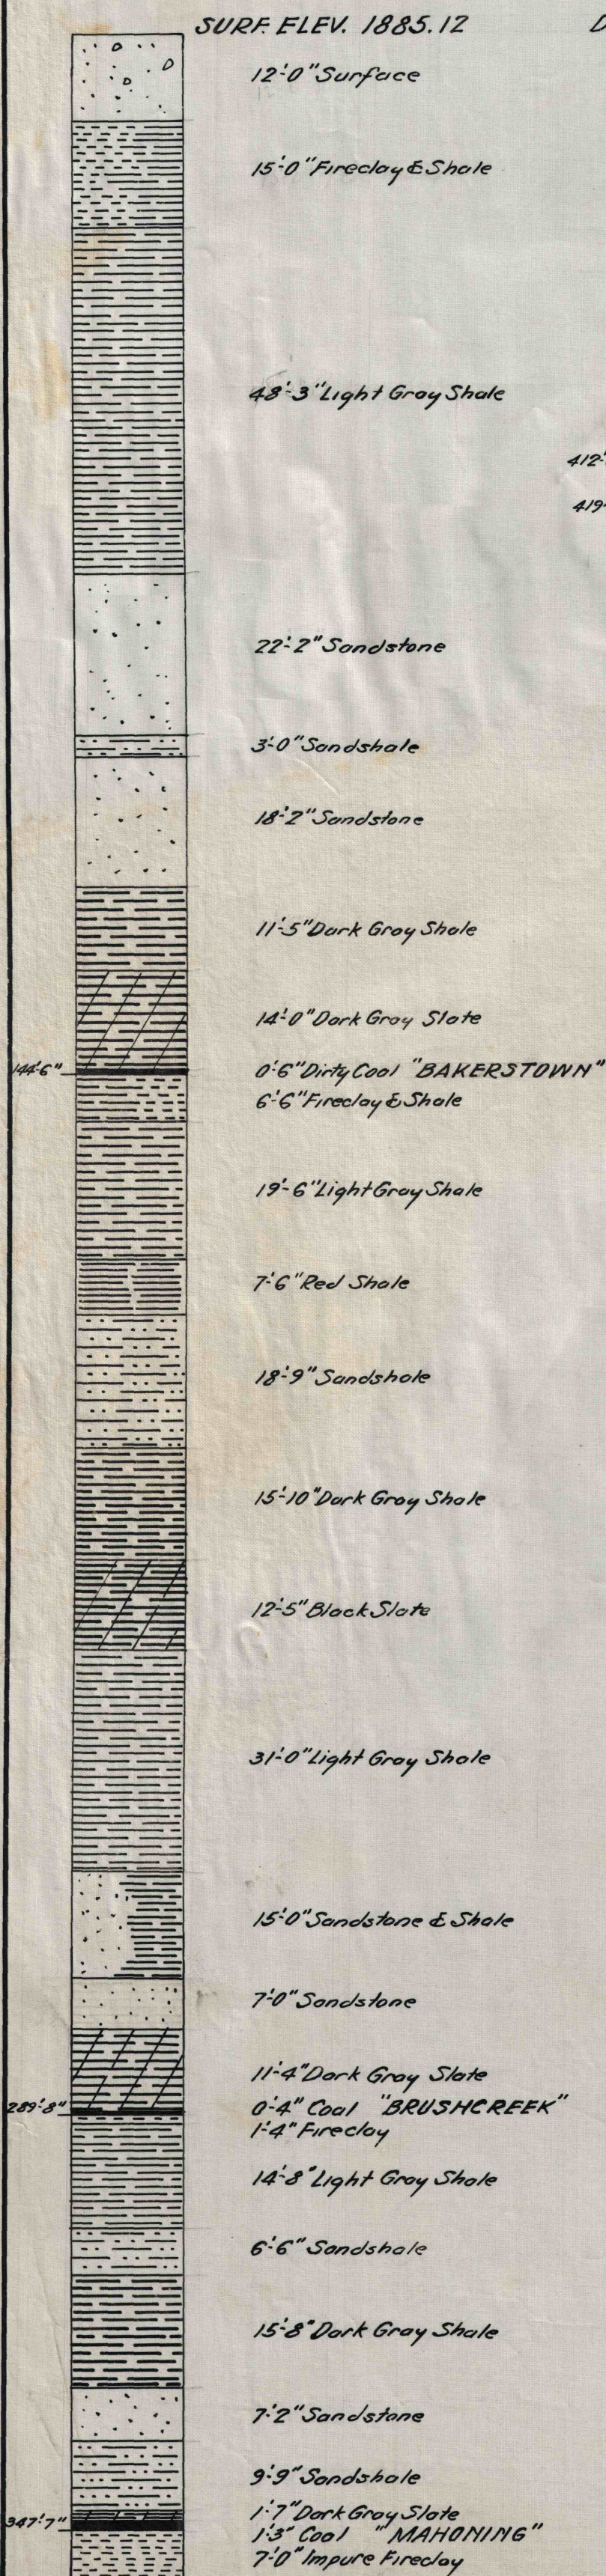

D. D. H. No 120
H.C. SHAFFER TR

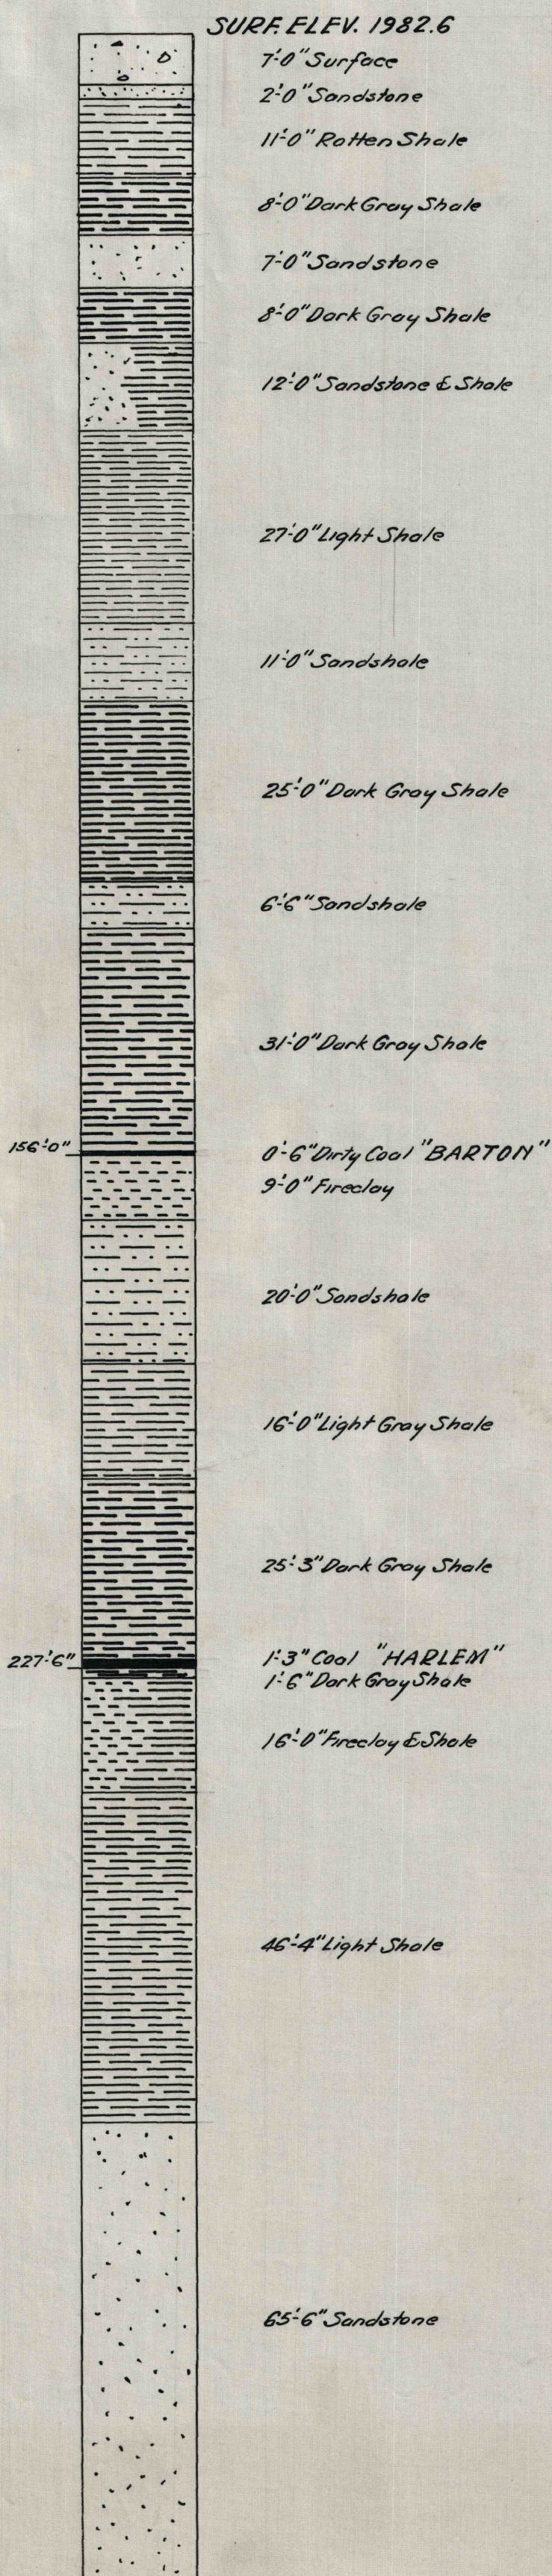

D. D. H. No 121
M.A. PICKWORTH TR.

