




D.D. HOLE No 60  
MARY MILLER SURF.  
J. A. AIRSMAN - MIN.  
+1876.4

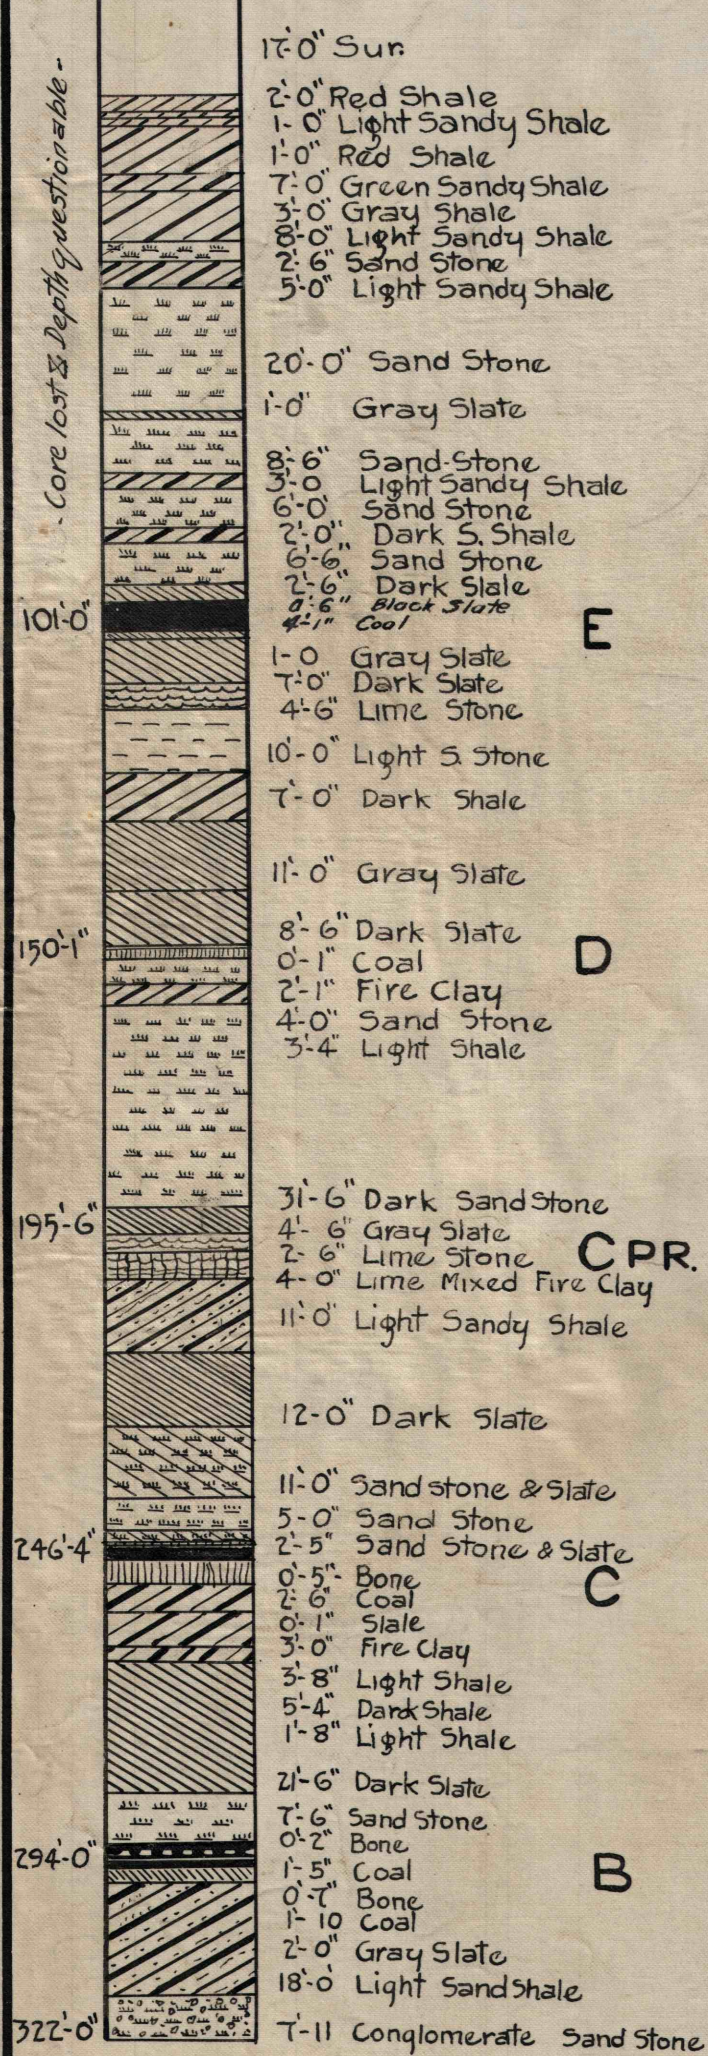


D.D. HOLE No 61  
CHAS BELL SUR.  
J. M. SHAFFER MIN  
+1958.6

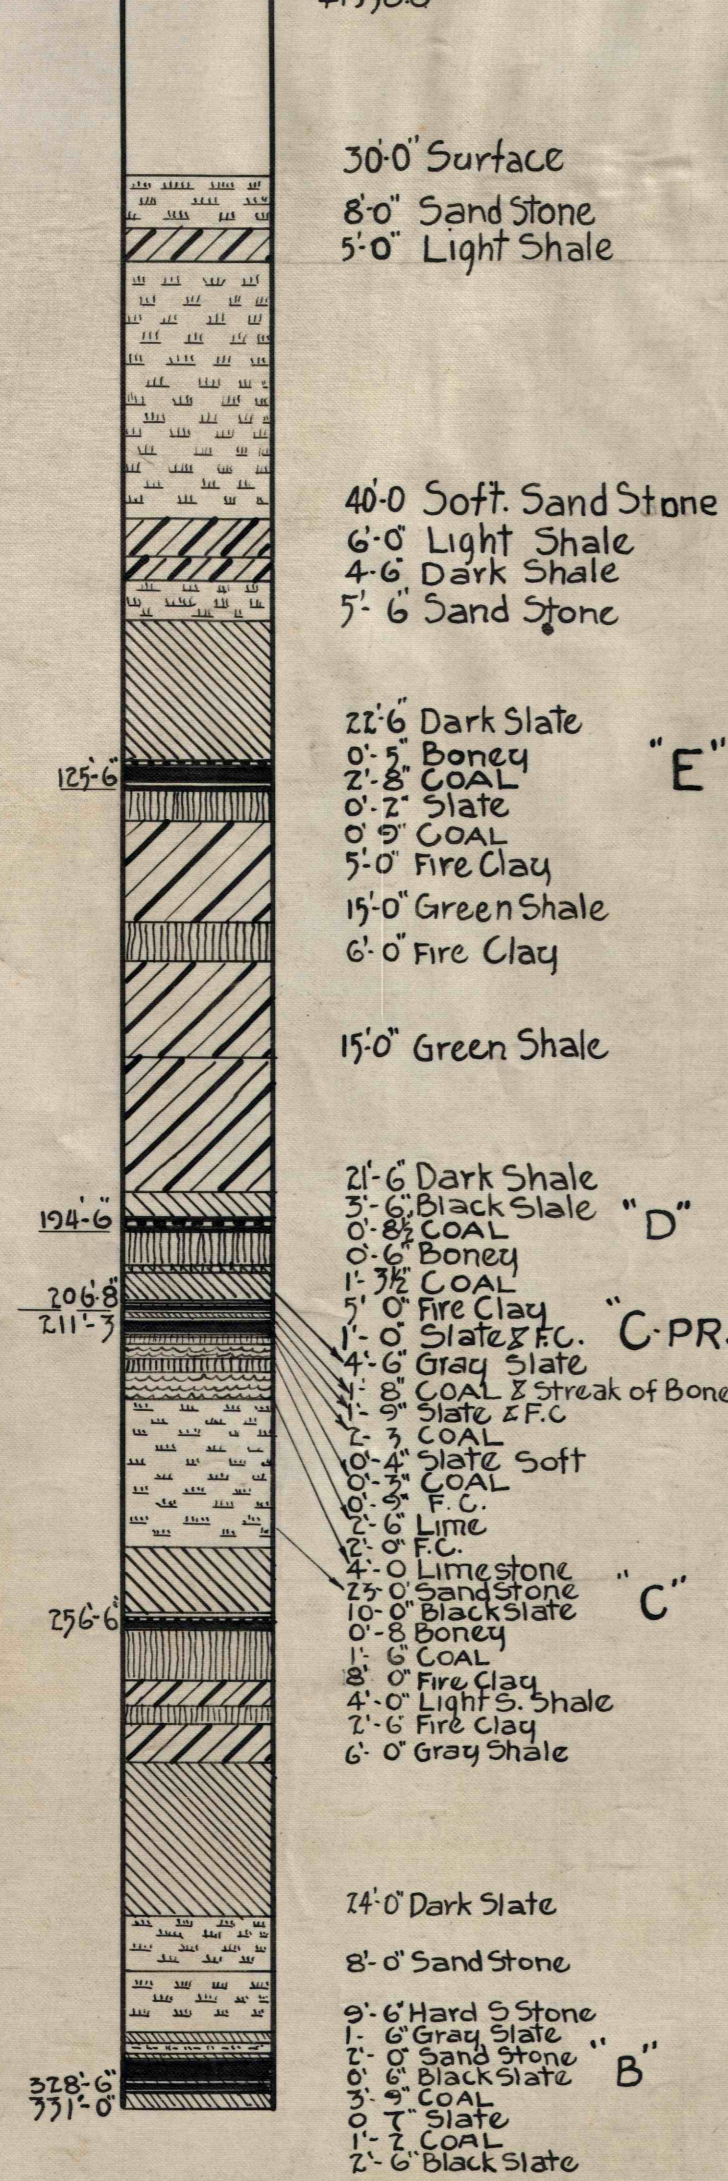


D.D. HOLE No. 62  
ISIAH BELL. SUR. & MIN.

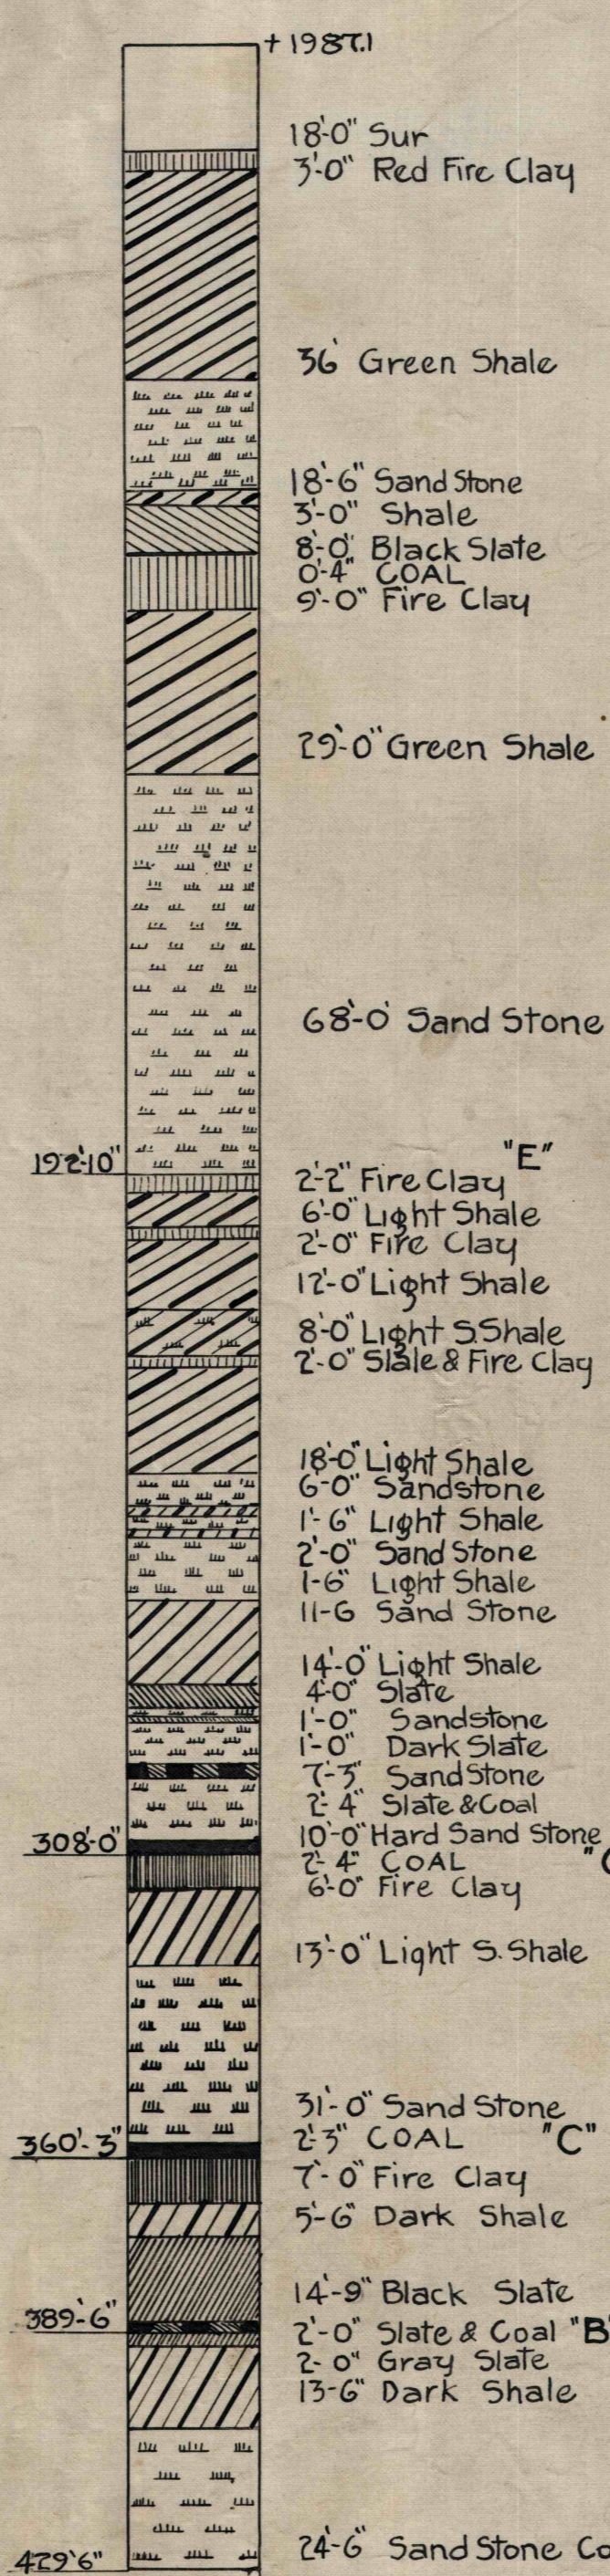

D.D. HOLE No 63  
ED & NOAH HORNER Min.  
WESLEY HORNER SUR.  
+2062.1

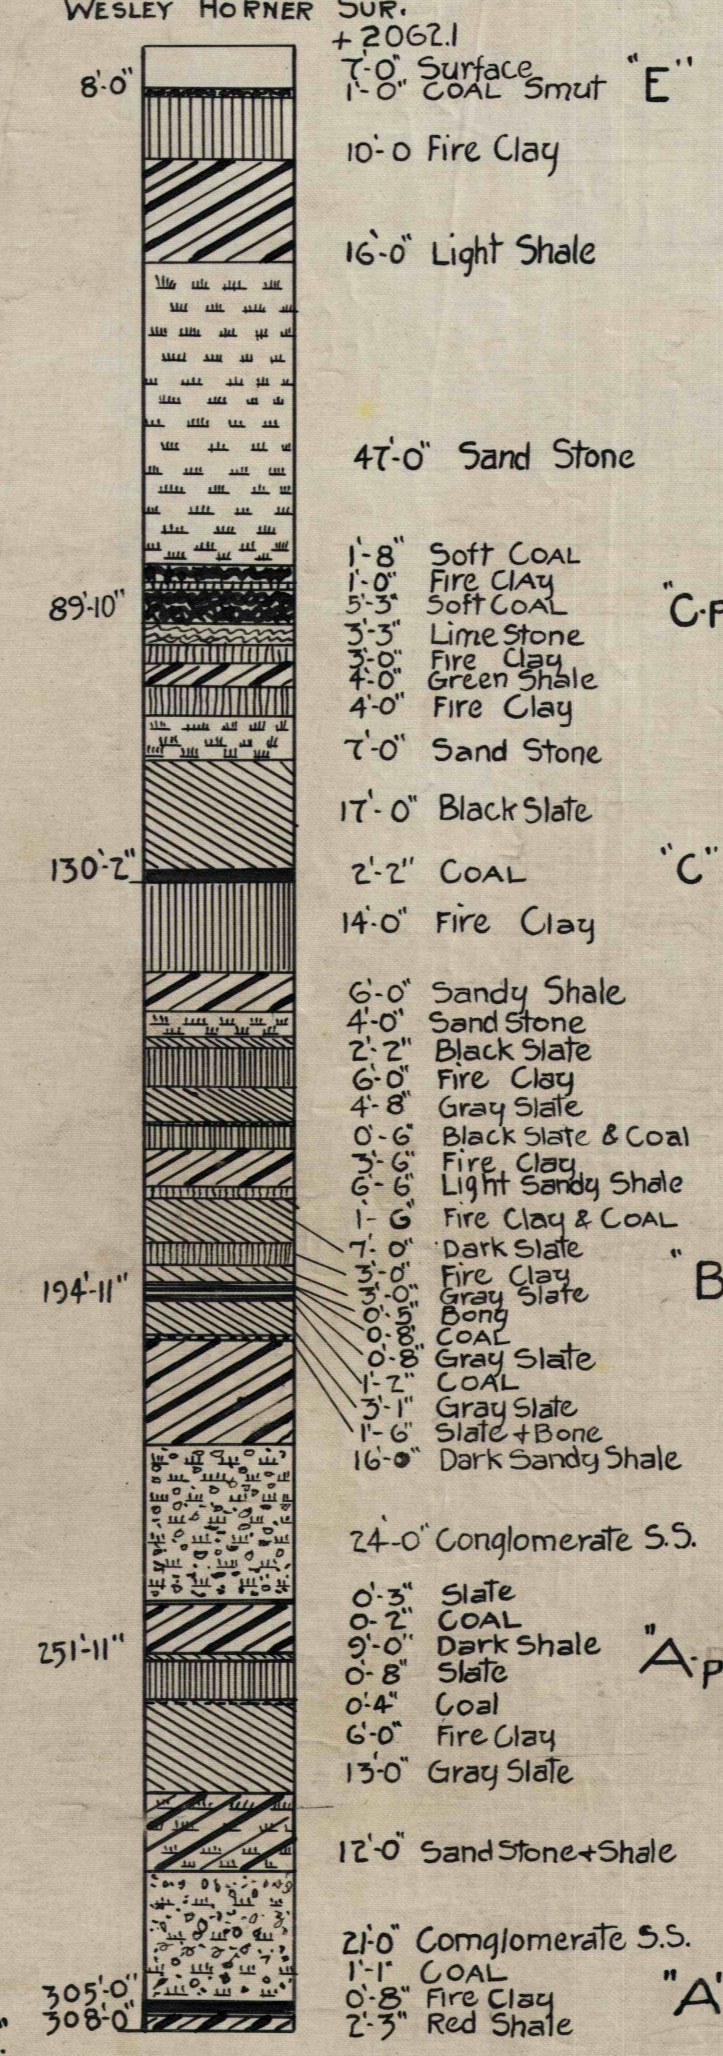

D. D. HOLE No 64  
CHAS BELL SUR.  
J. M. SHAFFER MIN.  
+1940.14

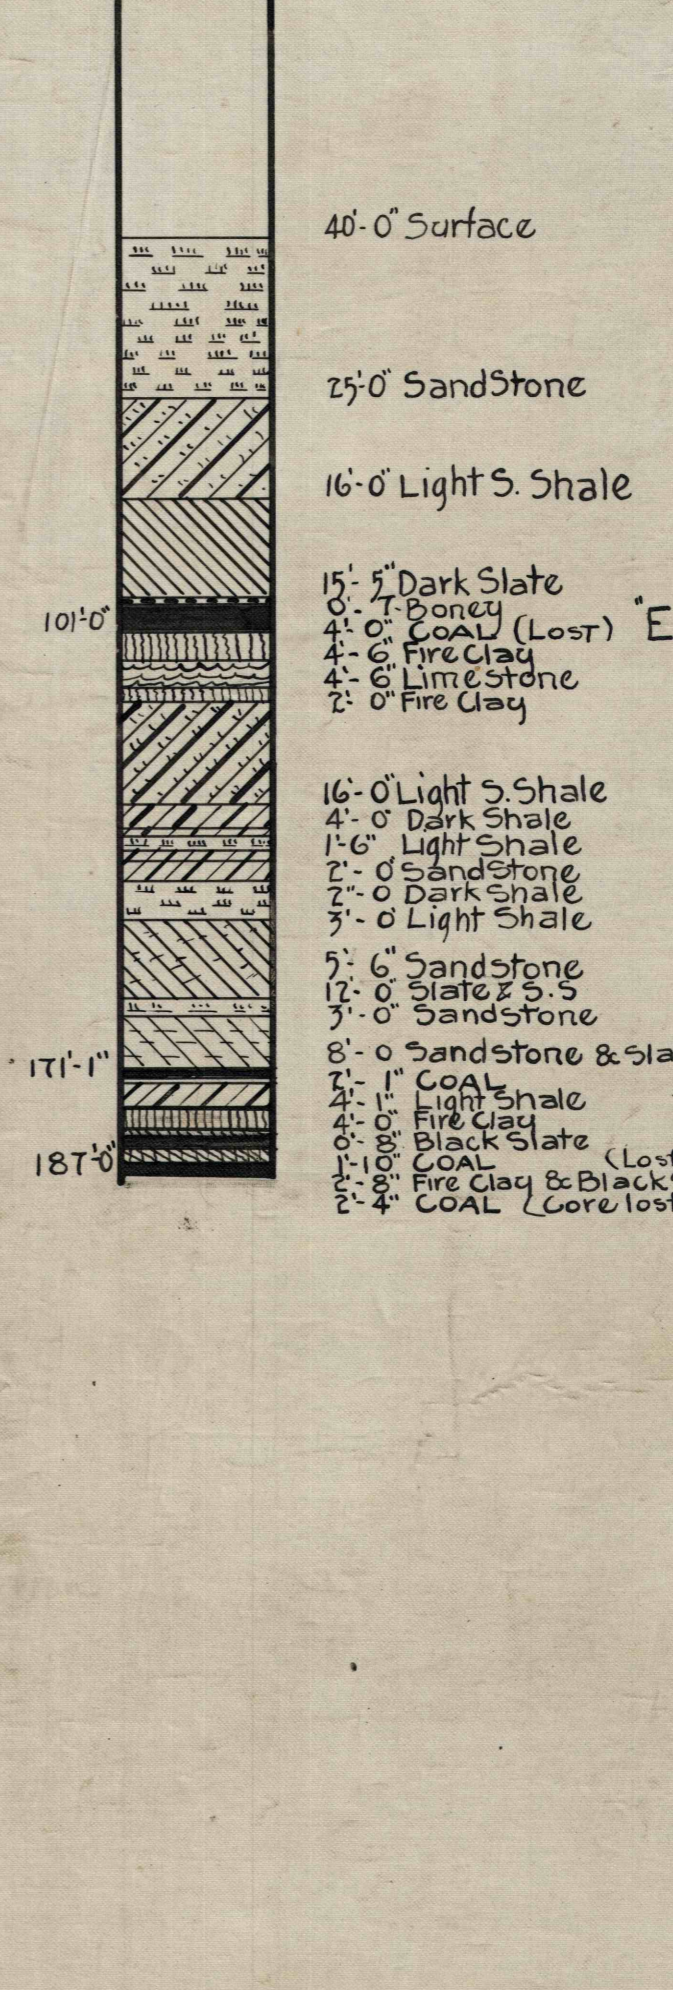

D. D. HOLE No 65  
MARY MILLER SUR.  
J. A. AIRSMAN Min.  
+1927.10

