




D. D. H. No 91
JOHN BIESECKER TRACT
+ 1853.47

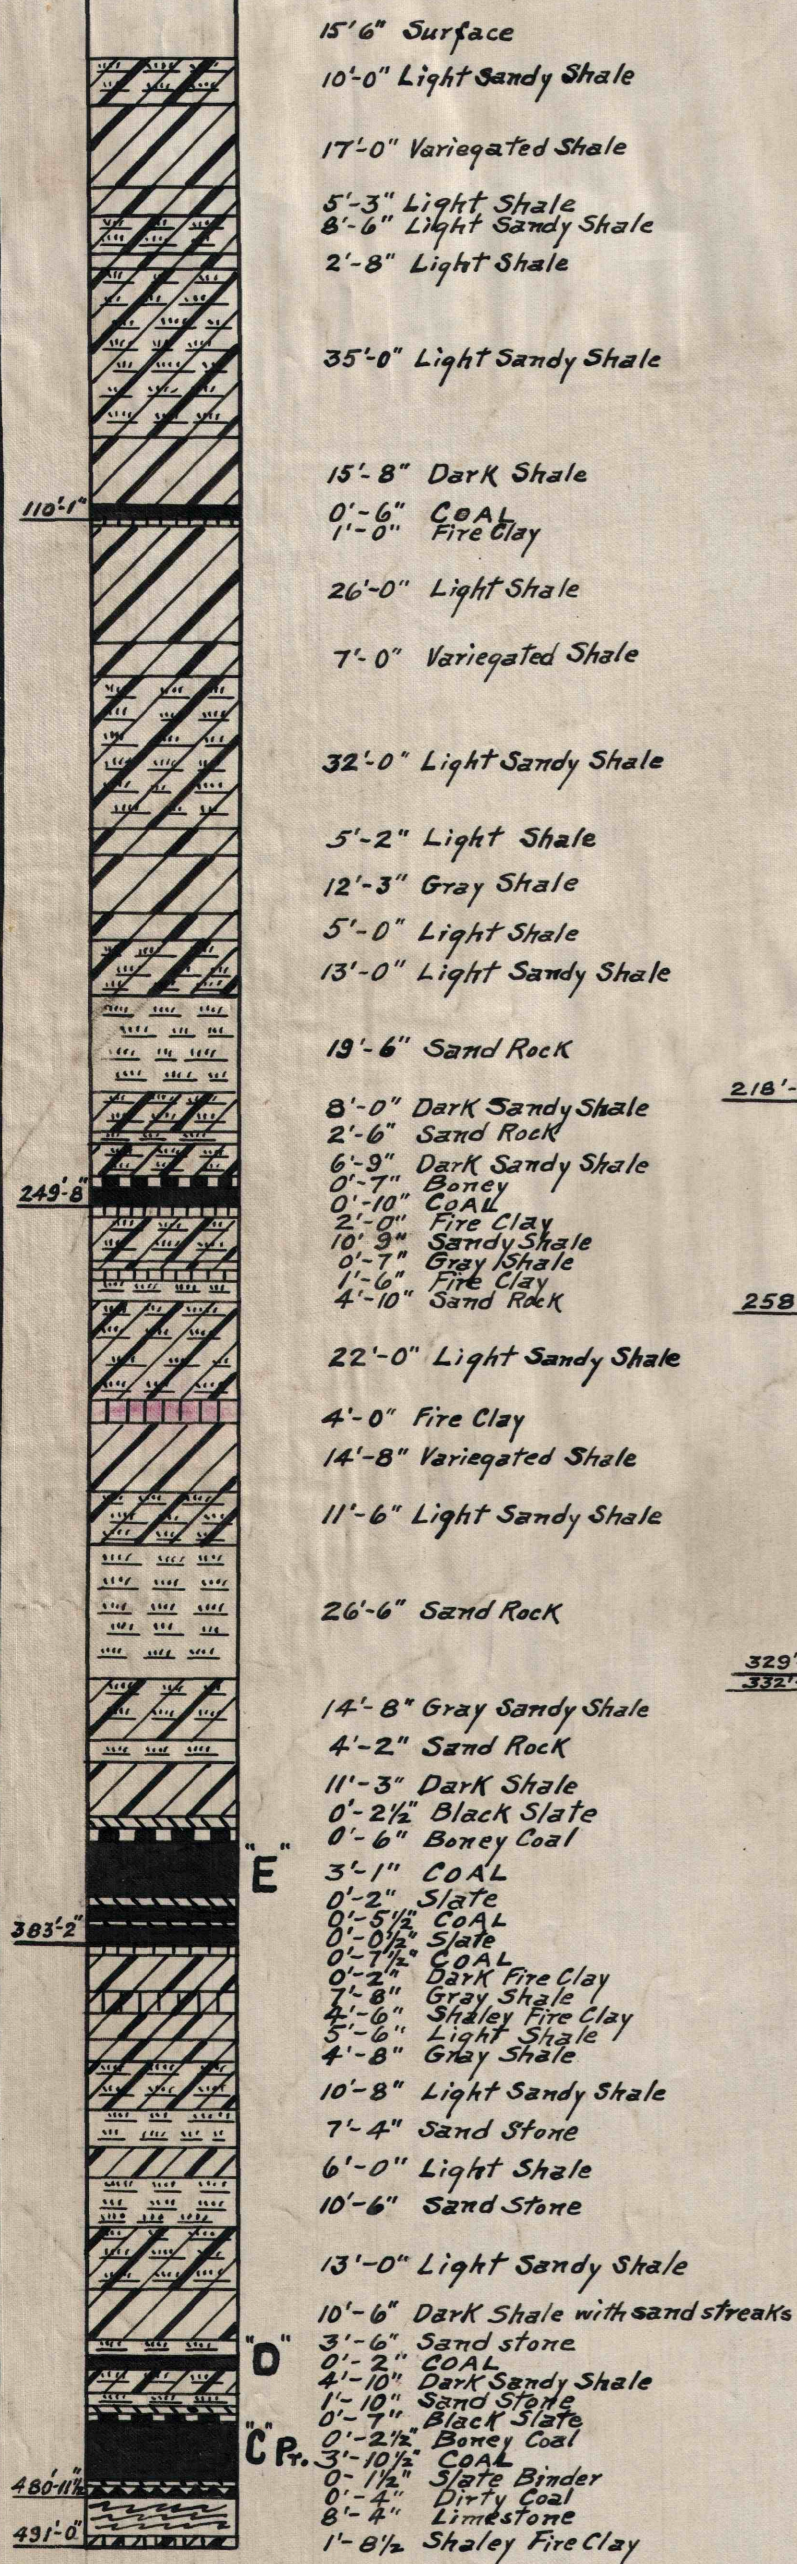


D. D. H. No 92
J. J. AIRSMAN TRACT
+ 1978.71

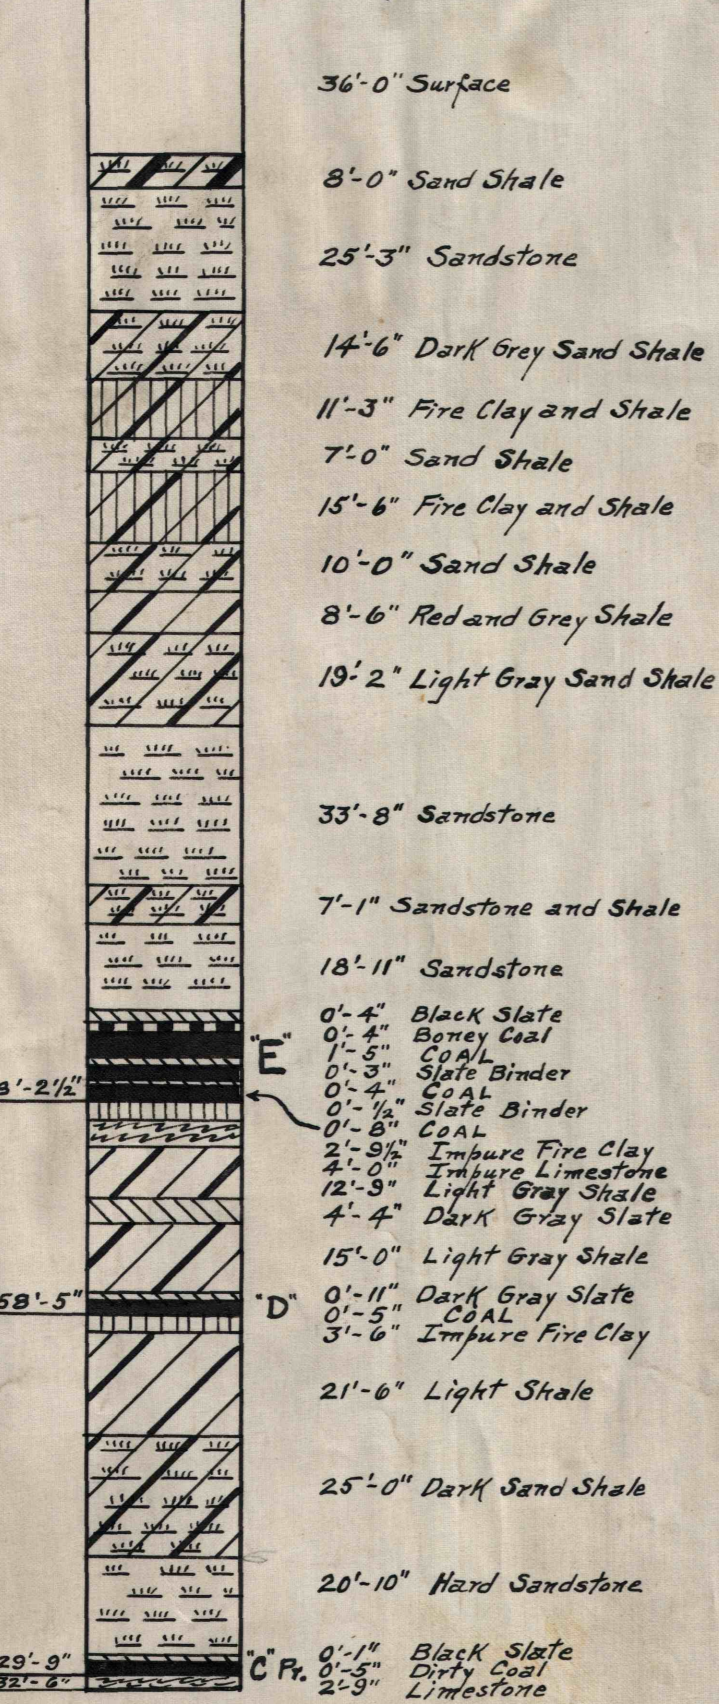


D. D. H. No 93
J. J. AIRSMAN TRACT
+ 2051.37

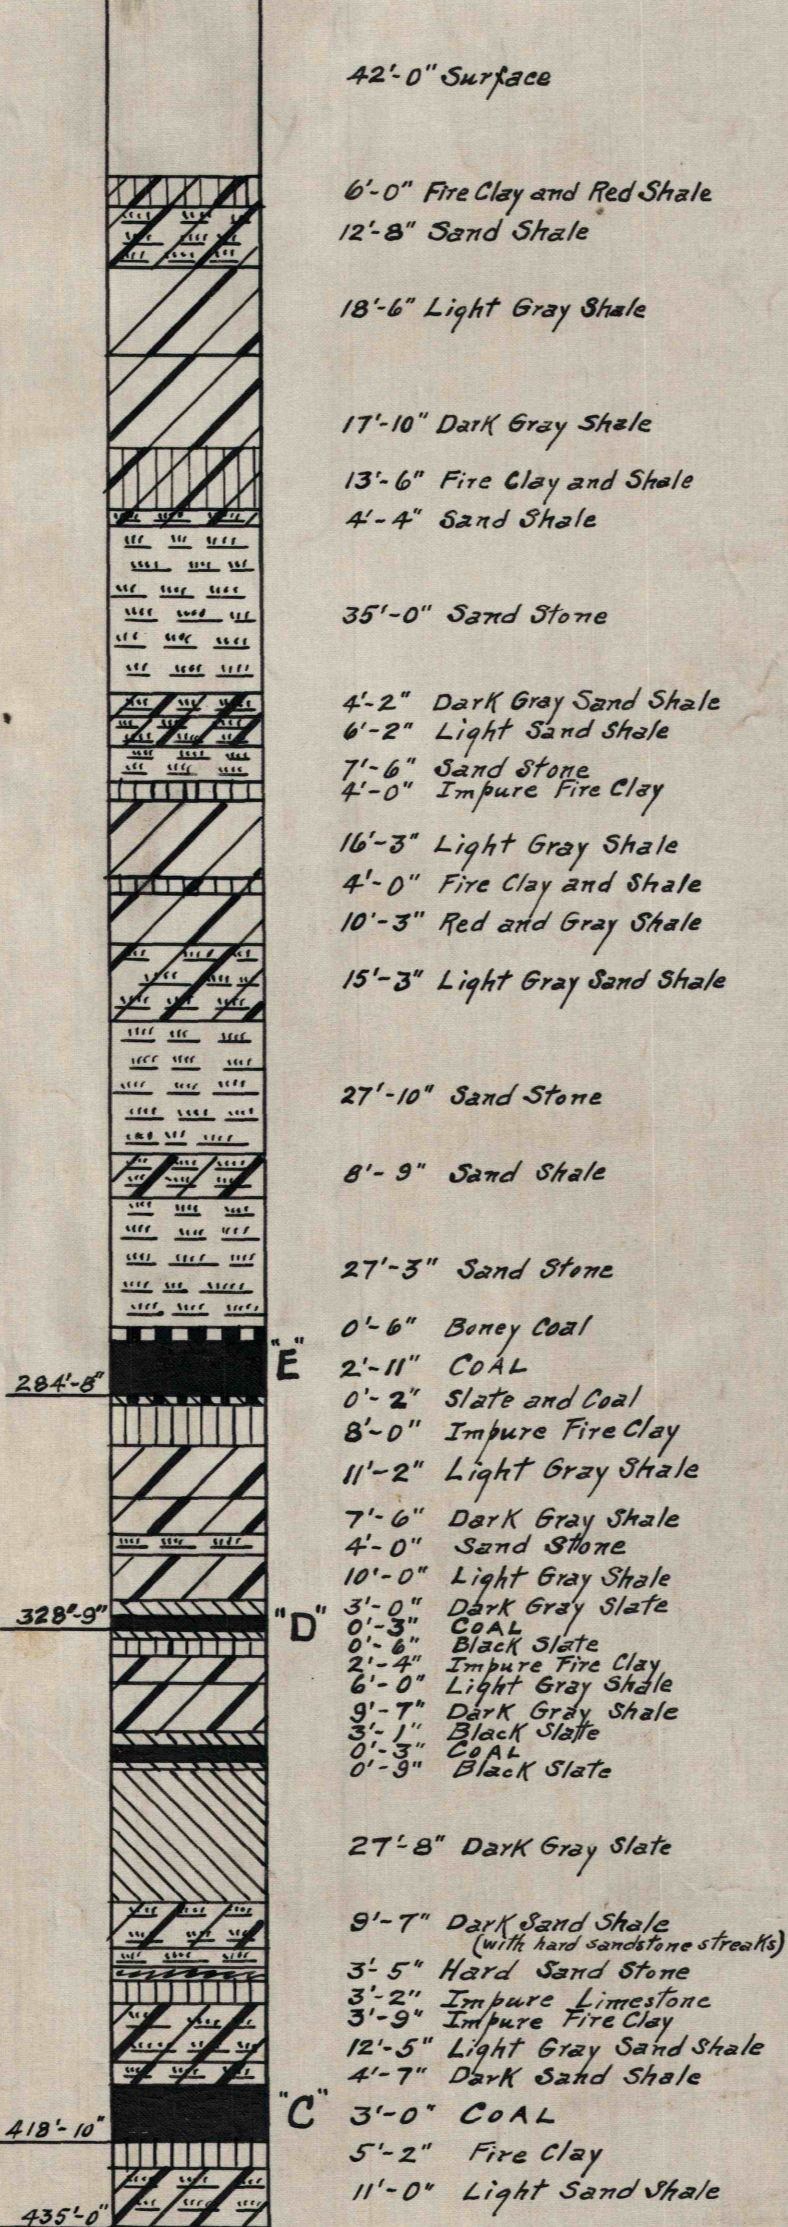


D. D. H. No 94
J. AIRSMAN TR

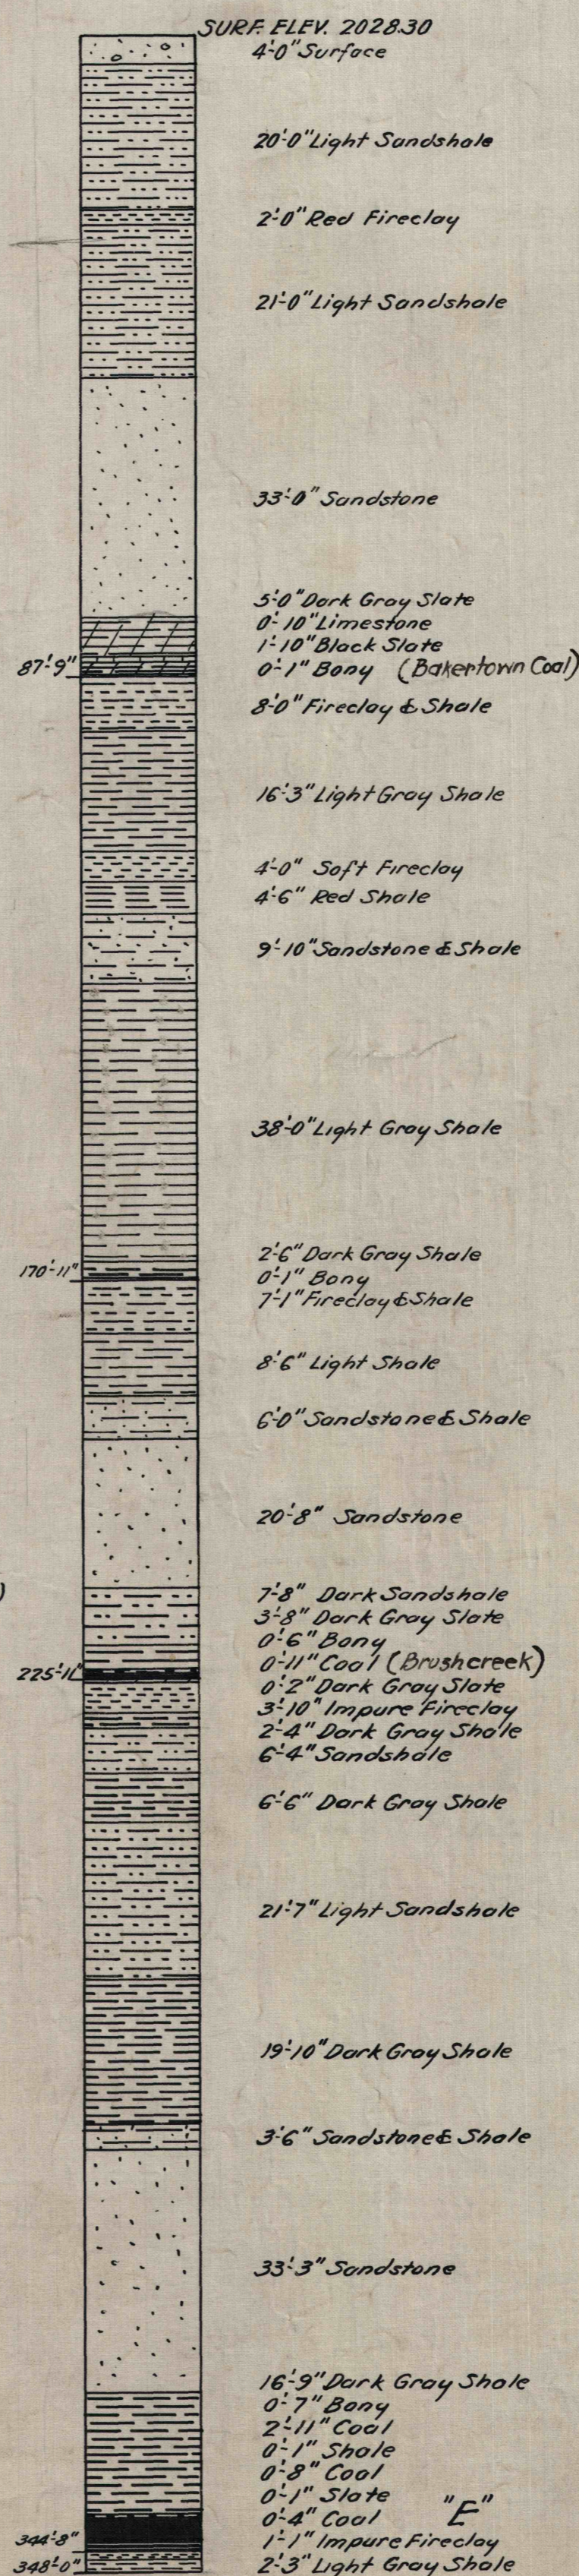


D. D. H. No 98
IRVIN MENSER NO. 1 TR

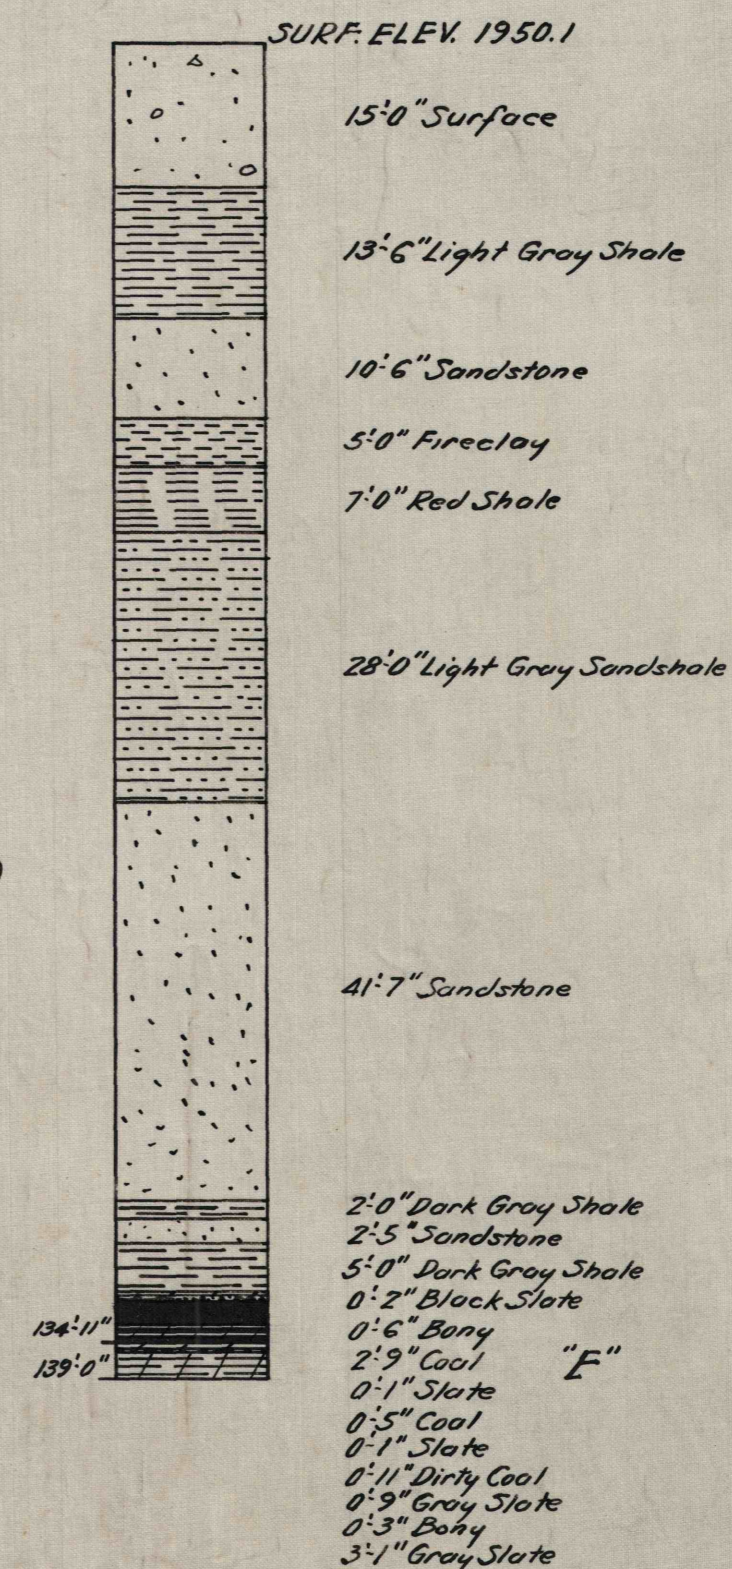


D. D. H. No 100
H. J. SHAULIS NO. 4 TR.

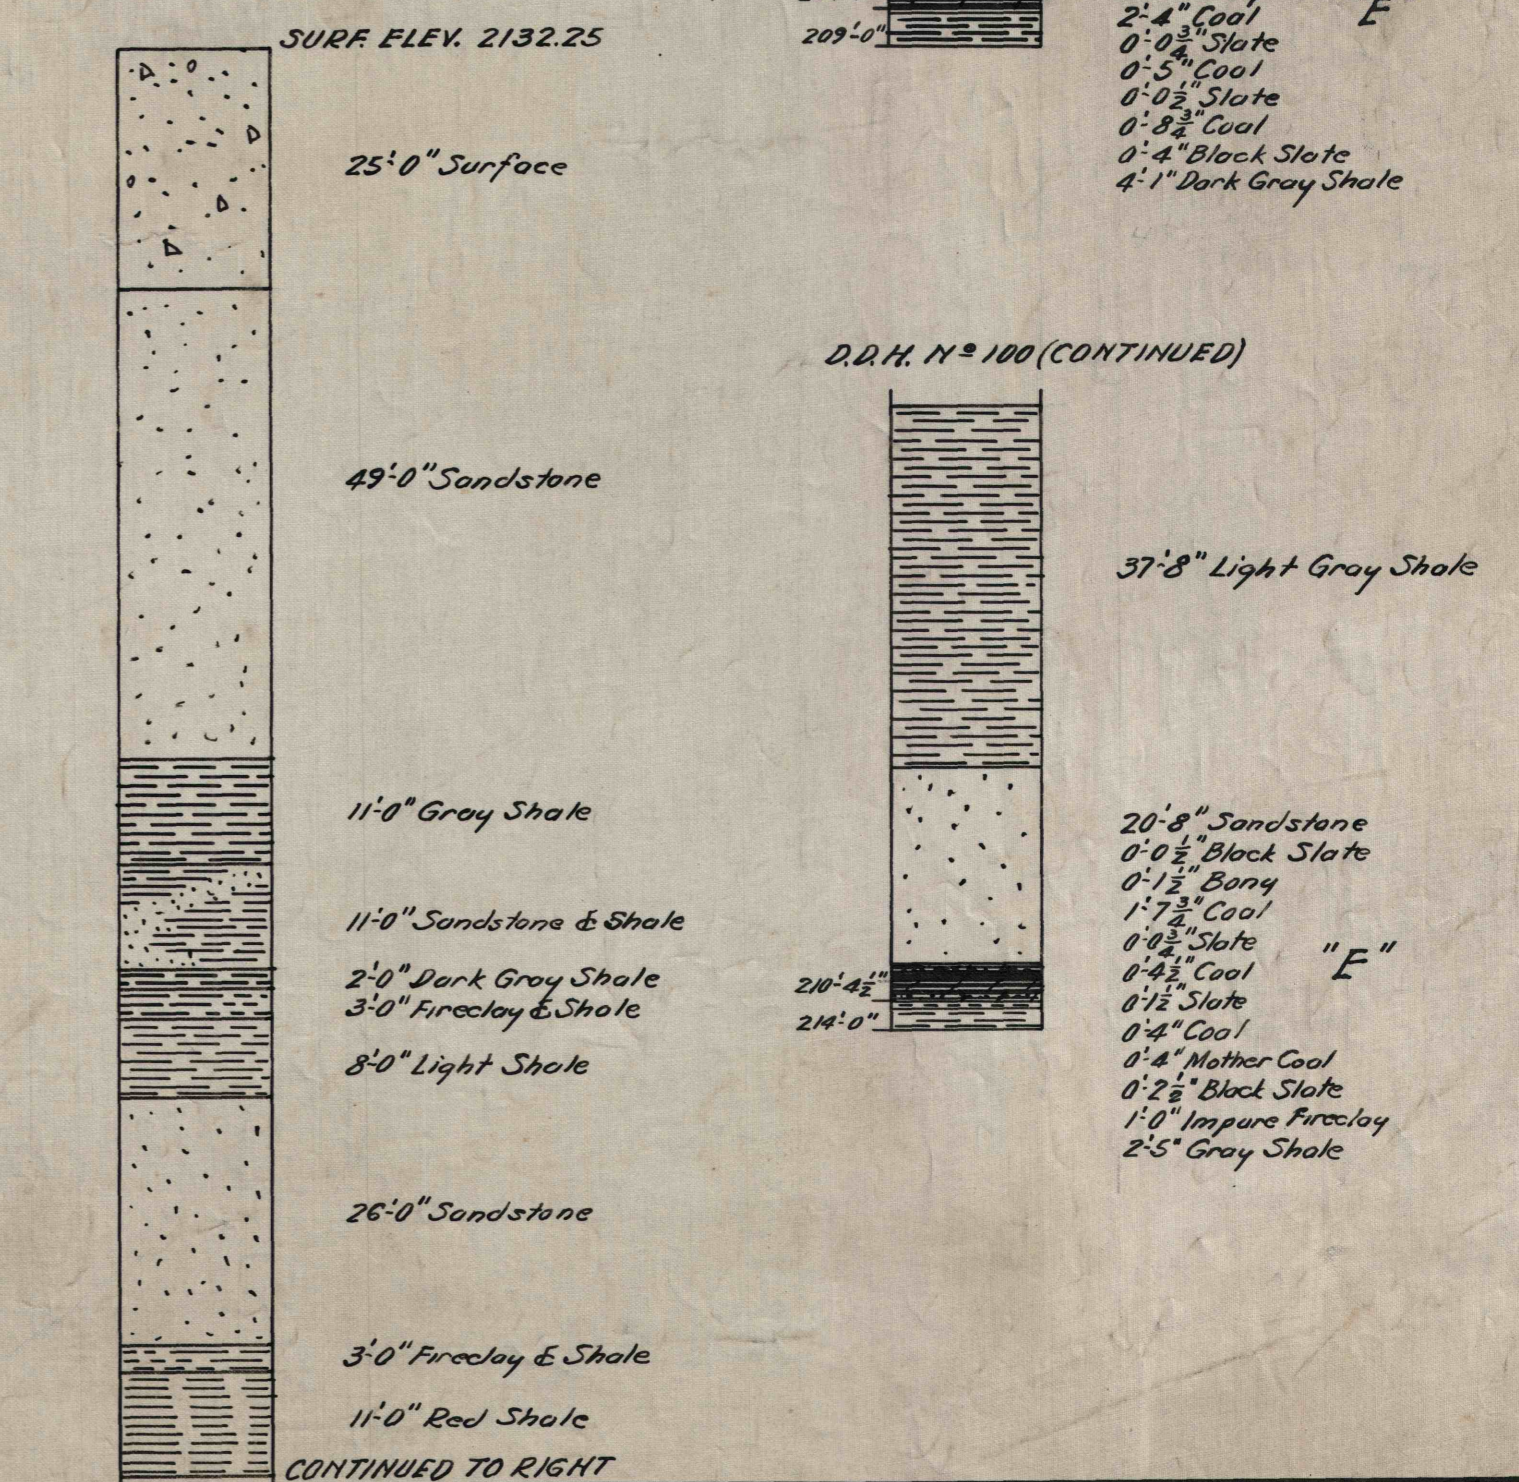

D. D. H. No 95
H. M. SHAFFER TR.

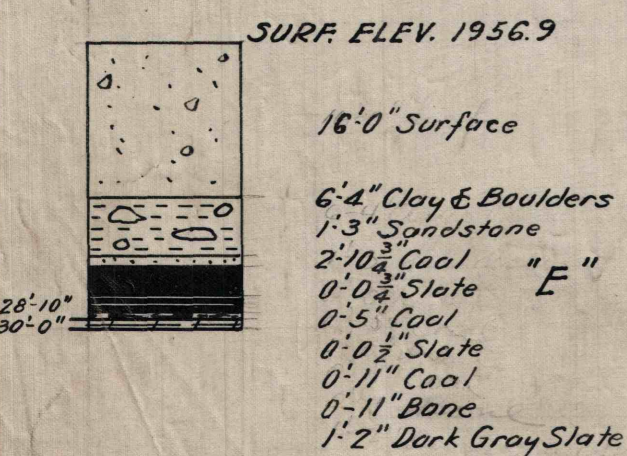

D. D. H. No 96
H. M. SHAFFER TR.

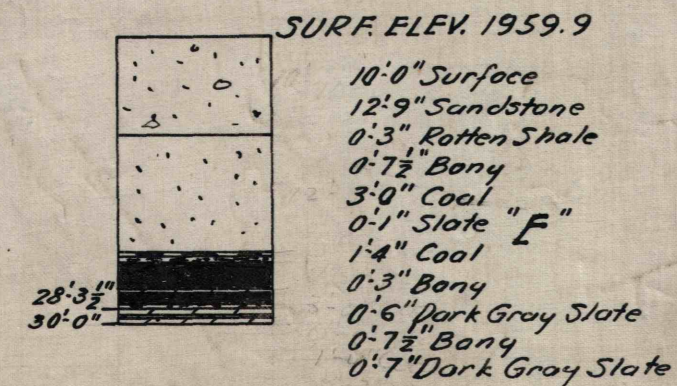

D. D. H. No 97
H. M. SHAFFER TR.

