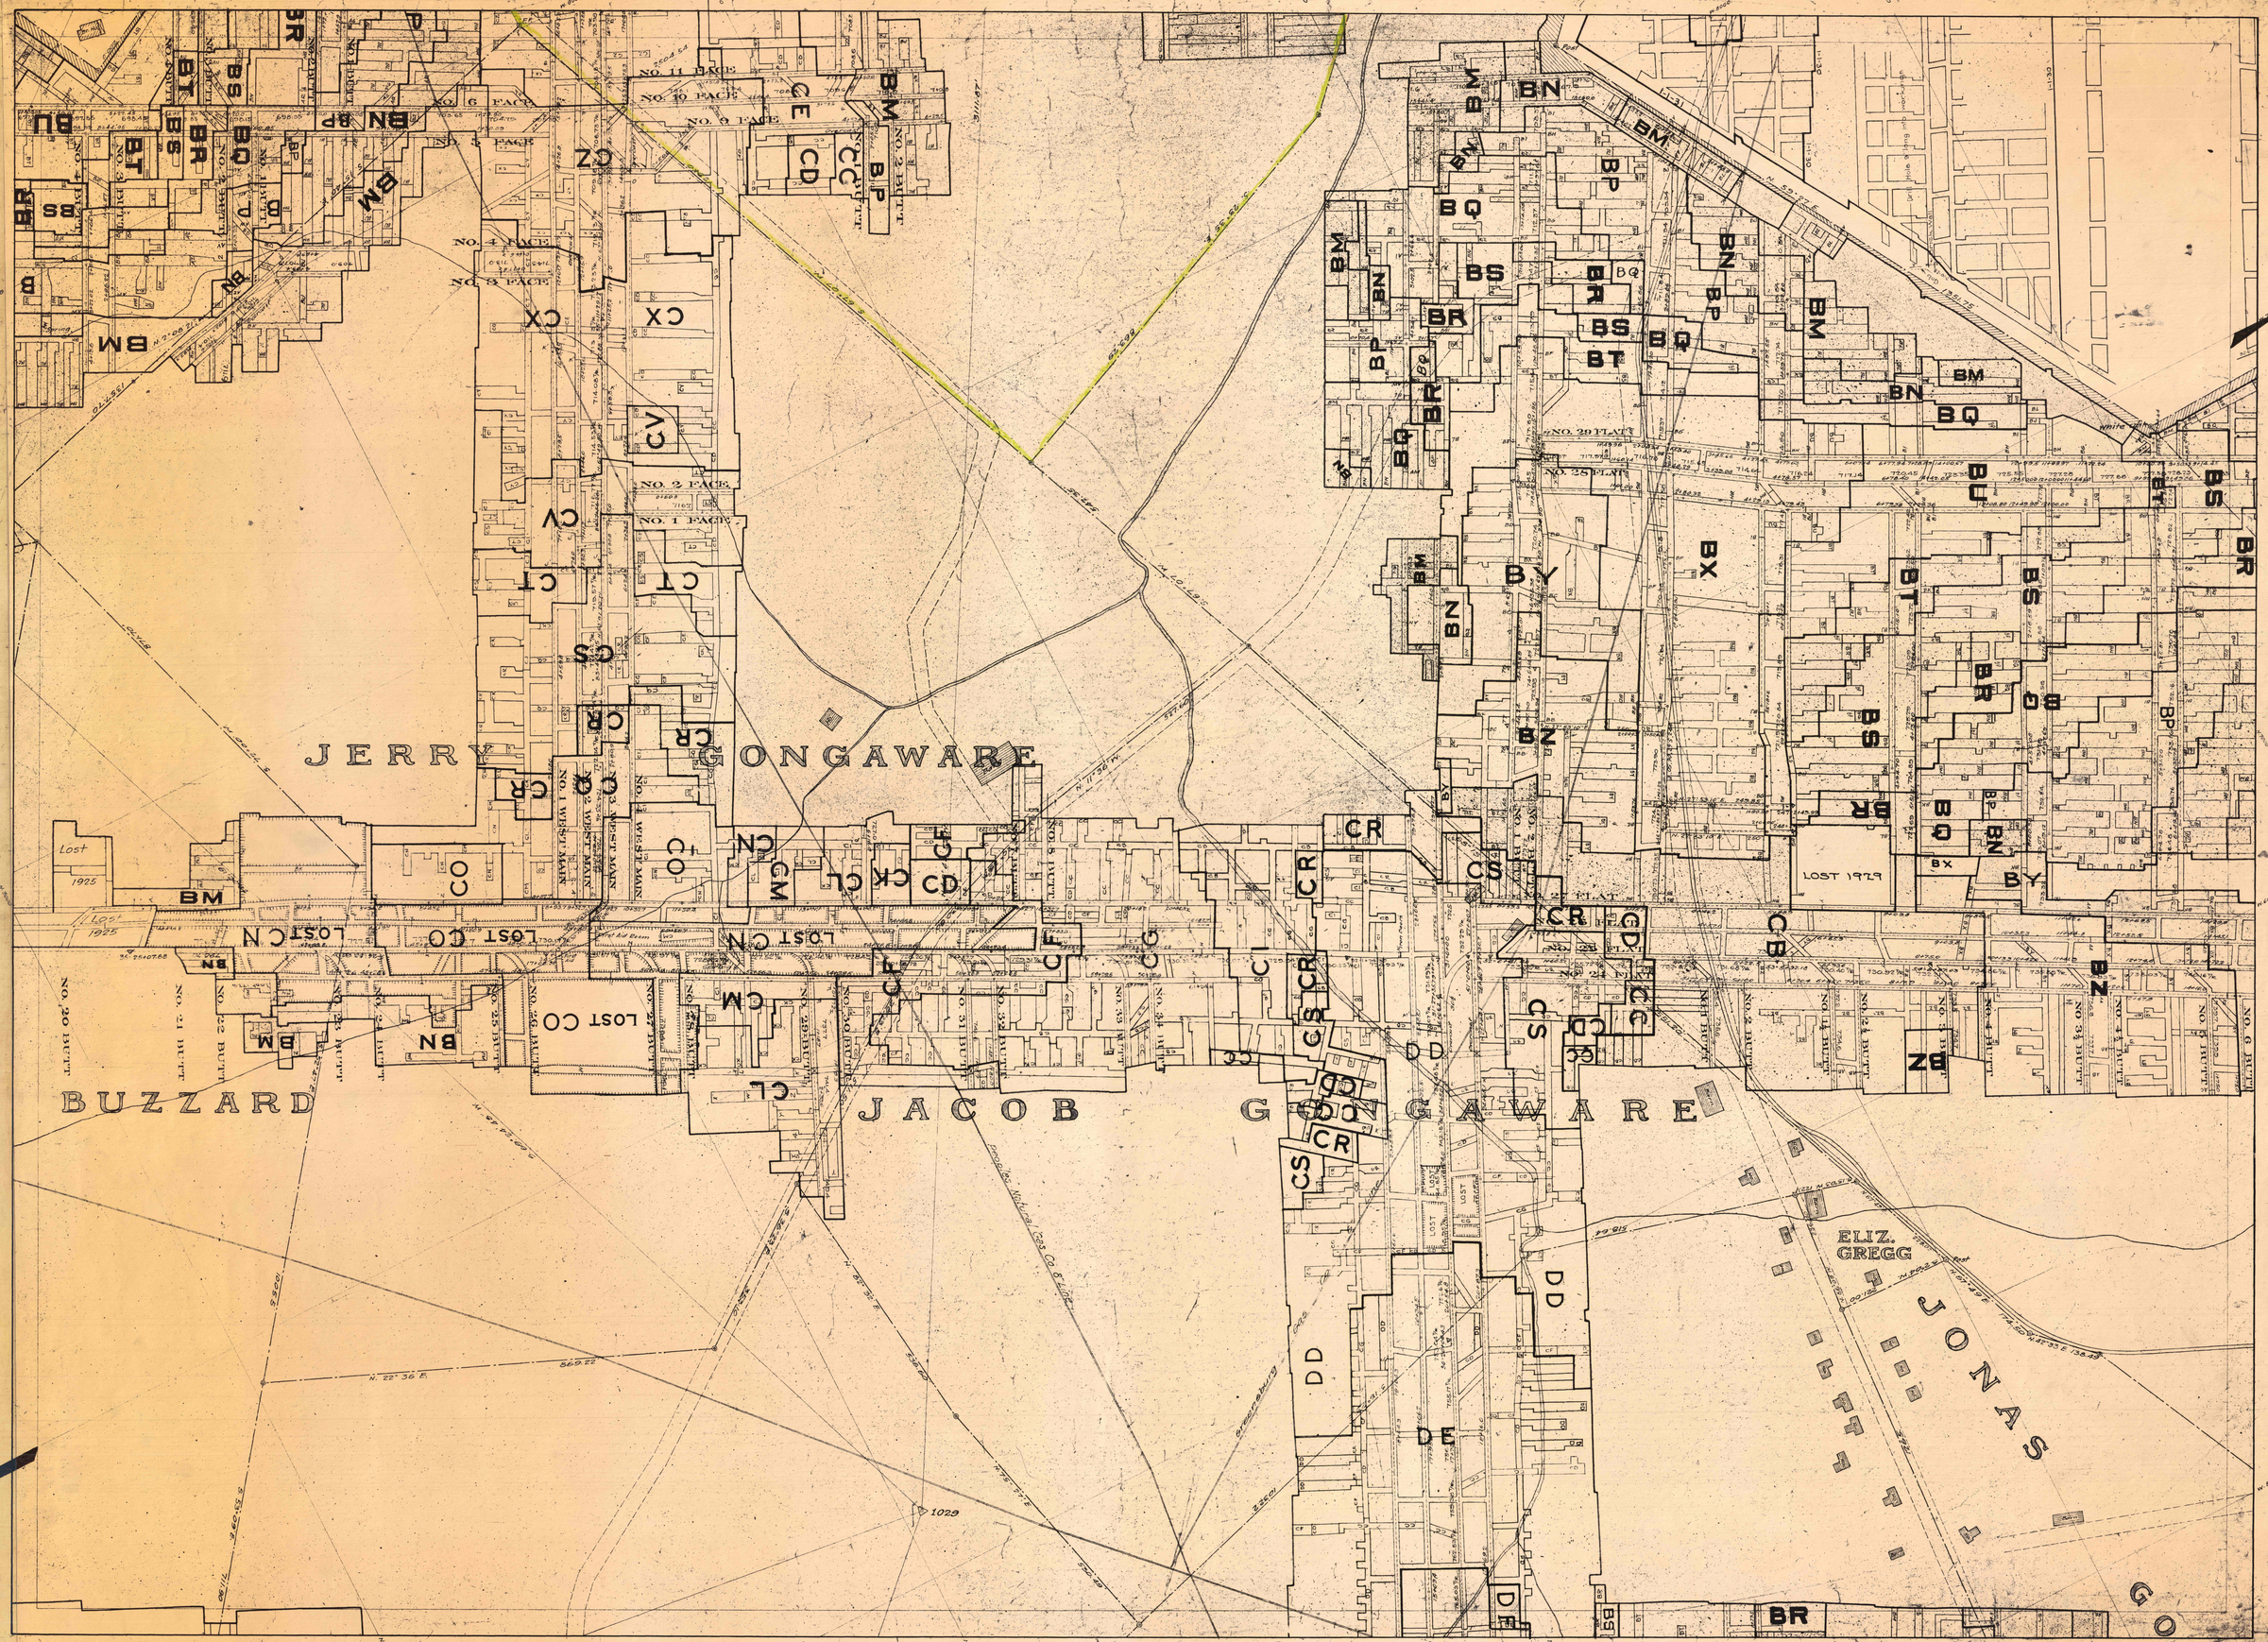
SHEET NO. 15
FIT TO SHEET NO. 19
FIT TO SHEET NO. 14
FIT TO SHEET NO. 16
FIT TO SHEET NO. 11
SHEET NO. 15
JERRY GONGAWARE
BUZZARD
JACOB GONGAWARE
JONAS
ELIZ. GREGG
NO. 11 FACE
NO. 10 FACE
NO. 9 FACE
NO. 6 FACE
NO. 5 FACE
NO. 4 FACE
NO. 3 FACE
NO. 2 FACE
NO. 1 FACE
NO. 29 FLAT
NO. 28 FLAT
LOST 1925
LOST 1929
LOST CO
LOST CN
NO. 20 BUTT
NO. 21 BUTT
NO. 22 BUTT
NO. 23 BUTT
NO. 24 BUTT
NO. 25 BUTT
NO. 26 BUTT
NO. 27 BUTT
NO. 28 BUTT
NO. 29 BUTT
NO. 30 BUTT
NO. 31 BUTT
NO. 32 BUTT
NO. 33 BUTT
NO. 34 BUTT
NO. 2 BUTT
NO. 3 BUTT
NO. 4 BUTT
NO. 5 BUTT
NO. 6 BUTT
NO. 1 WEST MAIN
NO. 2 WEST MAIN
NO. 3 WEST MAIN
NO. 4 WEST MAIN
NO. 8 BUTT
1029