


FIT TO SHEET NO. 22

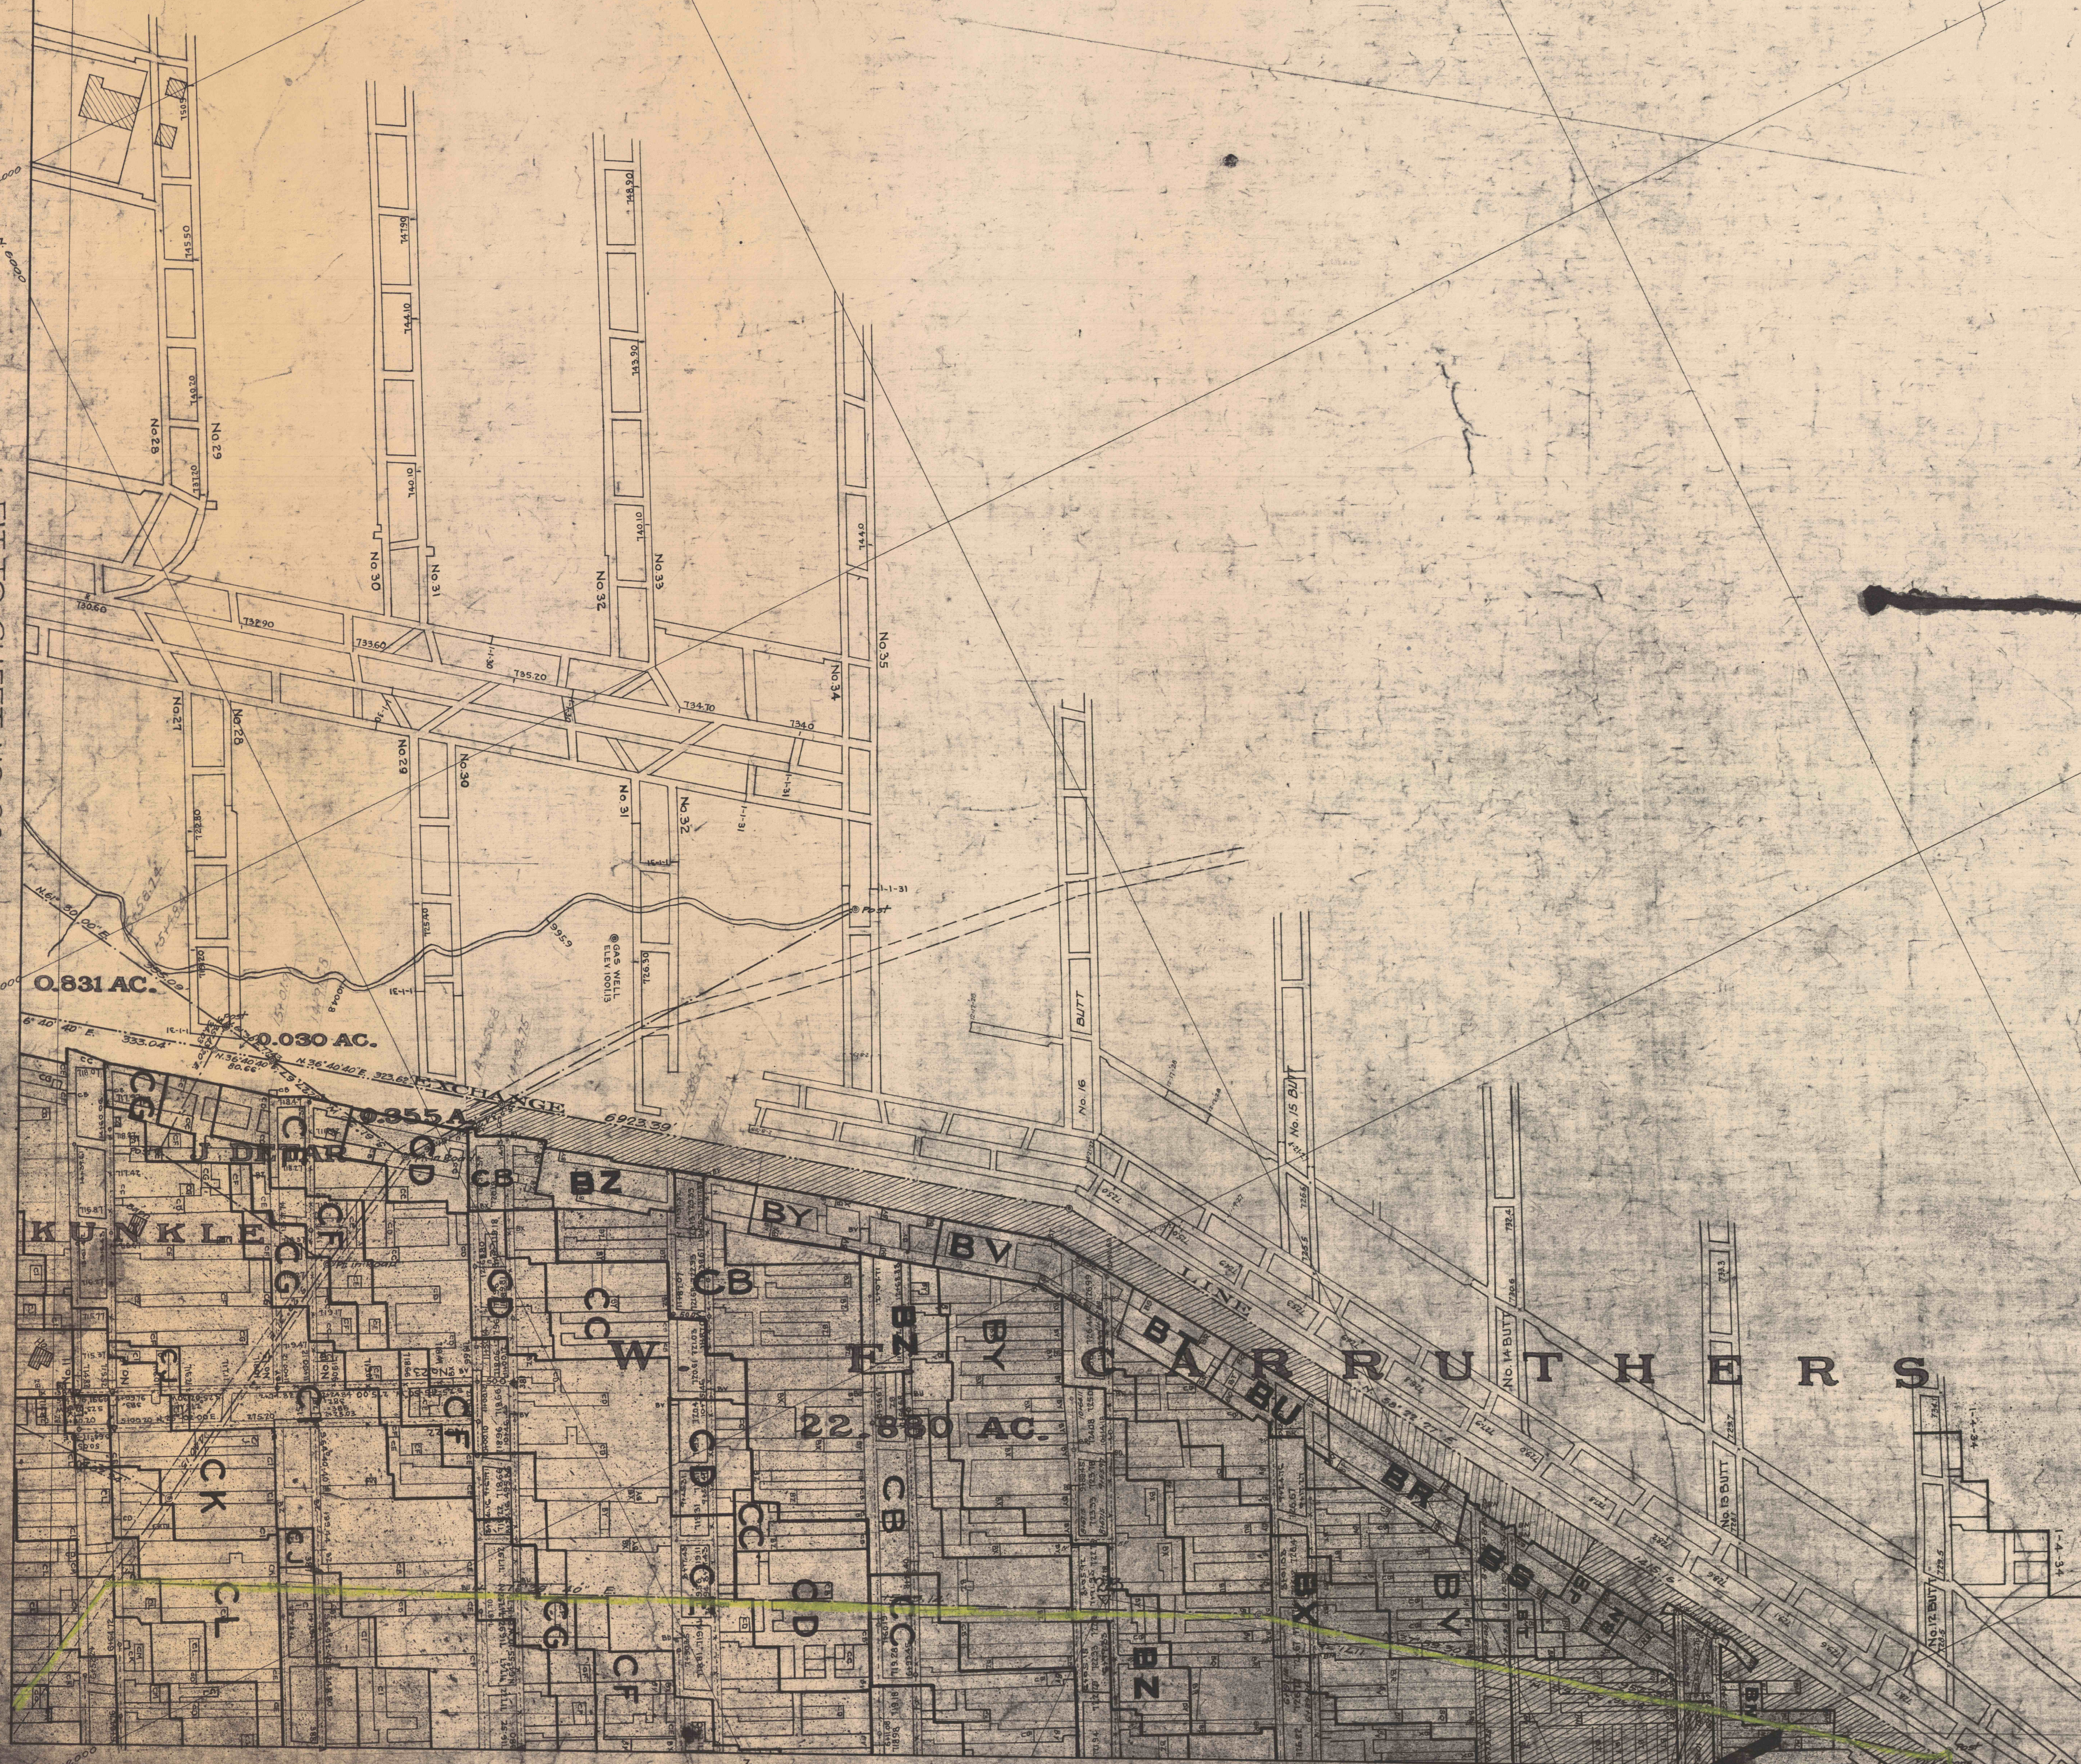

FIT TO SHEET NO. 19

FIT TO SHEET NO. 24