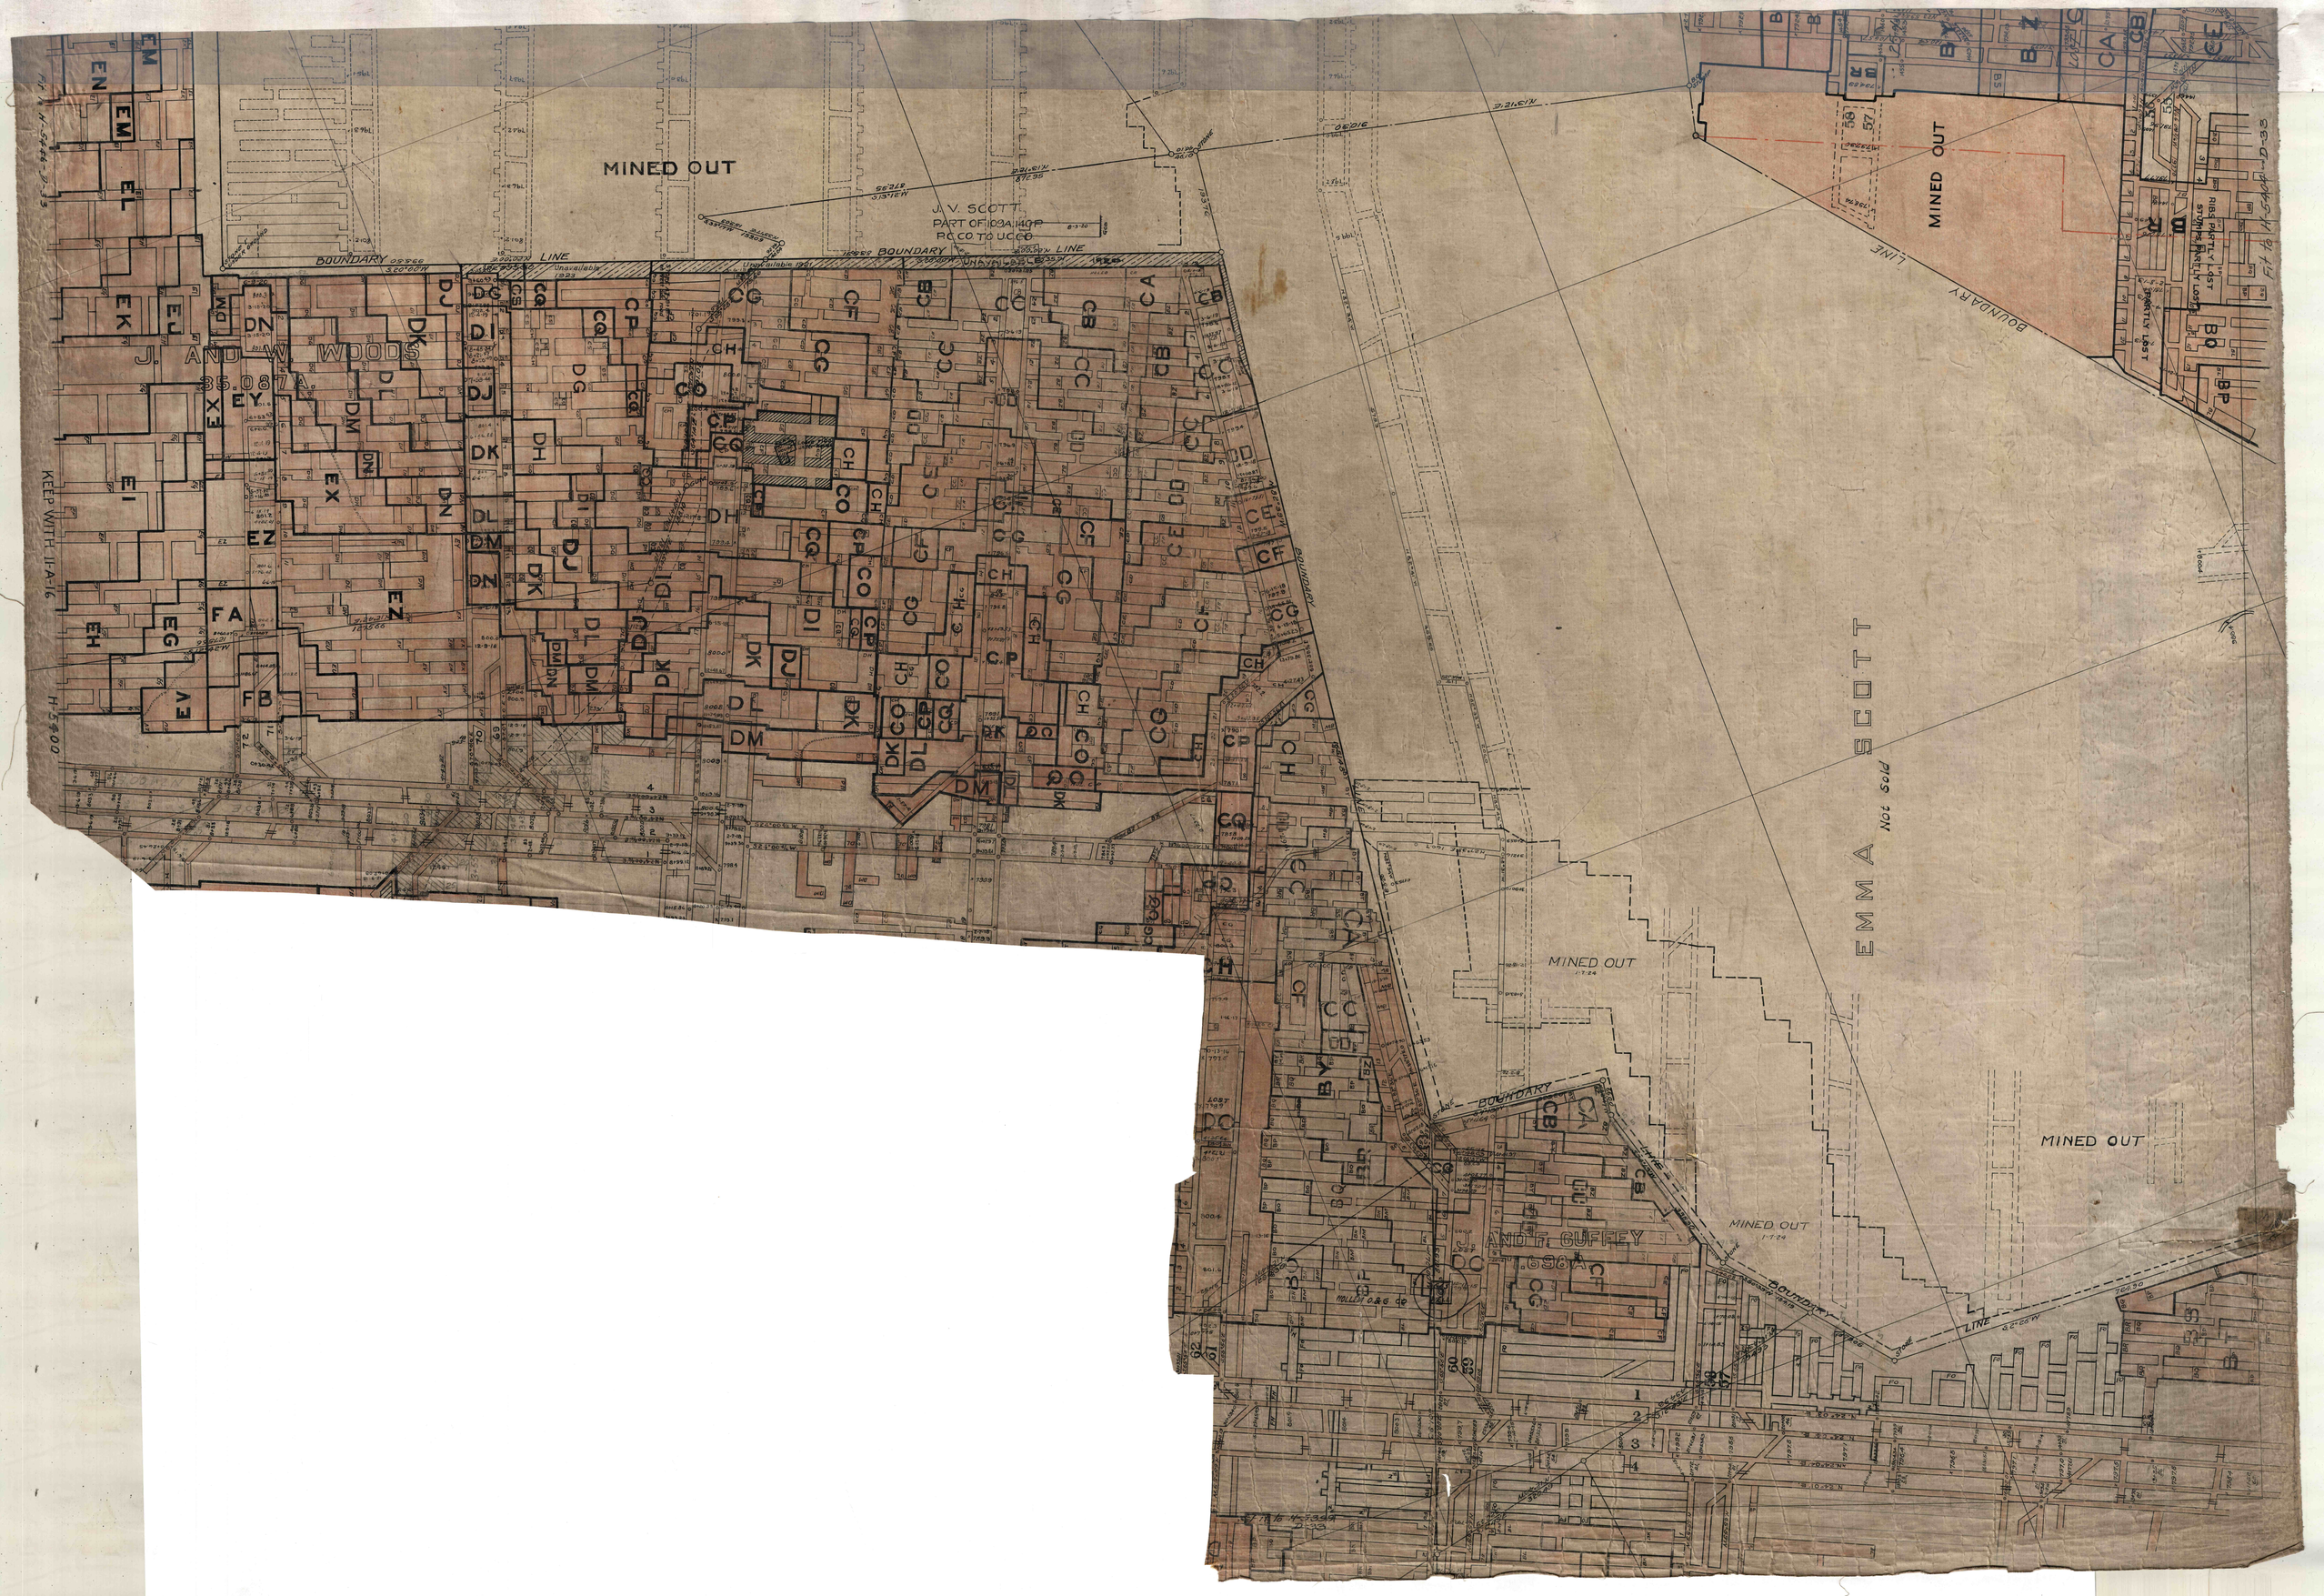
MINED OUT
J. V. SCOTT
PART OF 109A, 140P
P.C.CO. TO UCCO
BOUNDARY LINE
J. AND W. WOODS
35.087A
KEEP WITH 11-A-16
H-5400
EMMA SCOTT
Not Sold
MINED OUT
MINED OUT
MINED OUT
MINED OUT
BOUNDARY LINE
J. AND F. GUFFEY
.698A
HOLLEM O.&G. CO.
RIBS PARTLY LOST
STUMPS PARTLY LOST
PARTLY LOST