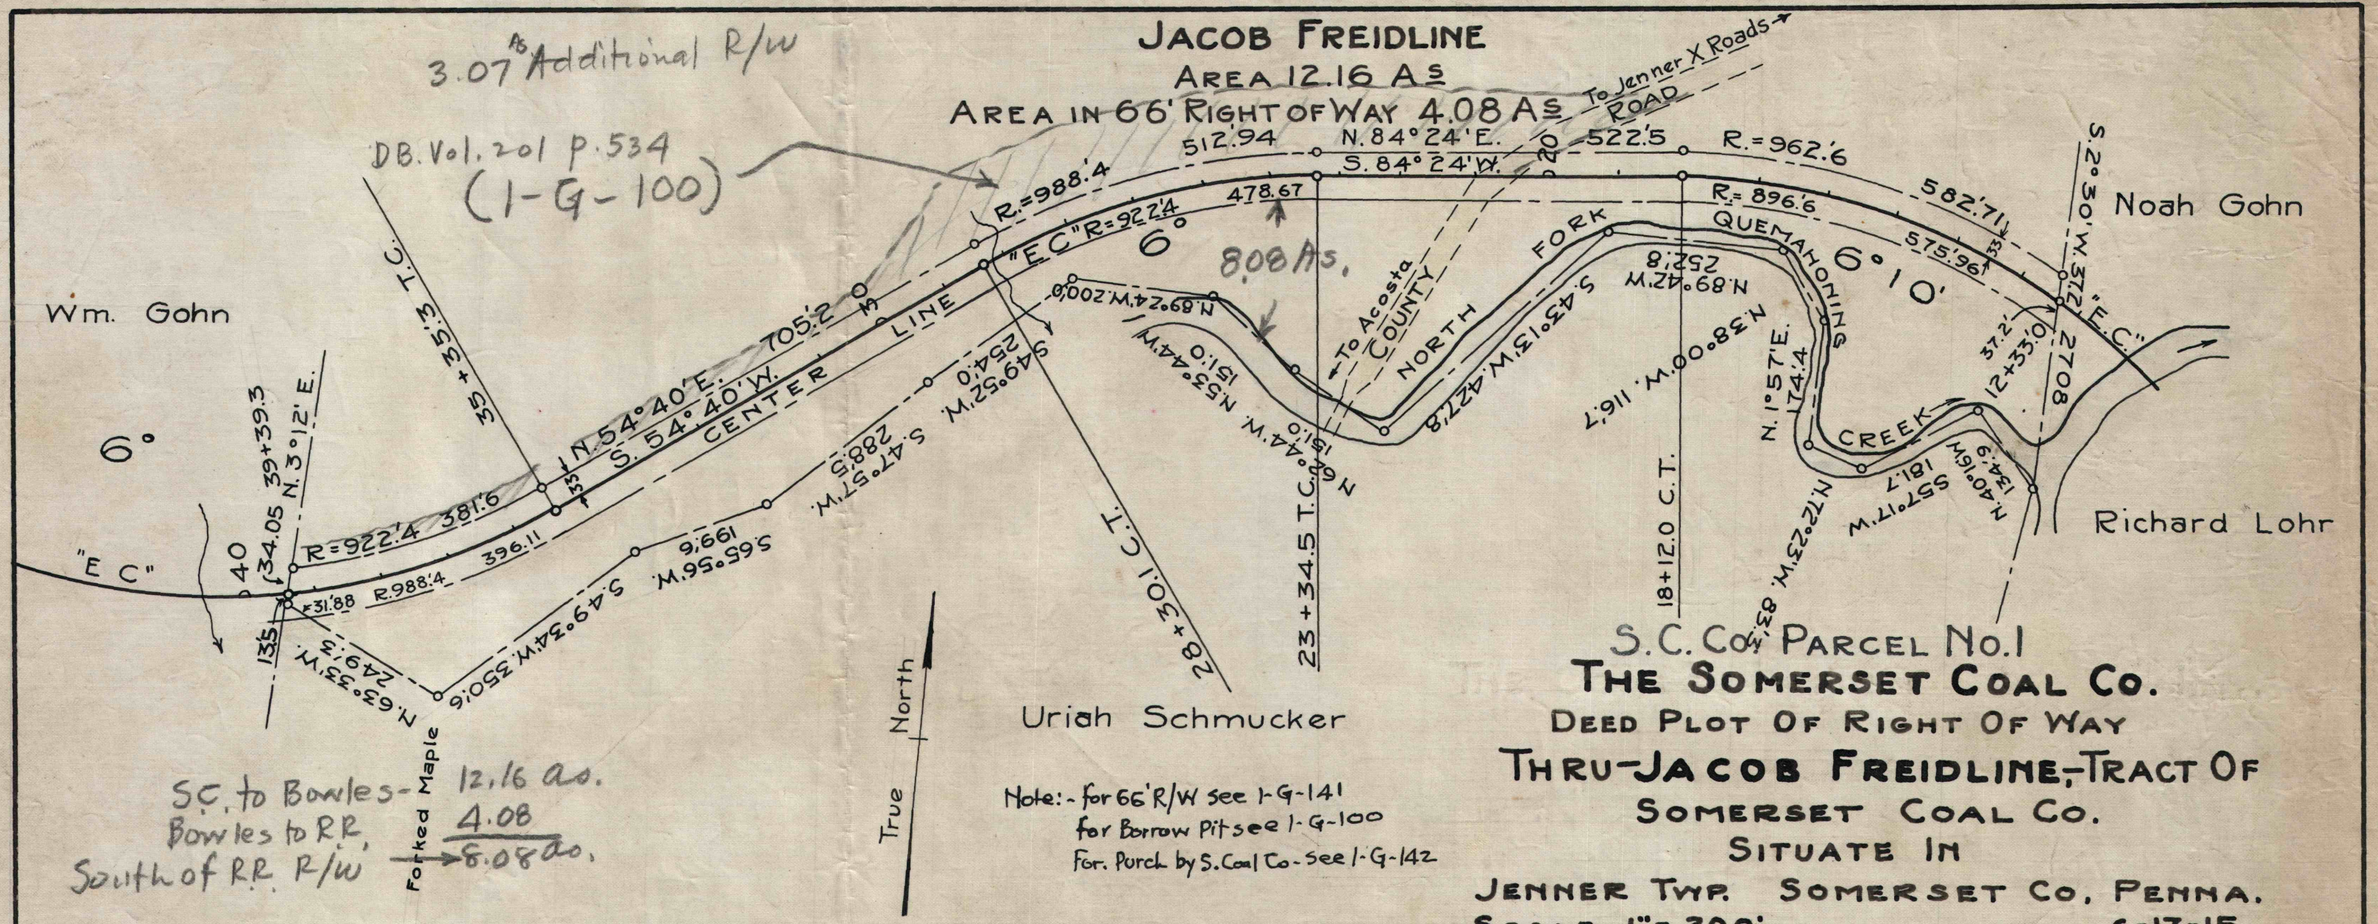
JACOB FREIDLINE
AREA 12.16 As
AREA IN 66' RIGHT OF WAY 4.08 As
3.07 As Additional R/W
DB. Vol. 201 p. 534
(1-G-100)
To Jenner X Roads
ROAD
N. 84° 24' E.
S. 84° 24' W.
512.94
522.5
R. = 962.6
R. = 988.4
R. = 922.4
478.67
R. = 896.6
582.71
575.96
S. 2° 30' W. 37.2'
Noah Gohn
Wm. Gohn
6°
6° 10'
8.08 As.
"E C"
N. 54° 40' E.
S. 54° 40' W.
705.2
CENTER LINE
35 + 35.3 T.C.
N. 3° 12' E.
39 + 39.3
34.05
R. = 922.4
381.6
396.11
R. 988.4
31.88
13.5
N. 63° 33' W. 249.3
S. 49° 34' W. 350.6
S. 65° 56' W. 199.6
S. 47° 57' W. 288.5
S. 49° 52' W. 254.0
N. 89° 24' W. 200.0
N. 53° 44' W. 151.0
N. 62° 44' W. 151.0
To Acosta COUNTY
NORTH FORK
QUEMAHONING CREEK
S. 43° 13' W. 427.8
N. 89° 42' W. 252.8
N. 38° 00' W. 116.7
N. 1° 57' E. 174.4
N. 72° 23' W. 83.3
S. 57° 17' W. 181.7
N. 40° 16' W. 134.9
12 + 33.0
37.2'
2708
Richard Lohr
28 + 30.1 C.T.
23 + 34.5 T.C.
18 + 12.0 C.T.
Uriah Schmucker
True North
Forked Maple
S.C. to Bowles - 12.16 as.
Bowles to R.R. 4.08
South of R.R. R/W → 8.08 as.
Note: - for 66' R/W see 1-G-141
for Borrow Pit see 1-G-100
For. Purch by S. Coal Co - see 1-G-142
S.C. Co. PARCEL No. 1
THE SOMERSET COAL CO.
DEED PLOT OF RIGHT OF WAY
THRU-JACOB FREIDLINE,-TRACT OF
SOMERSET COAL CO.
SITUATE IN
JENNER TWP. SOMERSET CO. PENNA.
SCALE 1" = 200'
6-17-15
ENGR. DEPT. PENNA. DIV.

1-G-84