



SOMERSET CO. PA.  
JENNEE TWP.

SCHEDULE OF PROPERTY

Station	Substation	Kind of Substation	Date of Interpretation	Owner	Quantity	Subst. No.	Acres	Remarks

RECORD OF CHANGES AFTER JUNE 30, 1919

STATION	COMM. REP. NO.	DATE COMPL.	DATE PUT ON MAP	KIND OF CHANGE

 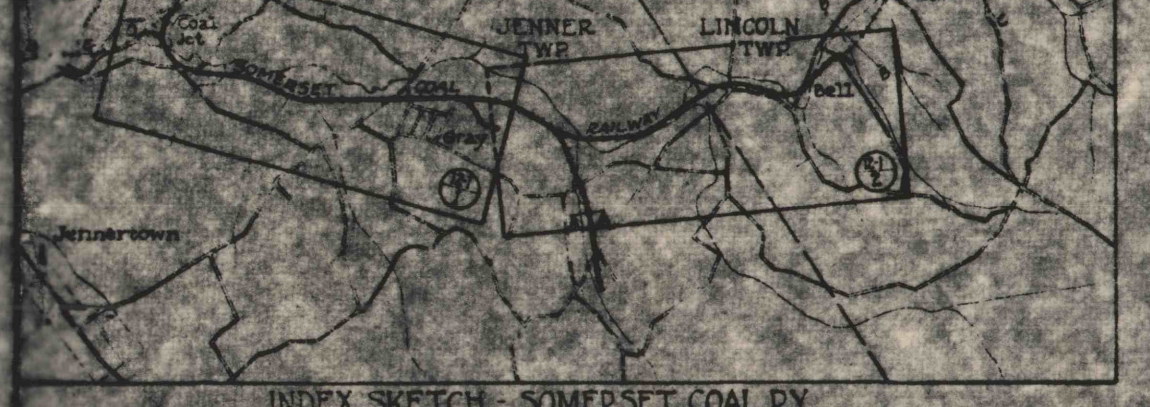

Note:  
To get original stationing from 0+00 to station 46+43.4 (127)  
subtract 192 feet and from station 46+43.4 to station 218+00  
subtract 203 feet

STATE OF MARYLAND  
CITY OF BALTIMORE  
I, the undersigned, OFFICER OF THE CITY OF BALTIMORE, do hereby certify that this is a correct map in a series of 2 primary sheets and supplemental sheets of the Somerset Coal Railway Company, from Survey Station 0+00 to Survey Station 112+00 Main Line, State of Maryland, prepared for the records of said company.  
W. B. BROWN  
VALUATION ENGINEER  
SUBSCRIBED AND SWORN to before me, this 25th day of June, 1919, at Baltimore, Maryland.  
NOTARY PUBLIC IN AND FOR THE CITY OF BALTIMORE, STATE OF MARYLAND.  
M. J. COMMISSION EXPIRES  
July 1, 1921  
NOTICE: MAP NO. 29 (BALTIMORE) ISSUED TO 2000 SERIES BY ITS COMPLETION ON MAY 8, 1921.