


Plat 3	9-224	also prep file
C-361	9-210	
D-418	9-211	
9-206	9-211	
9-208	9-211	

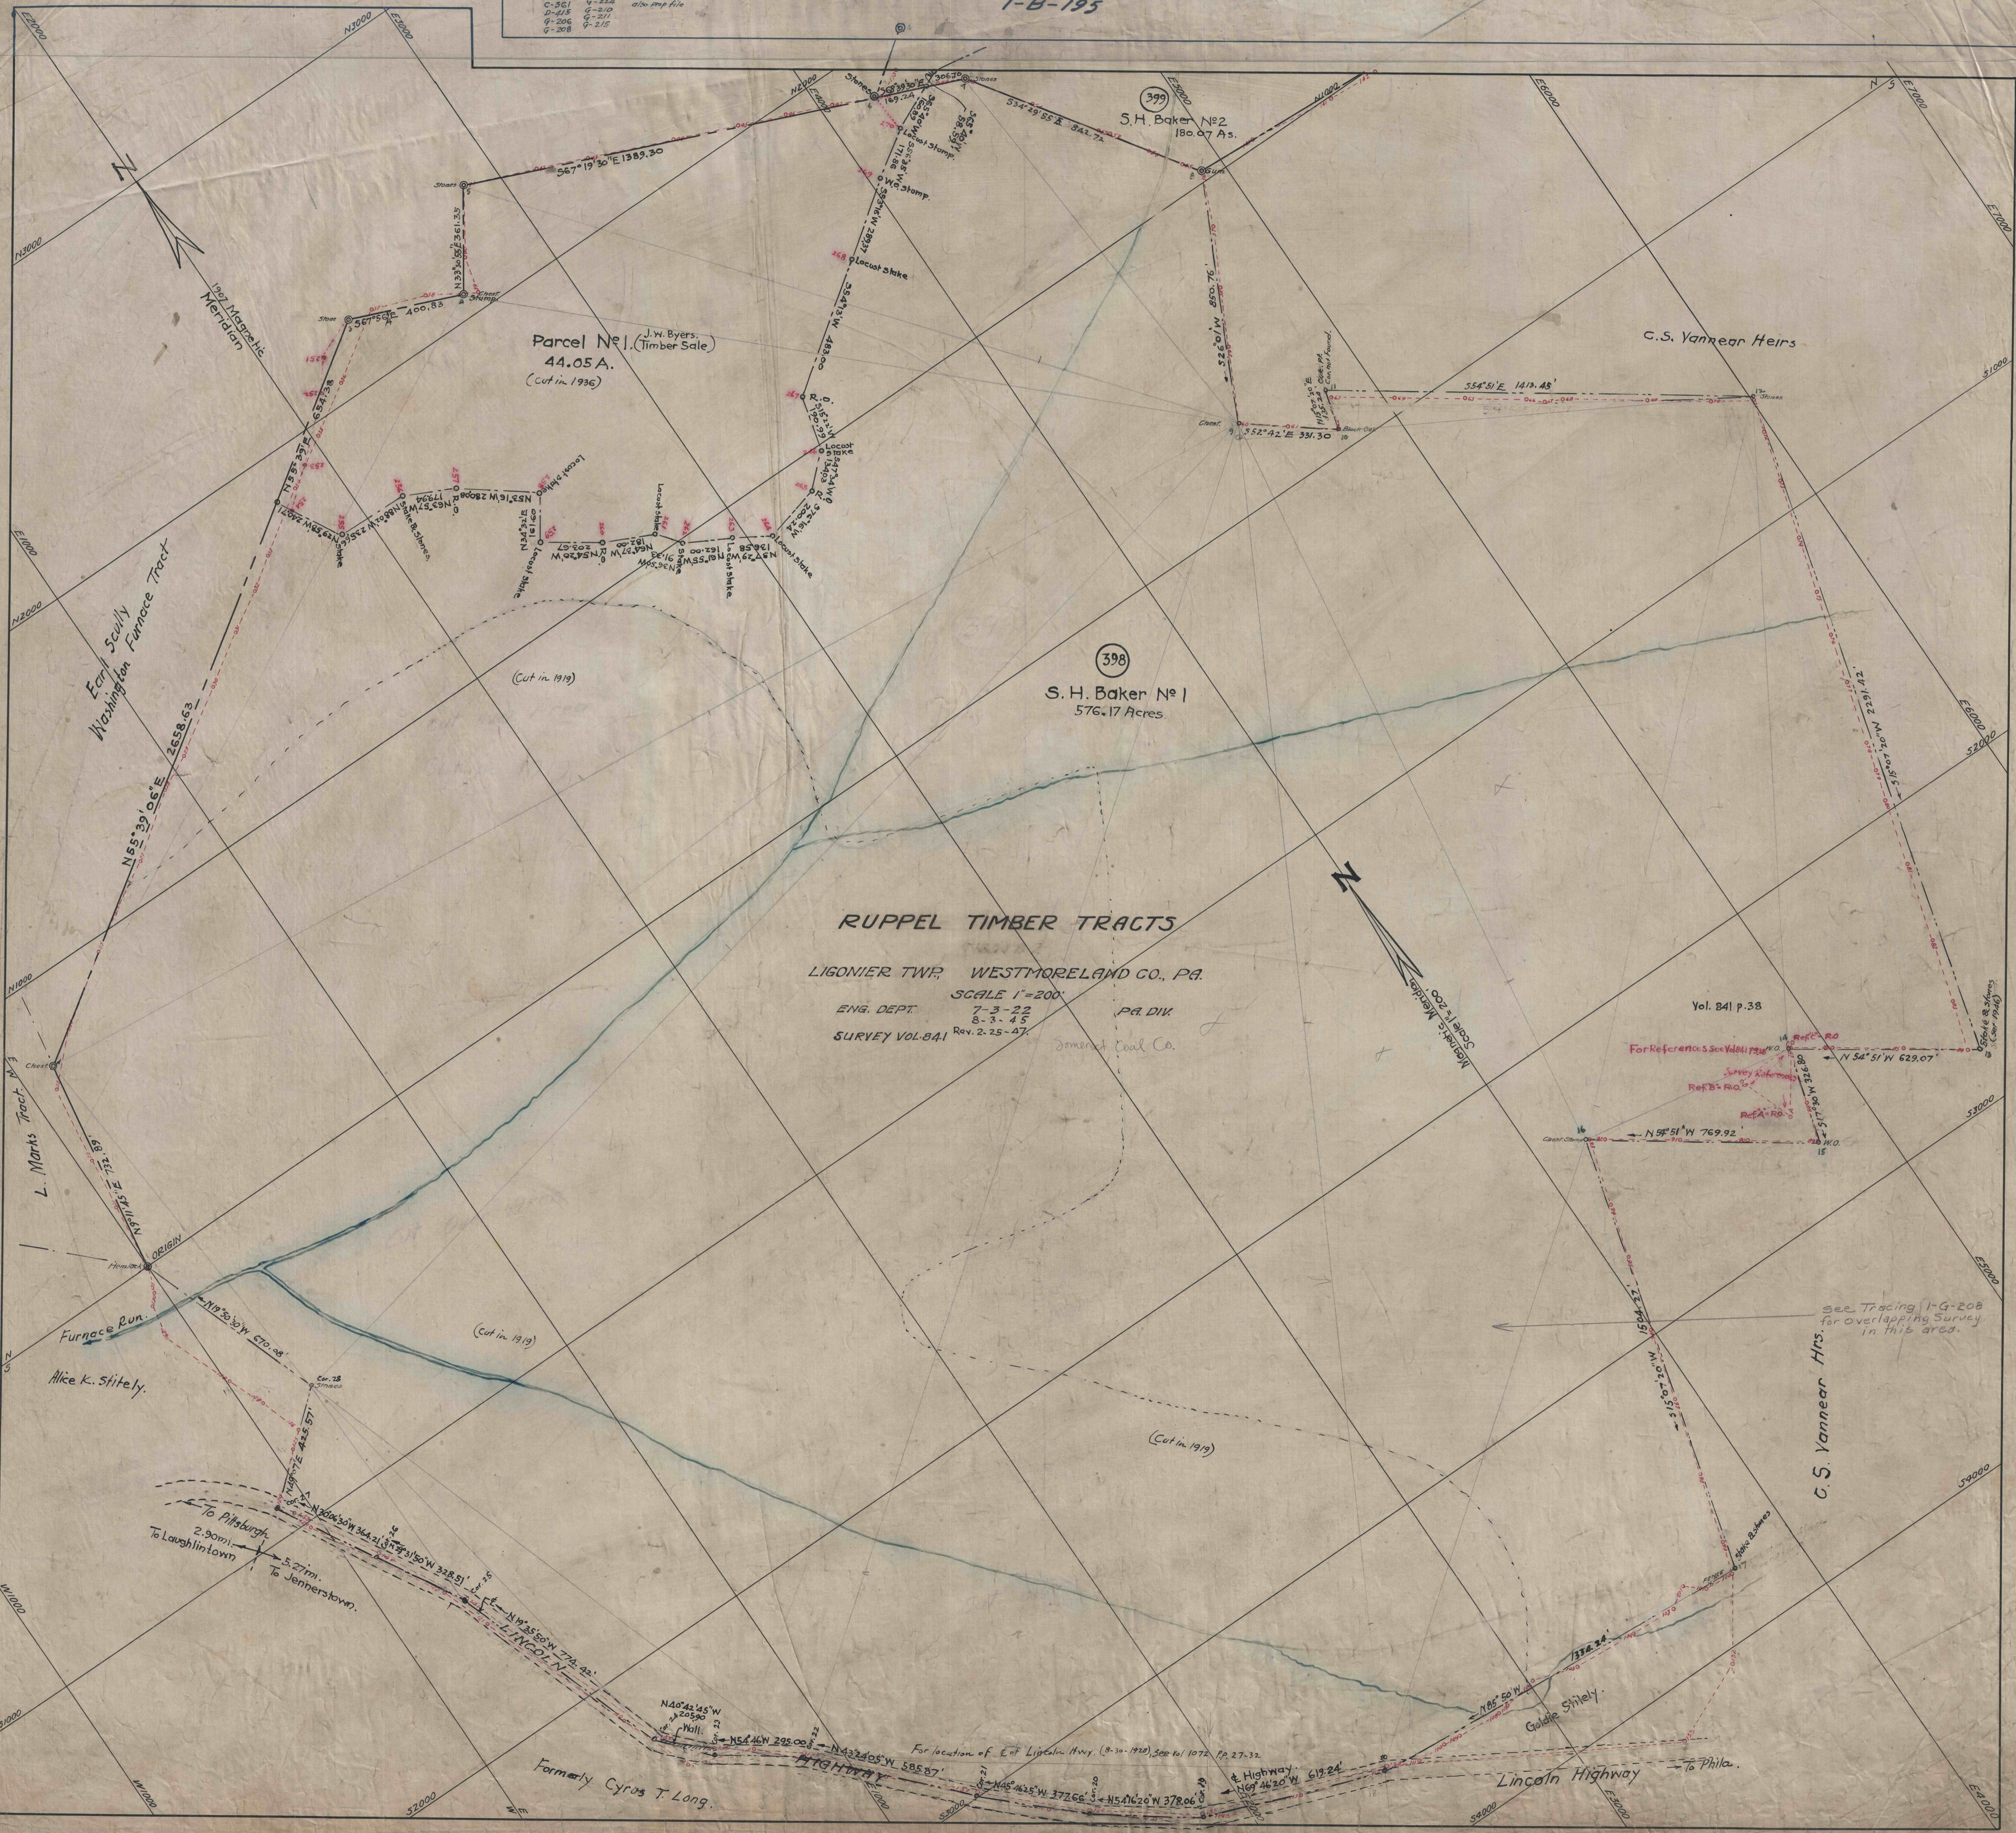

RUPPEL TIMBER TRACTS

LIGONIER TWP, WESTMORELAND CO., PA.

SCALE 1"=200'

ENG. DEPT. 7-3-22 PA. DIV  
8-3-45  
SURVEY VOL. 841 REV. 2-25-47


Vol. 841 p. 38

For Reference see Vol. 841 p. 38  
 Survey Reference  

See Tracing 1-G-208 for overlapping survey in this area.

C. S. Yanner Hrs.


Lincoln Highway → Phila.