


BORE HOLE No. 8 J. HOFFMAN EST. '2.
ELE. 2112.77

BORE HOLE No. 9 J. HOFFMAN EST. '1.
ELE. 1842.17

BORE HOLE No. 10 J. WEIGLEY.
ELE. 1830.31

1-F14

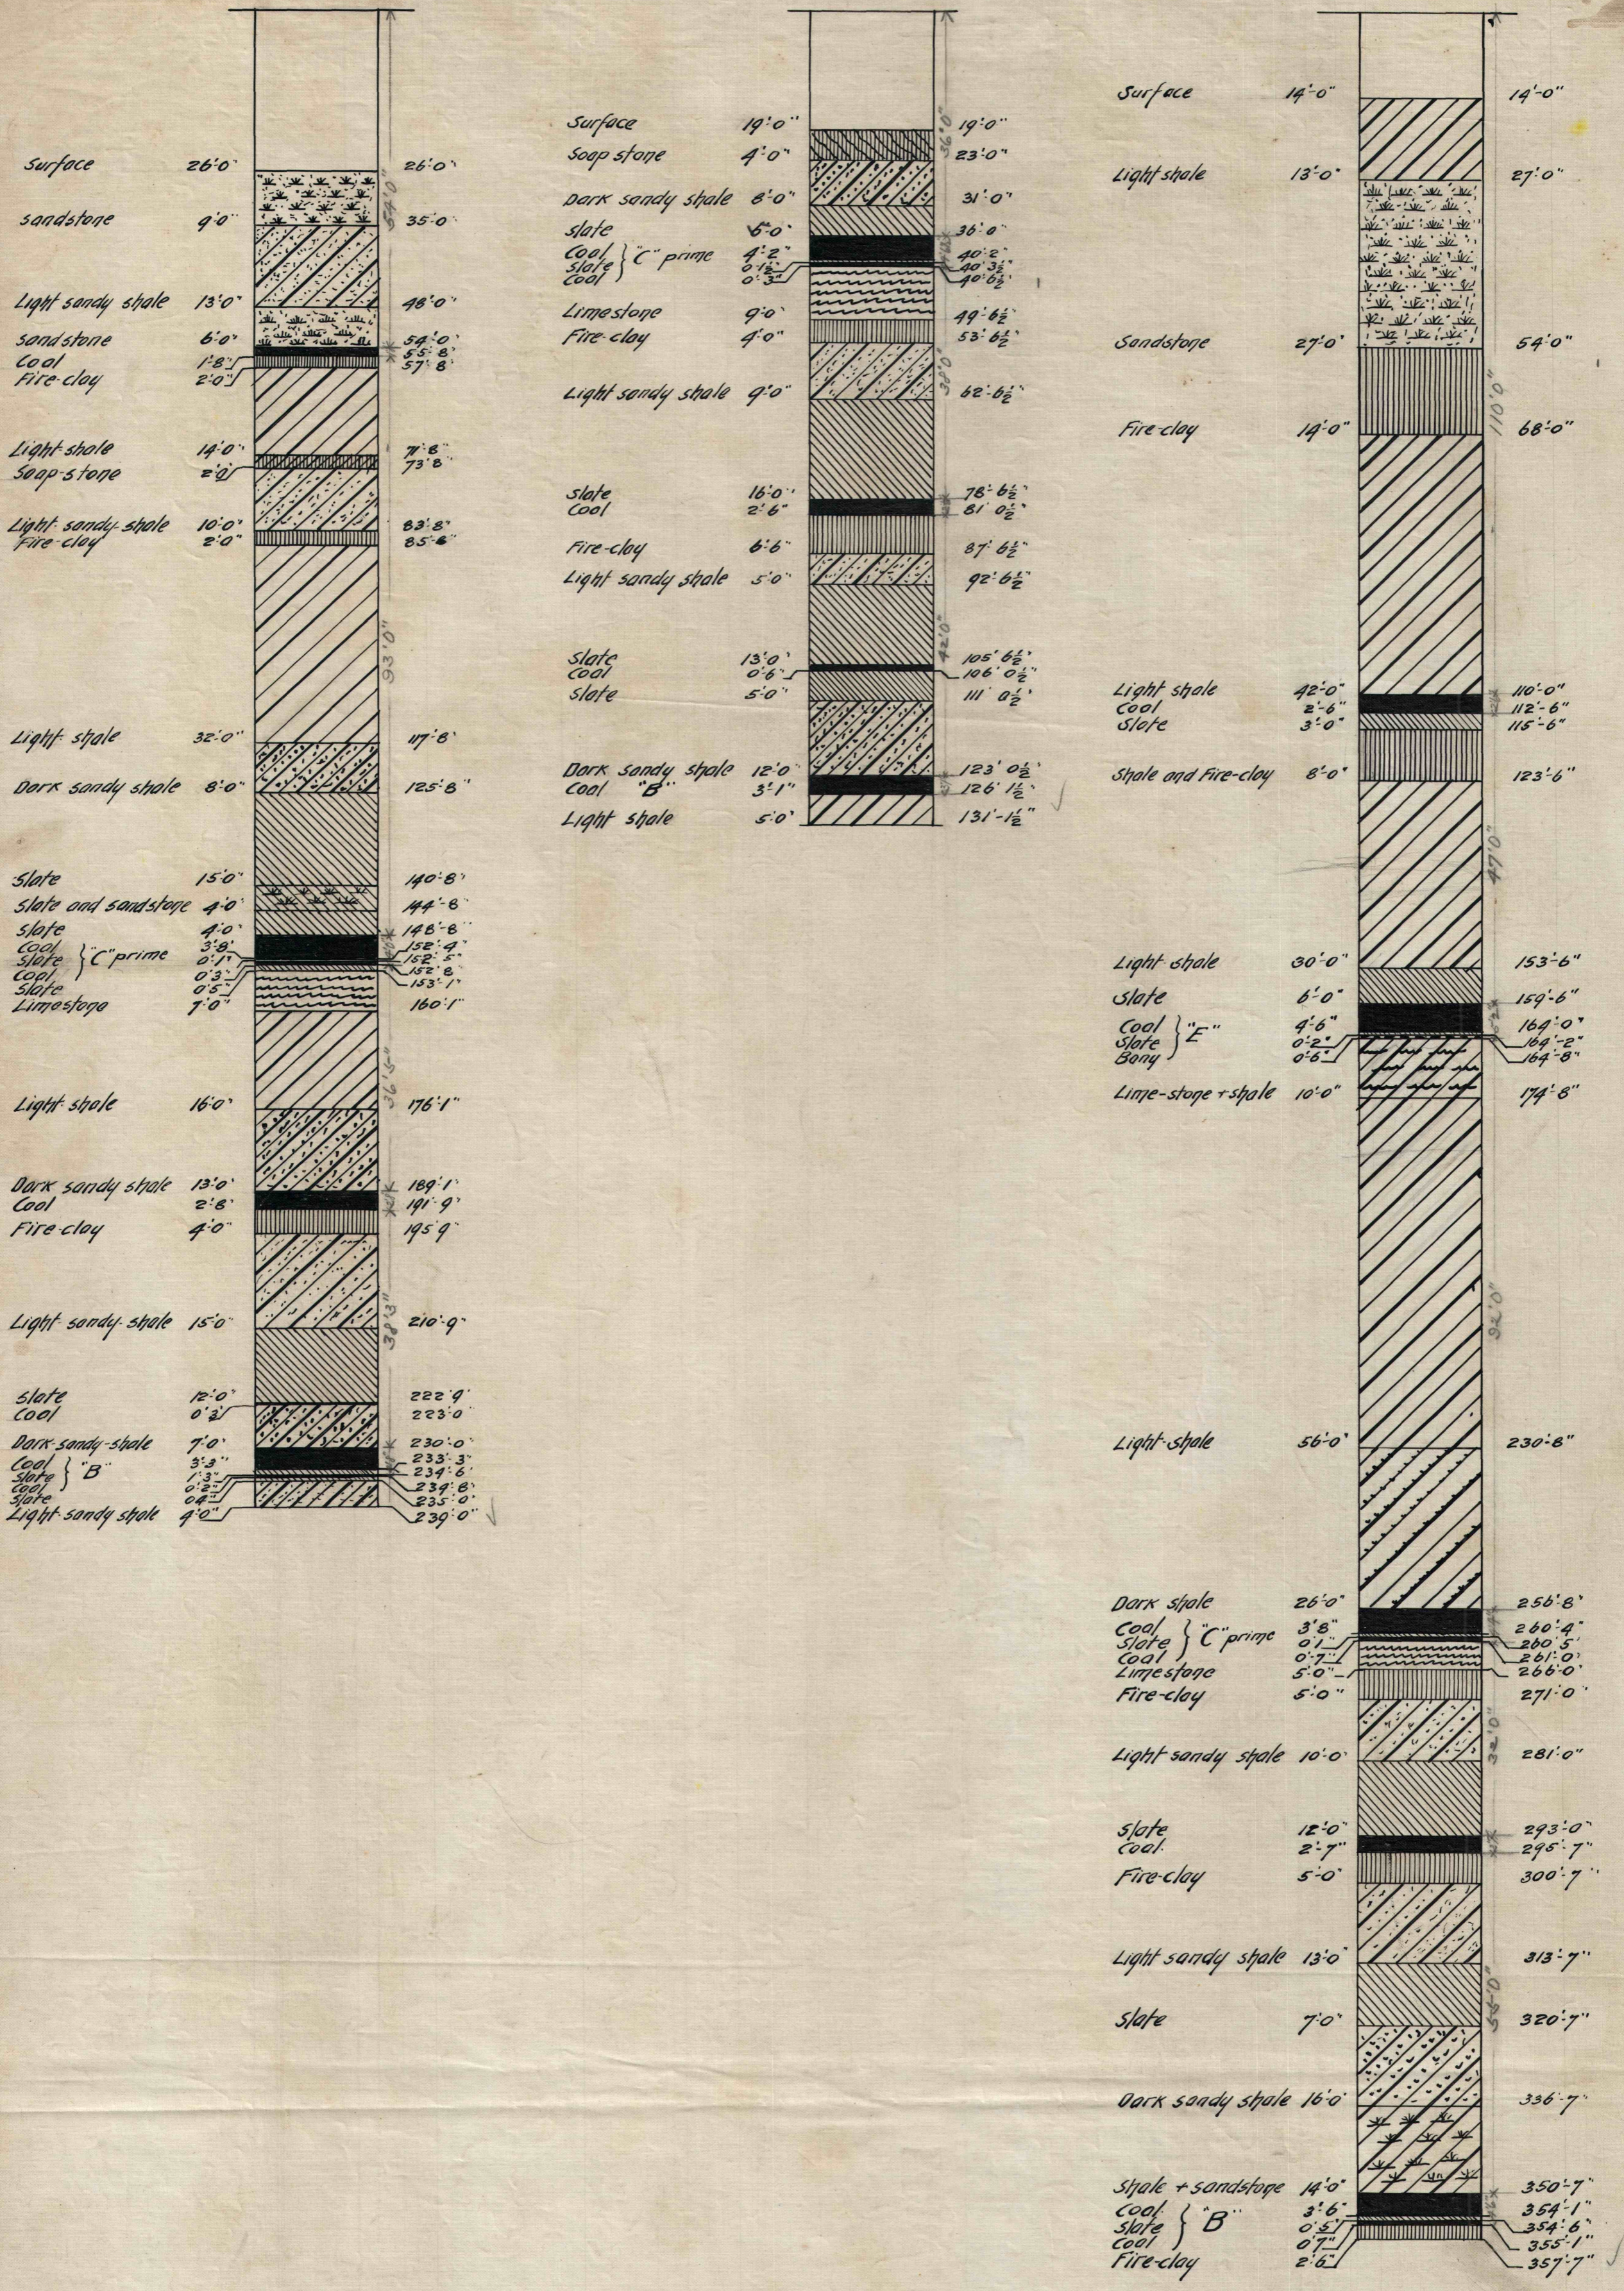

1-F14

F14