


FRONT


BASEMENT FLOOR PLAN

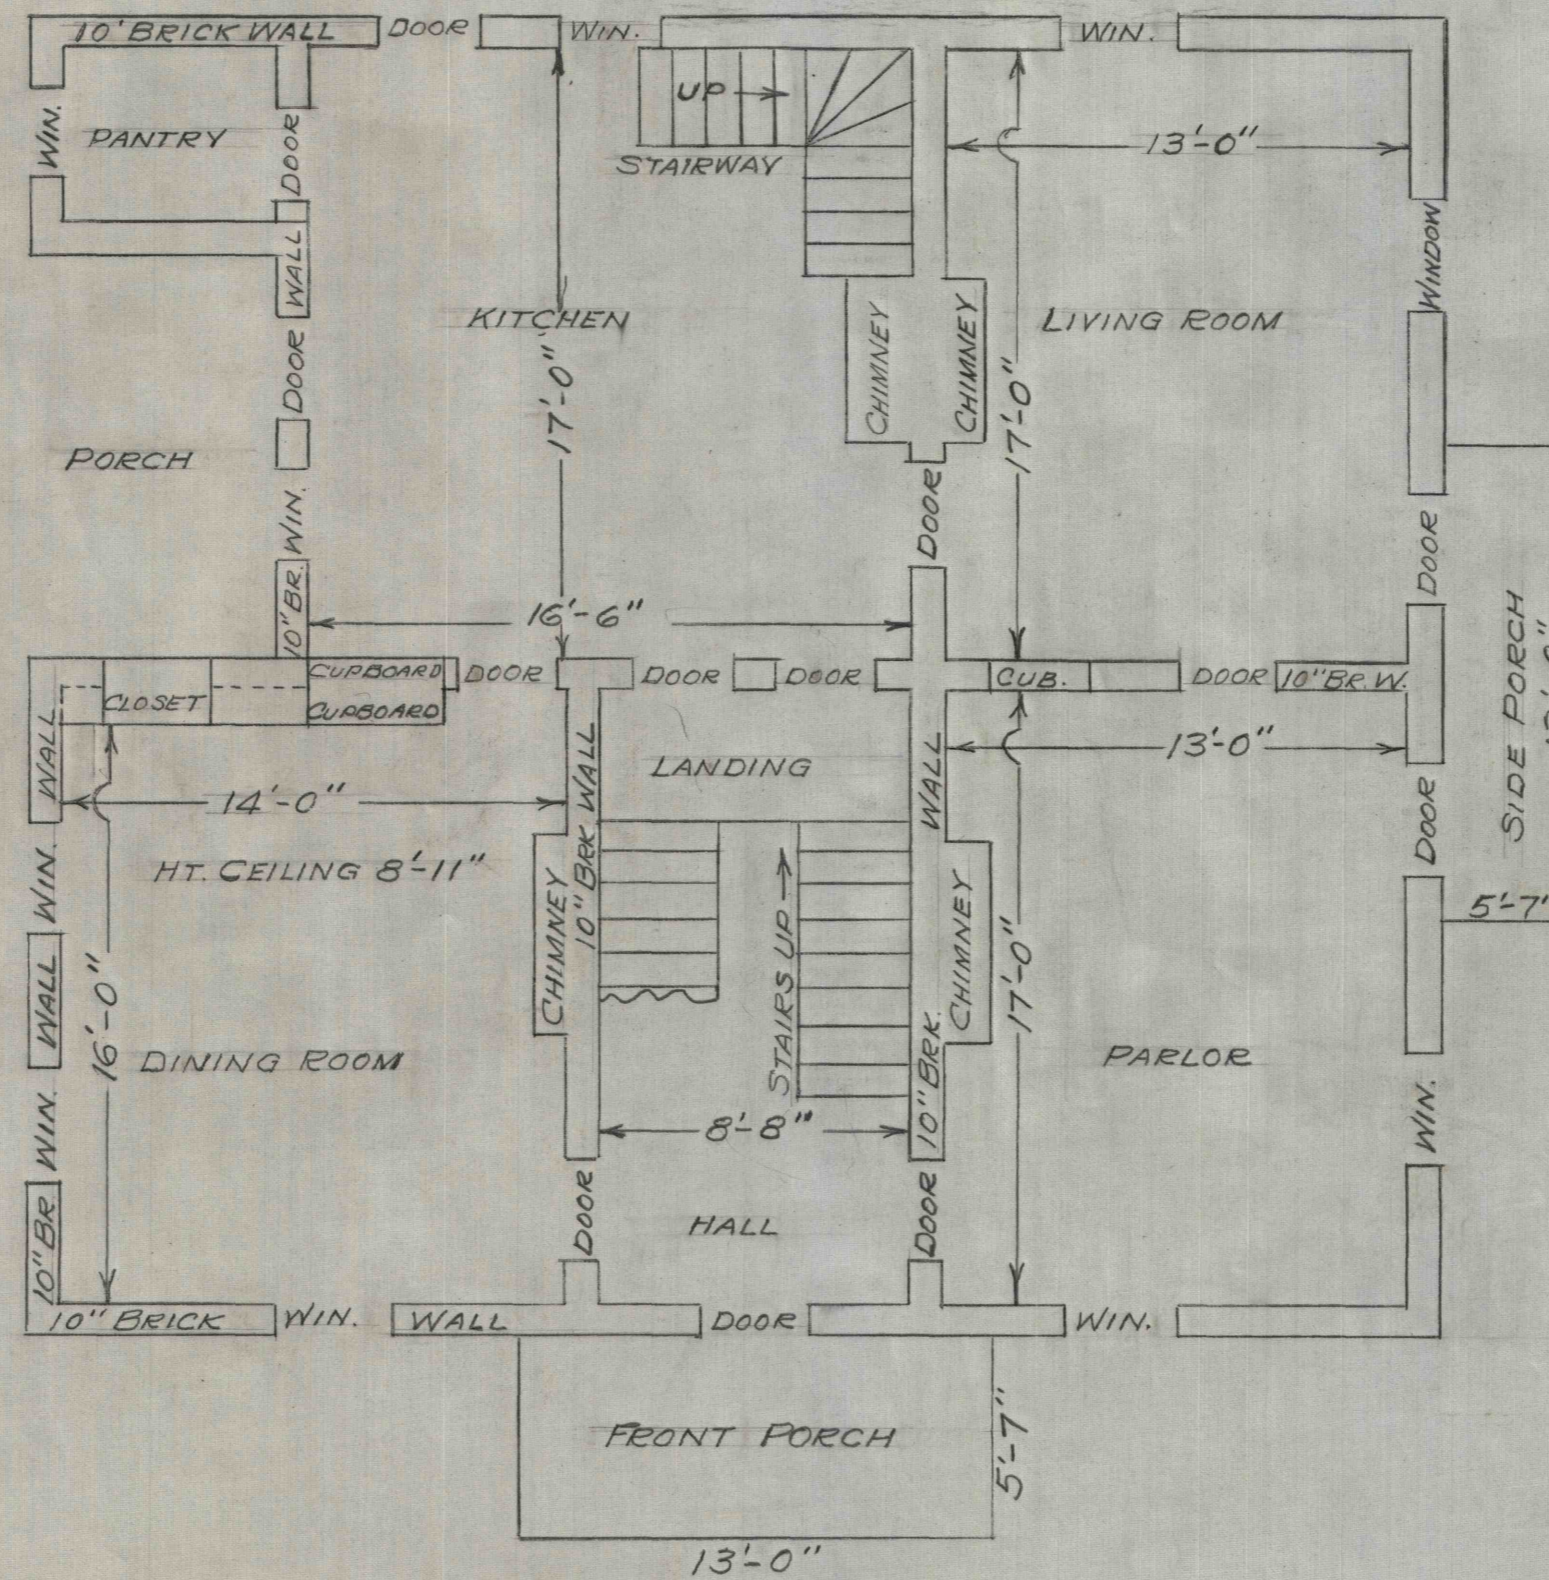

FRONT PORCH 5'-7"

13'-0"

FIRST FLOOR PLAN

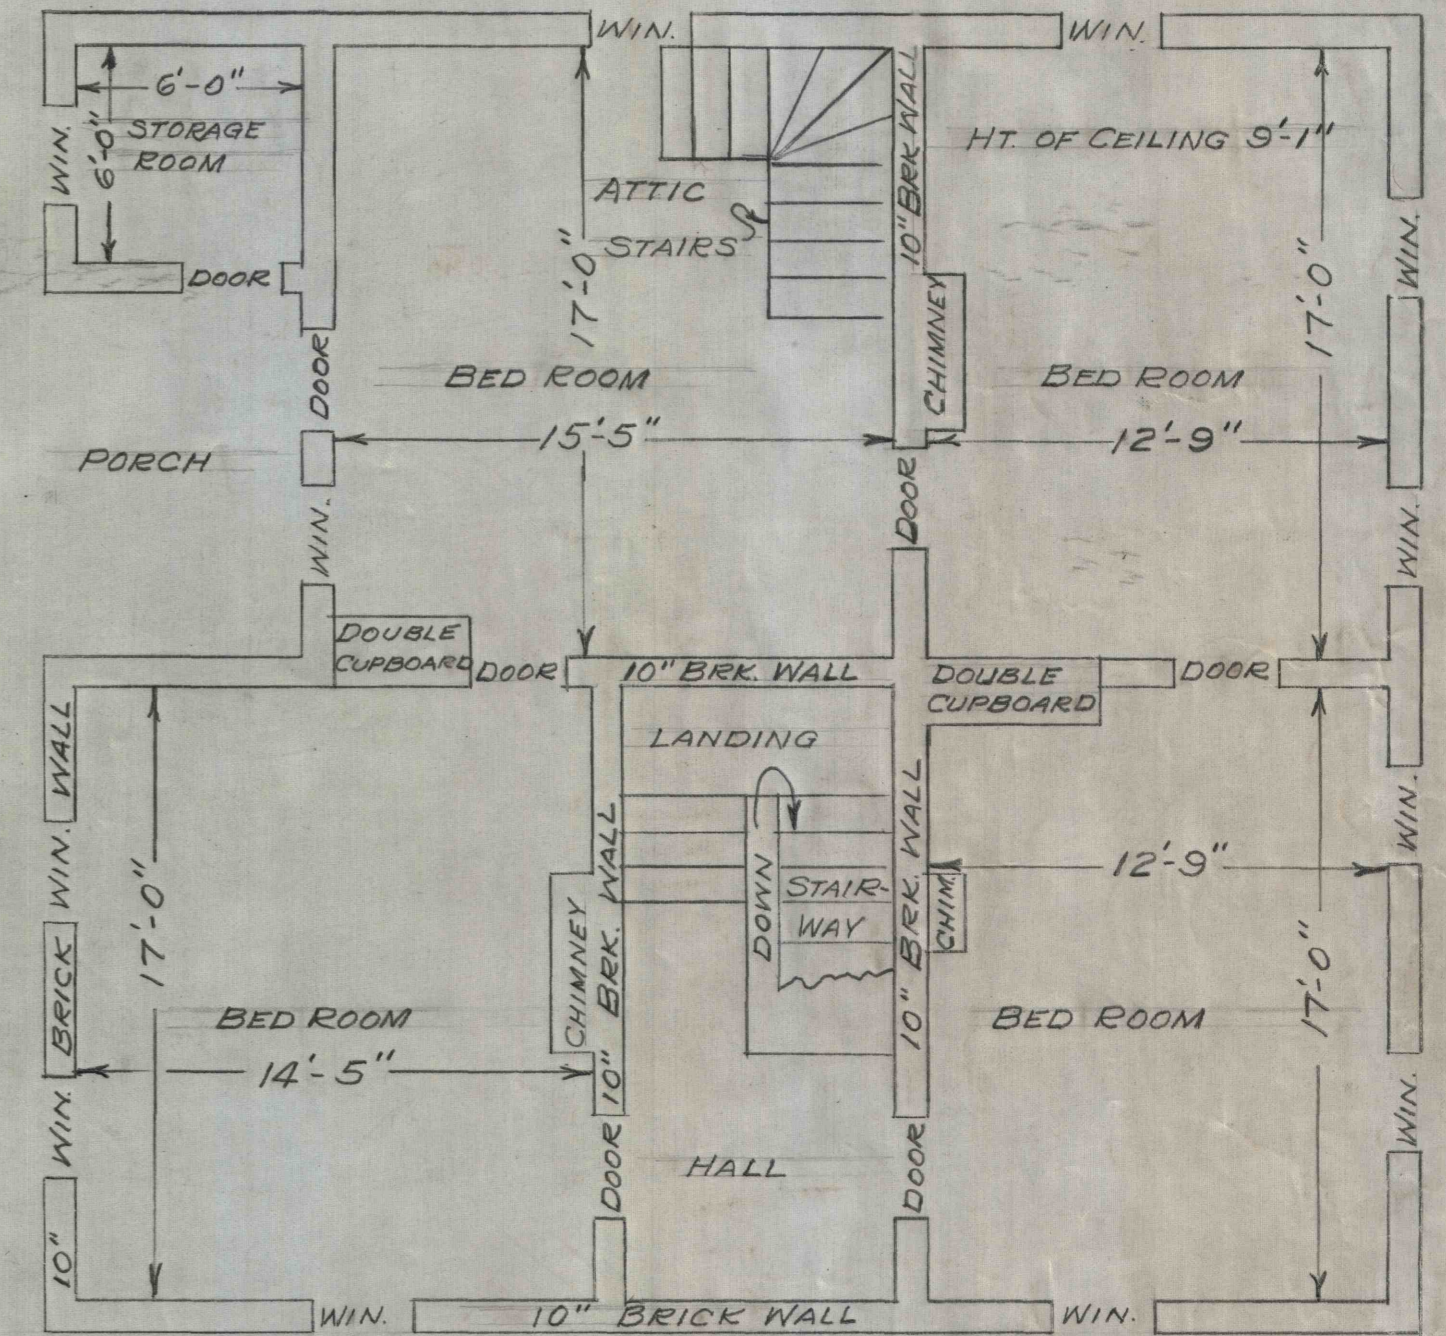

FRONT

SECOND FLOOR PLAN

PLAN OF FARM HOUSE  
ON KEEFOVER TRACT  
SCALE:  $\frac{3}{16}'' = 1'$  JULY 30, 1948  
Vesta Coal Co.

B-991