


*Map
of
Beswick Coal Exchange
between the
Penn Gas & Westmoreland Coal Co's.
Near
Manor Pa*

Scale 300'=1"

Nov 1 1907

NOTE:— THE LINE IN PENCIL SHOWS A DIVISION
ACRE FOR ACRE FOR 38.91⁴⁵ OF COAL
AND LEAVING A SPACE 95'⁰⁰ IN WIDTH
FOR INGRESS AND EGRESS.

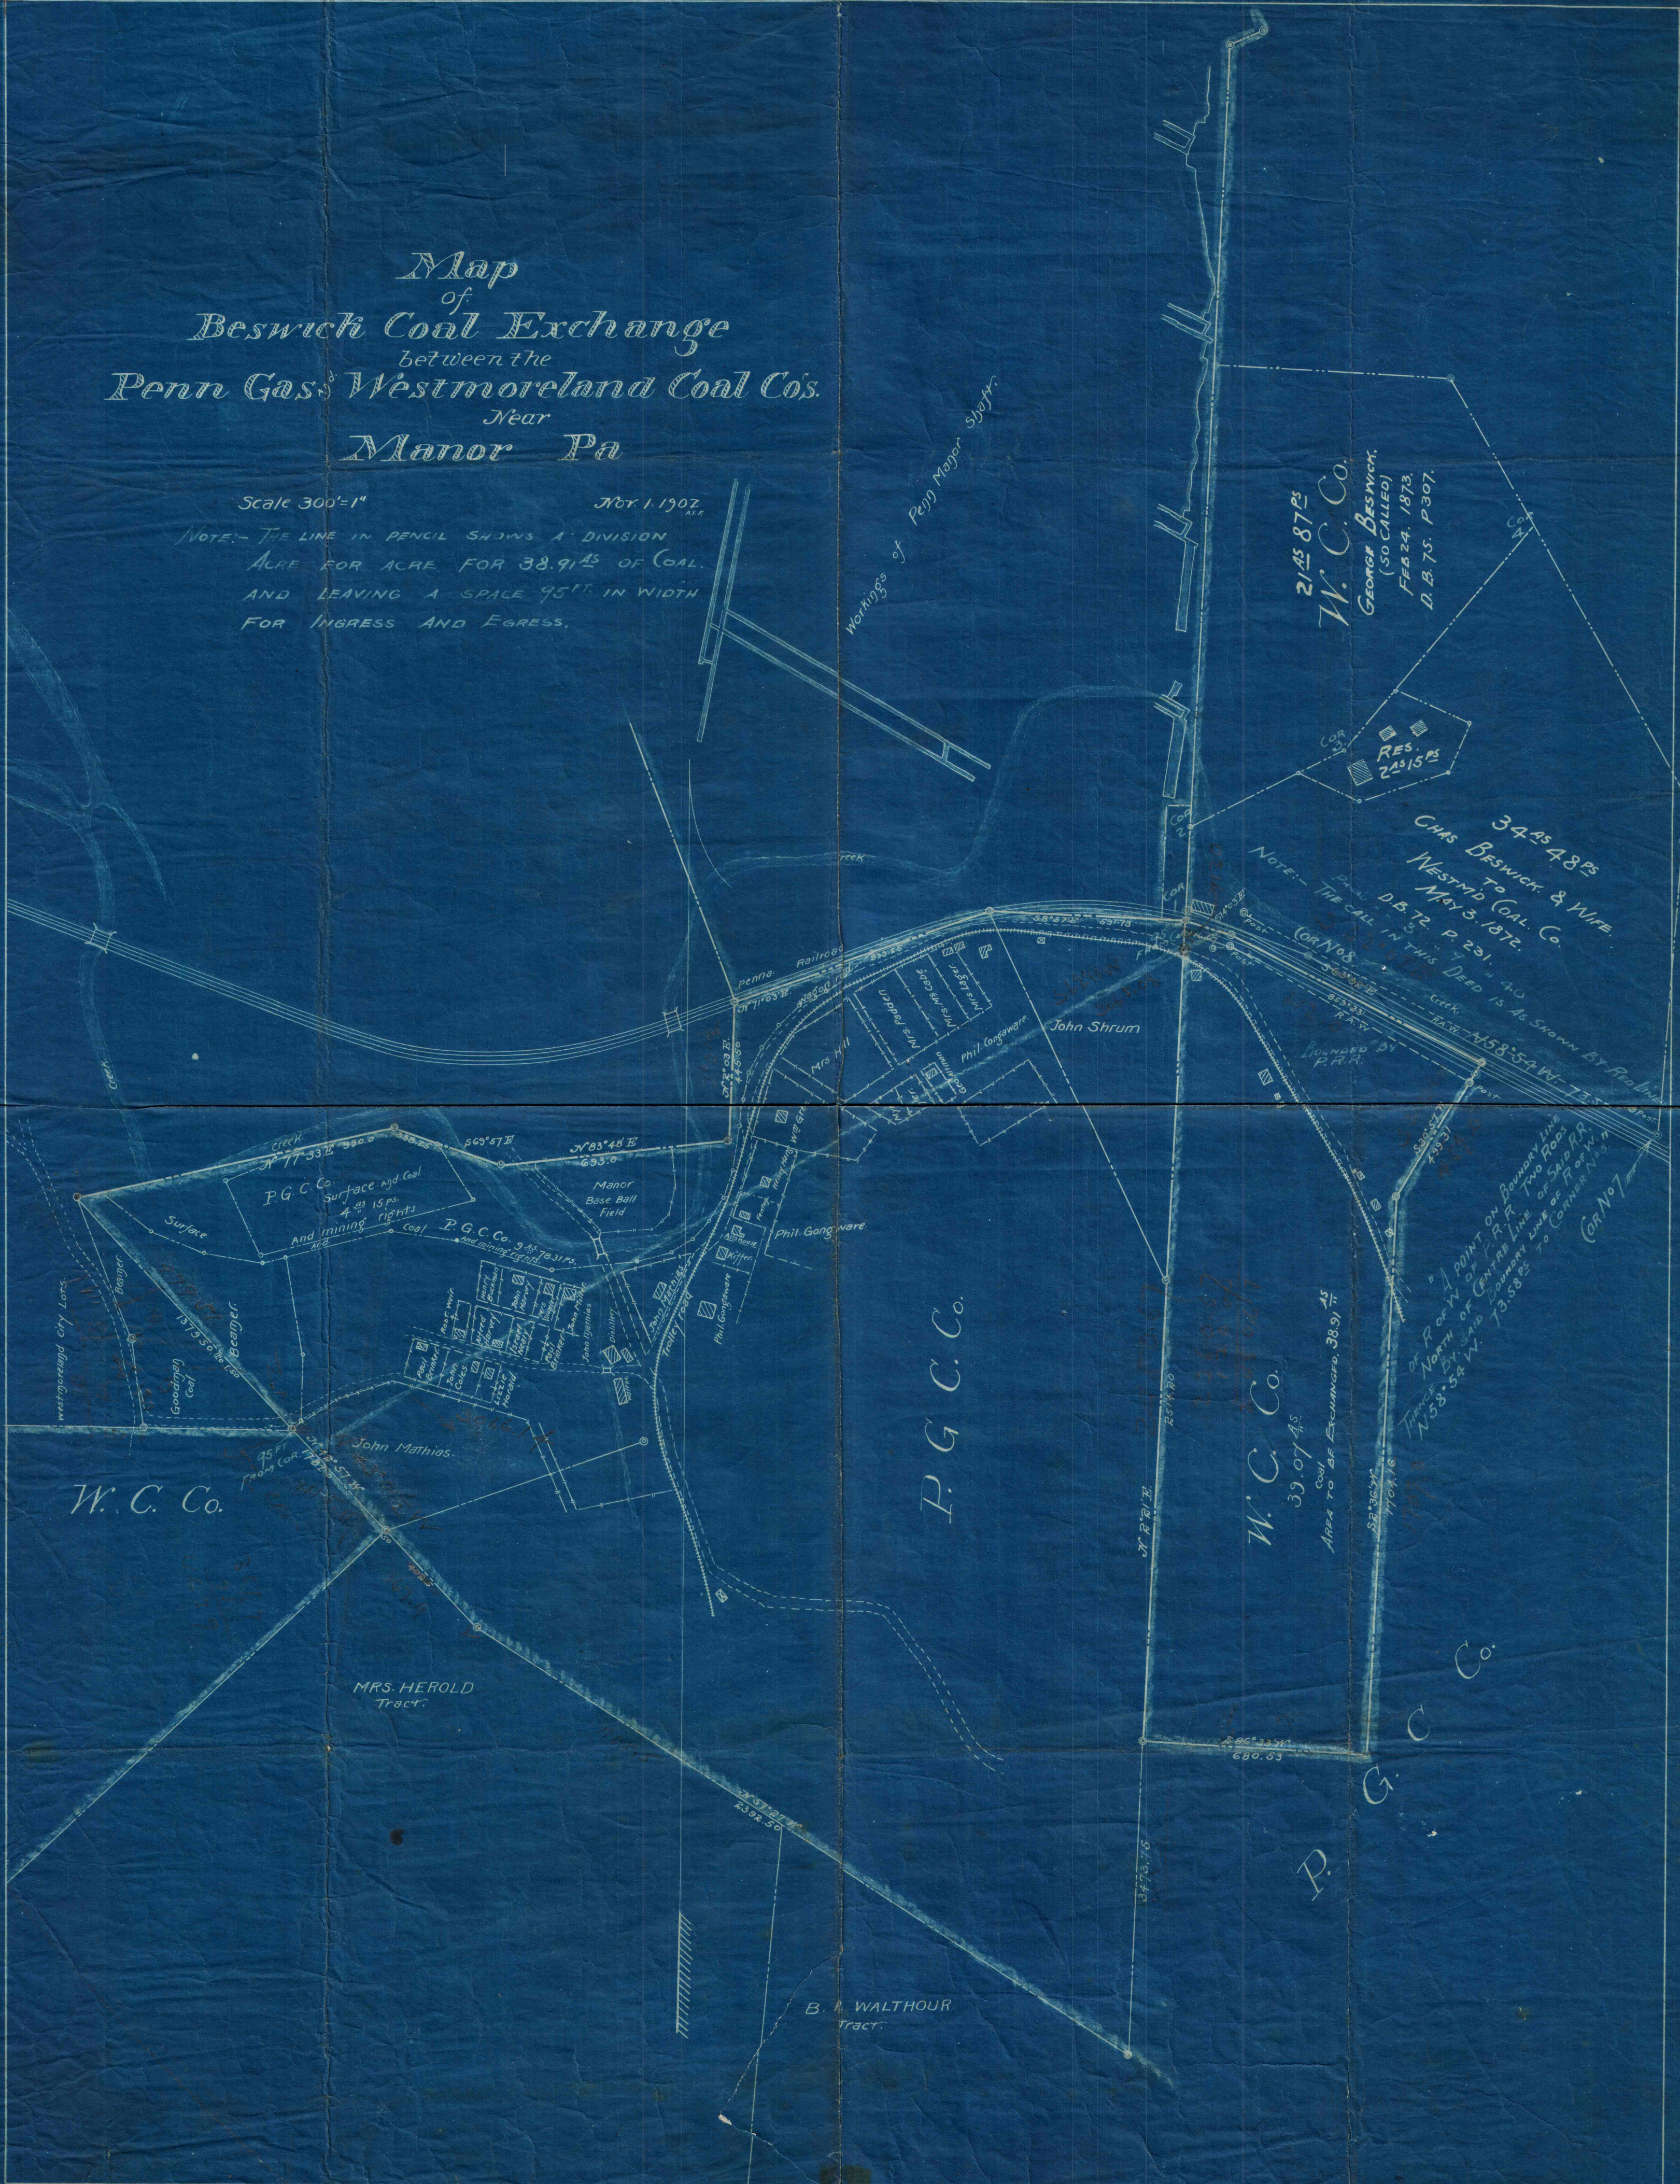

*21⁴⁵ 87⁴⁵
W.C. Co.
George Beswick
(SO CALLED)
FEB 24, 1873.
D.B. 75. P. 307.*

*RES.
24⁴⁵ 15⁴⁵*

*34⁴⁵ 48⁴⁵
CHAS BESWICK & WIFE
TO
WESTMD COAL CO.
MAY 3, 1872.
D.B. 72. P. 231.*

NOTE:— THE CALL IN THIS DEED IS AS SHOWN BY THE LINE
(COR No 8)

NOTE:— POINT ON RAILROAD LINE
NORTH OF CENTRE LINE OF SAID R.R.
THREE BY SAID LOWERY LINE OF SAID R.R.
N58° 54' W. 73.682' TO CORNER A13
(COR No 7)

W.C. Co.

P.G.C. Co.

*W.C. Co.
39,07⁴⁵
AREA TO BE EXCHANGED, 38.91⁴⁵*

*MRS. HEROLD
Tract.*

*B. A. WALTHOUR
Tract.*

Workings of Penn Major Shaft

John Shrum

John Mathias

Phil Goughware

Mrs Hill

Upper Run

Lower Run

Manor Base Ball Field

Manor










Westmoreland City Lots

Surface

*P.G.C. Co. Surface and Coal
And Mining rights
4⁴⁵ 15⁴⁵ ps.*

*P.G.C. Co. 9⁴⁵ 23⁴⁵ ps.
and mining rights*

Phil Goughware

Phil Goughware

