


SURVEY TO LOCATE  
BORE HOLES  
FOR DAMS IN #3 DIP ENTRIES  
SOUTH-SIDE  
ENG. DEPT. W.G.CO. SCALE 100'=1"

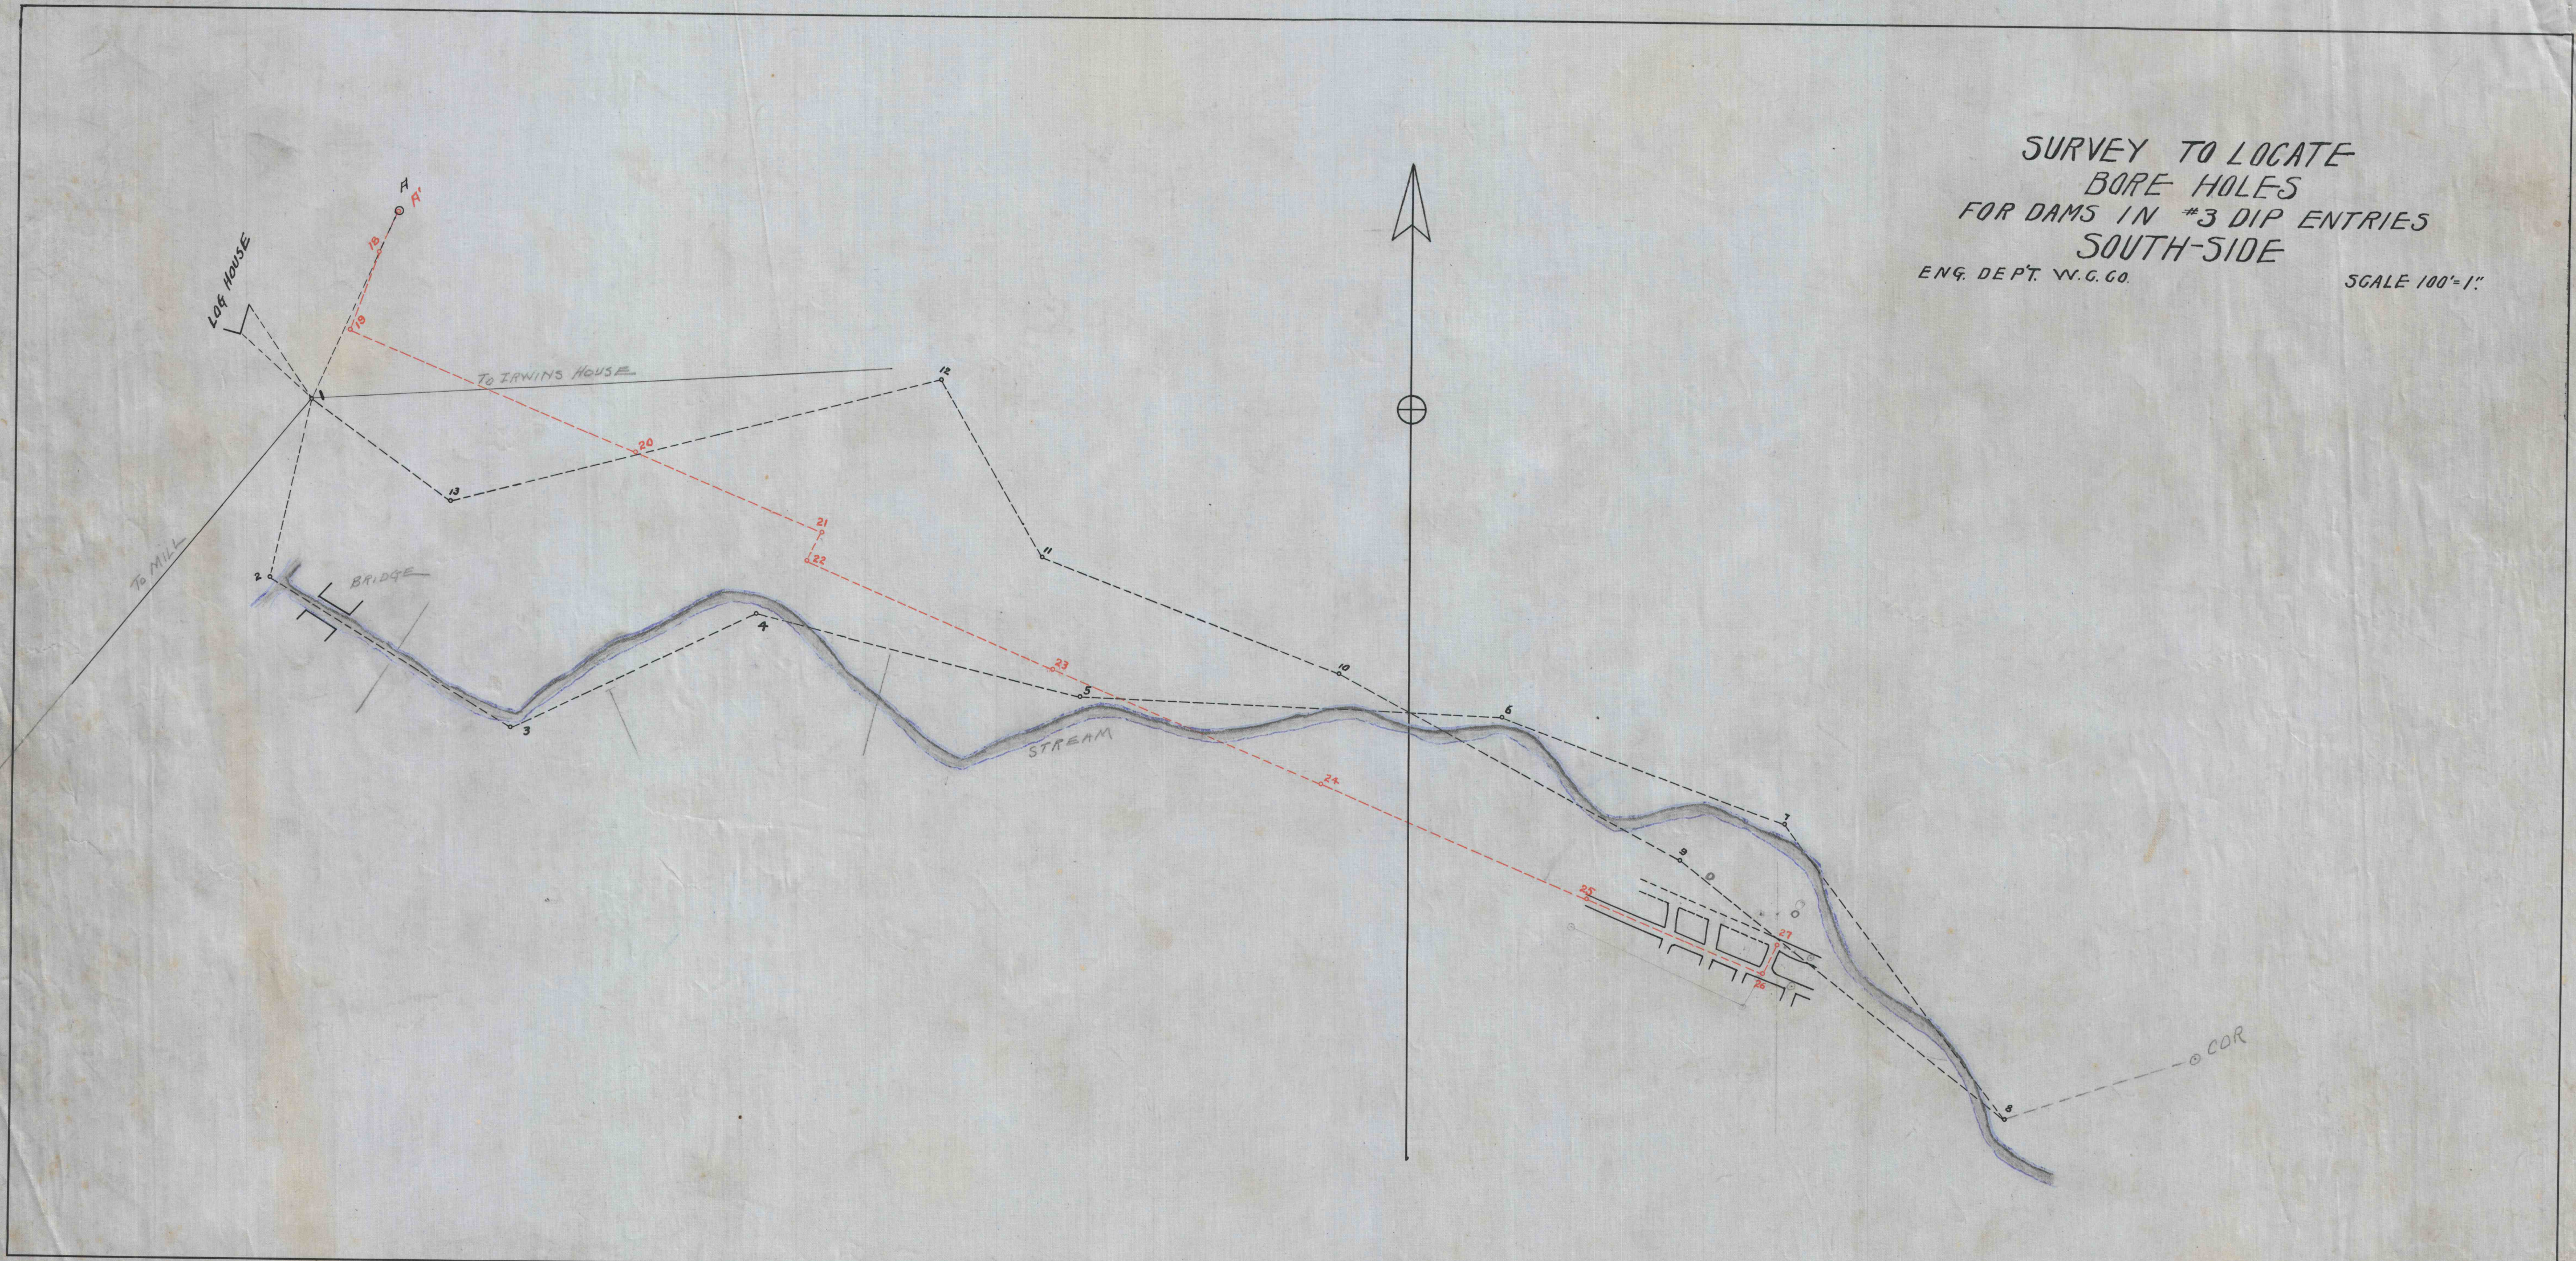

Roll 1169