


171111

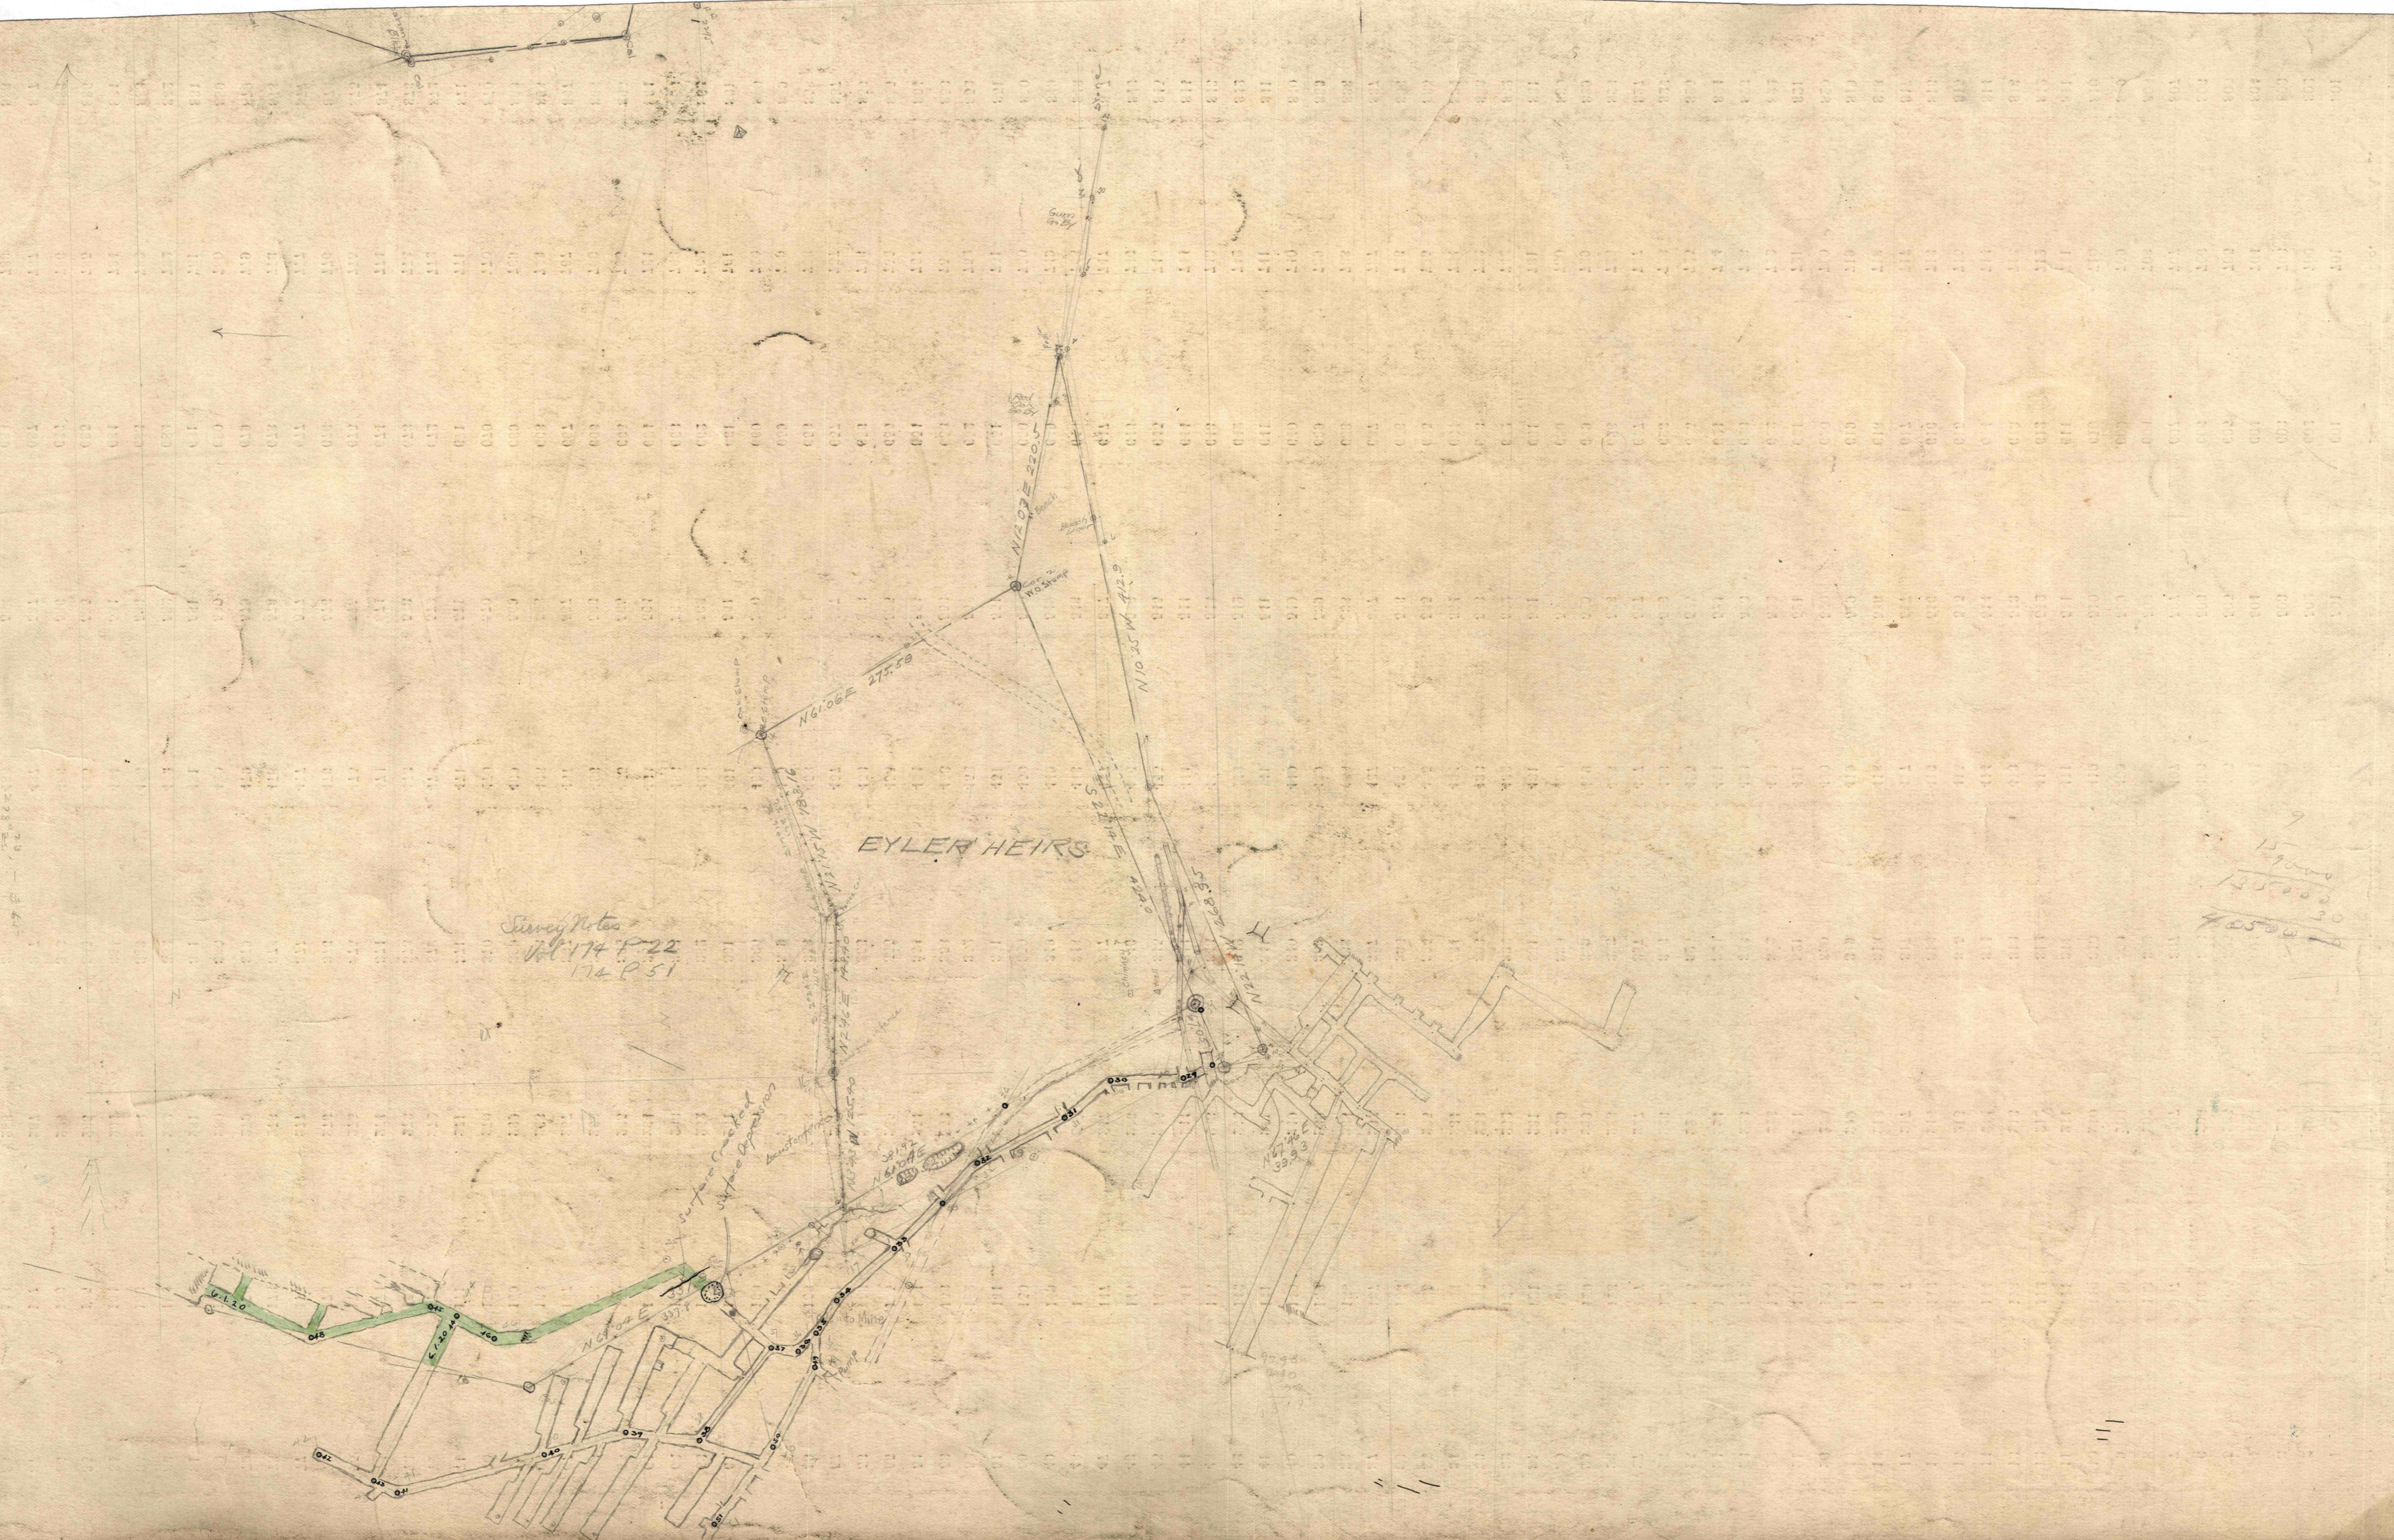

9
 15000
 135000
 30
 40500

1618

1648