

KEEP WITH C-21-1

PLAN OF LOTS

FOR

MARSHALL MCDONALD

SITUATED IN


MONONGAHELA CITY PA.

R.S.D. HARTRICK, C.E.

SCALE 50 FT. = 1 INCH

JULY 1892.

NOTE: FOR DISTANCES OMITTED ON THIS PLAN SEE TRAY-SHEET 332 CATSBURG AND BLACK DIA. OUTSIDE FOLDER VOL. 2.

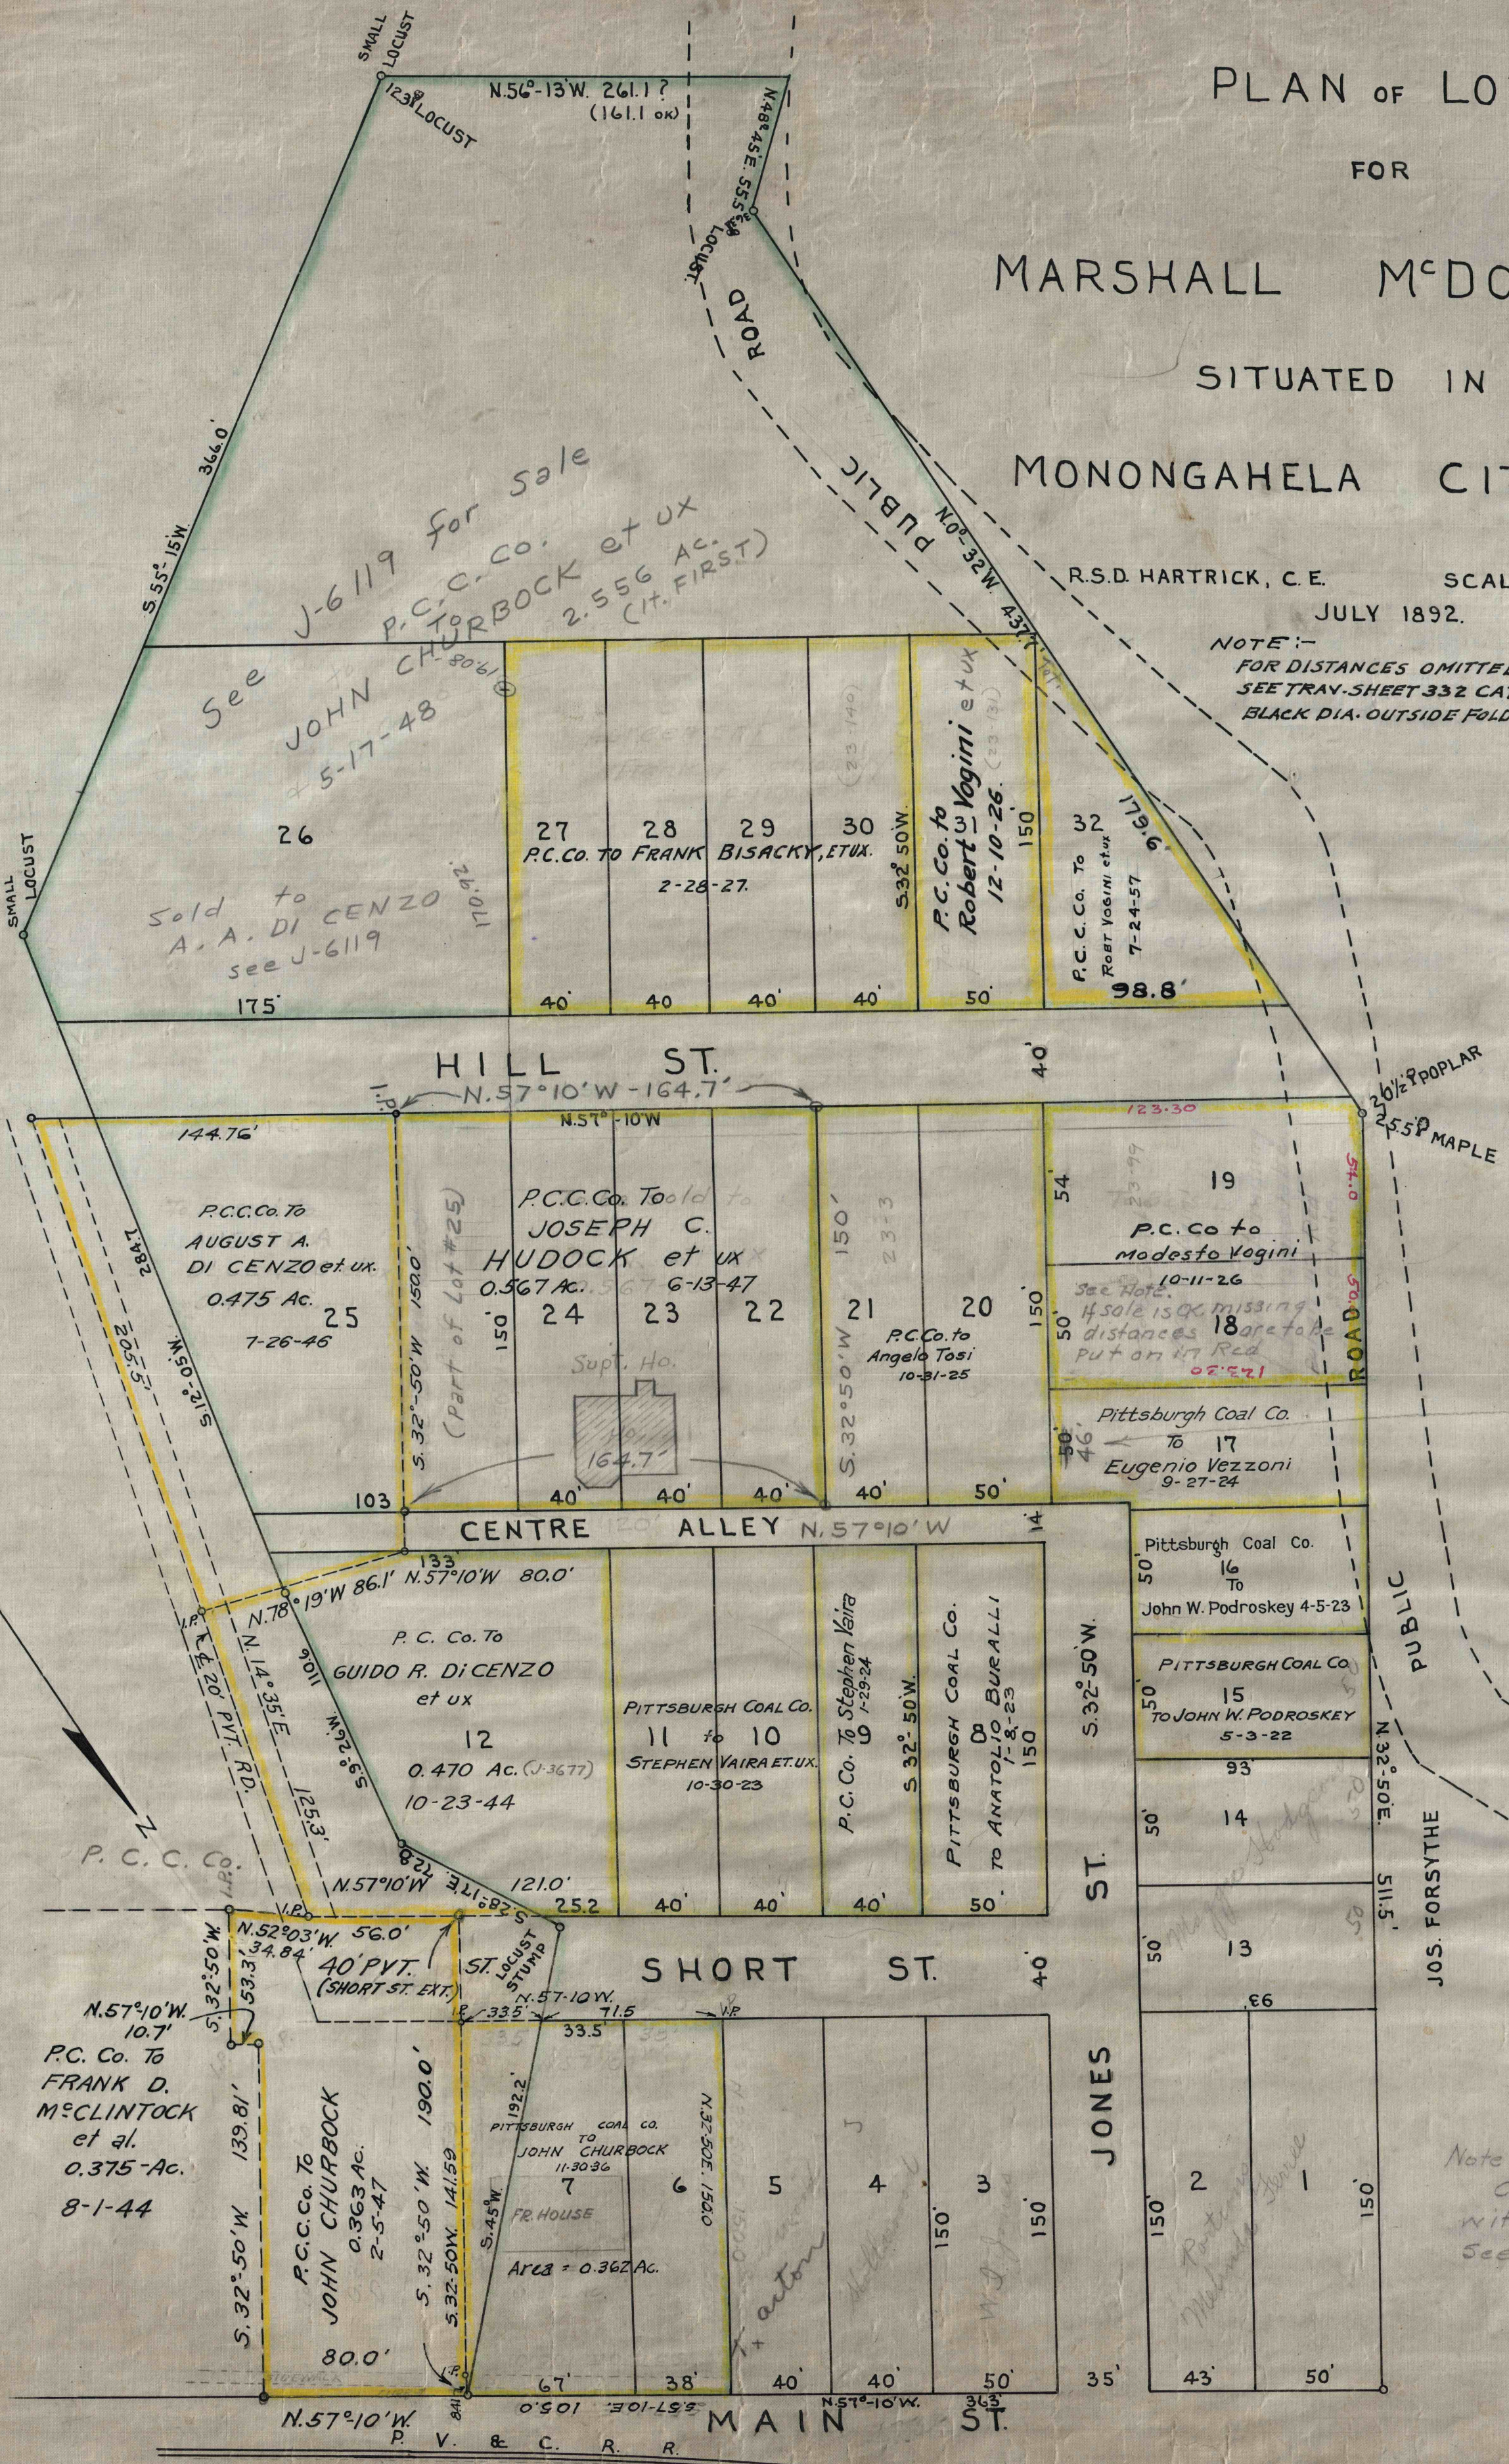

KEEP WITH C-21-1

Plat No. 1 page 1
Wash. Co.
Recorded Sept 16, 1892