

P.R.R.

# PLAN OF COAL

SURVEYED AT THE REQUEST OF  
**J. M. MILLER**  
NOV 1<sup>ST</sup> 1902  
BY W. F. MILLER

SCALE 1"=100'

ORIGINAL PLAN OF LOTS OF LUDWICK MILLER & BERLIN

MILLER & LANGHAM COAL  
19.479 ACRES


HARROLD SCHOOL LOT

MILLER & LANGHAM  
19.479 A

W.C. Co.

WESTMORELAND COAL CO.

WESTMORELAND COAL CO.

40 STREET  
N 62° 00' E 887.8

MILLER ST  
S 87° 26' W 1494.8

HIGH ST.

LOT 324

LOT 323

LOT 325

LOT 326



PART ST.

2<sup>ND</sup> SECOND

GOODMAN

Beamer

Goodman

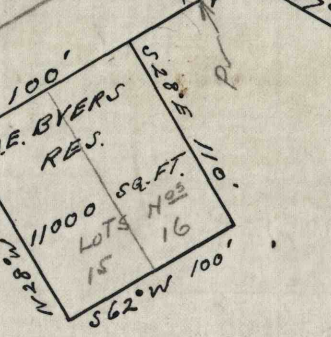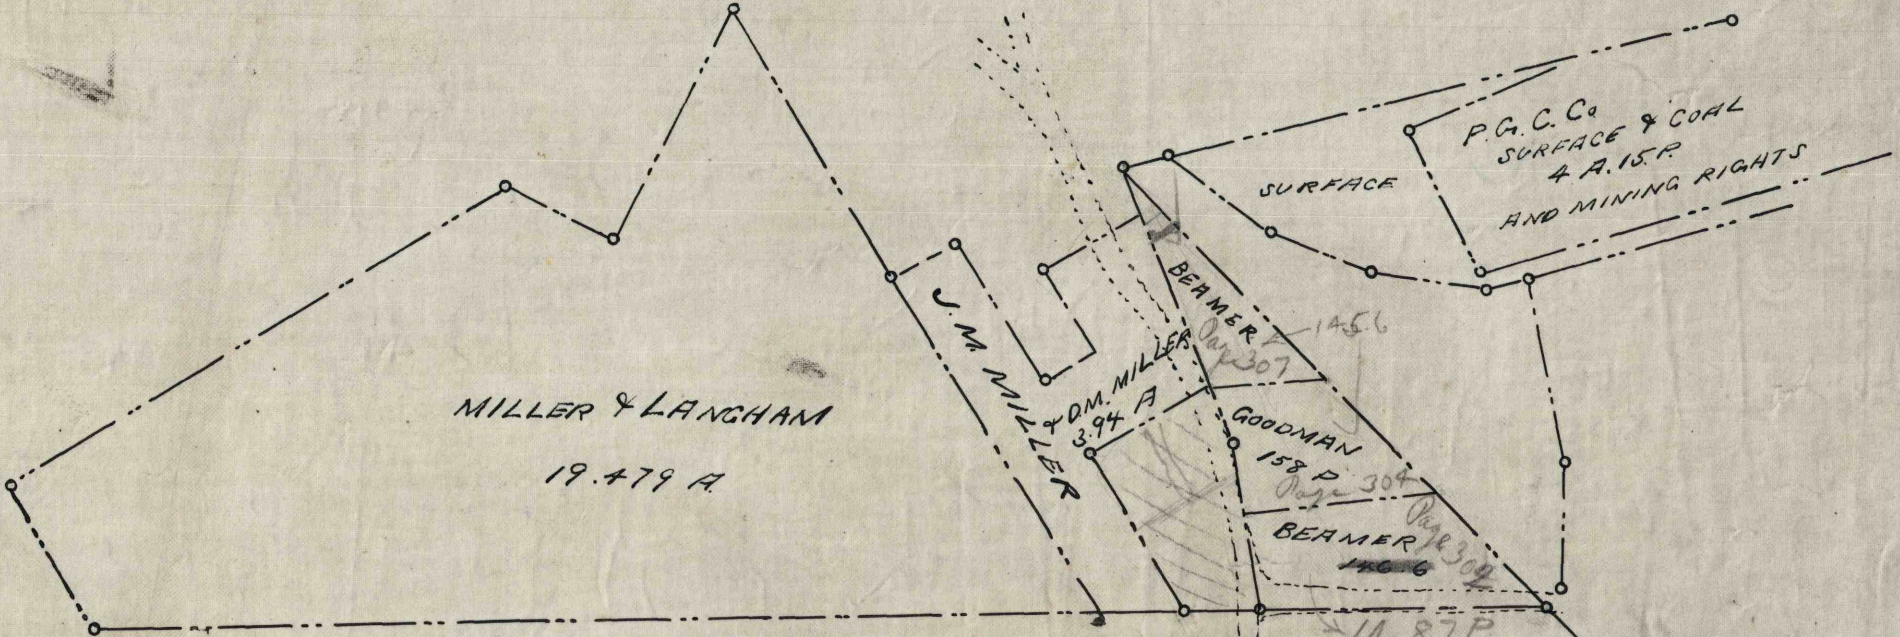

P.G.C. Co. SURFACE & COAL RIGHTS & MINING RIGHTS