
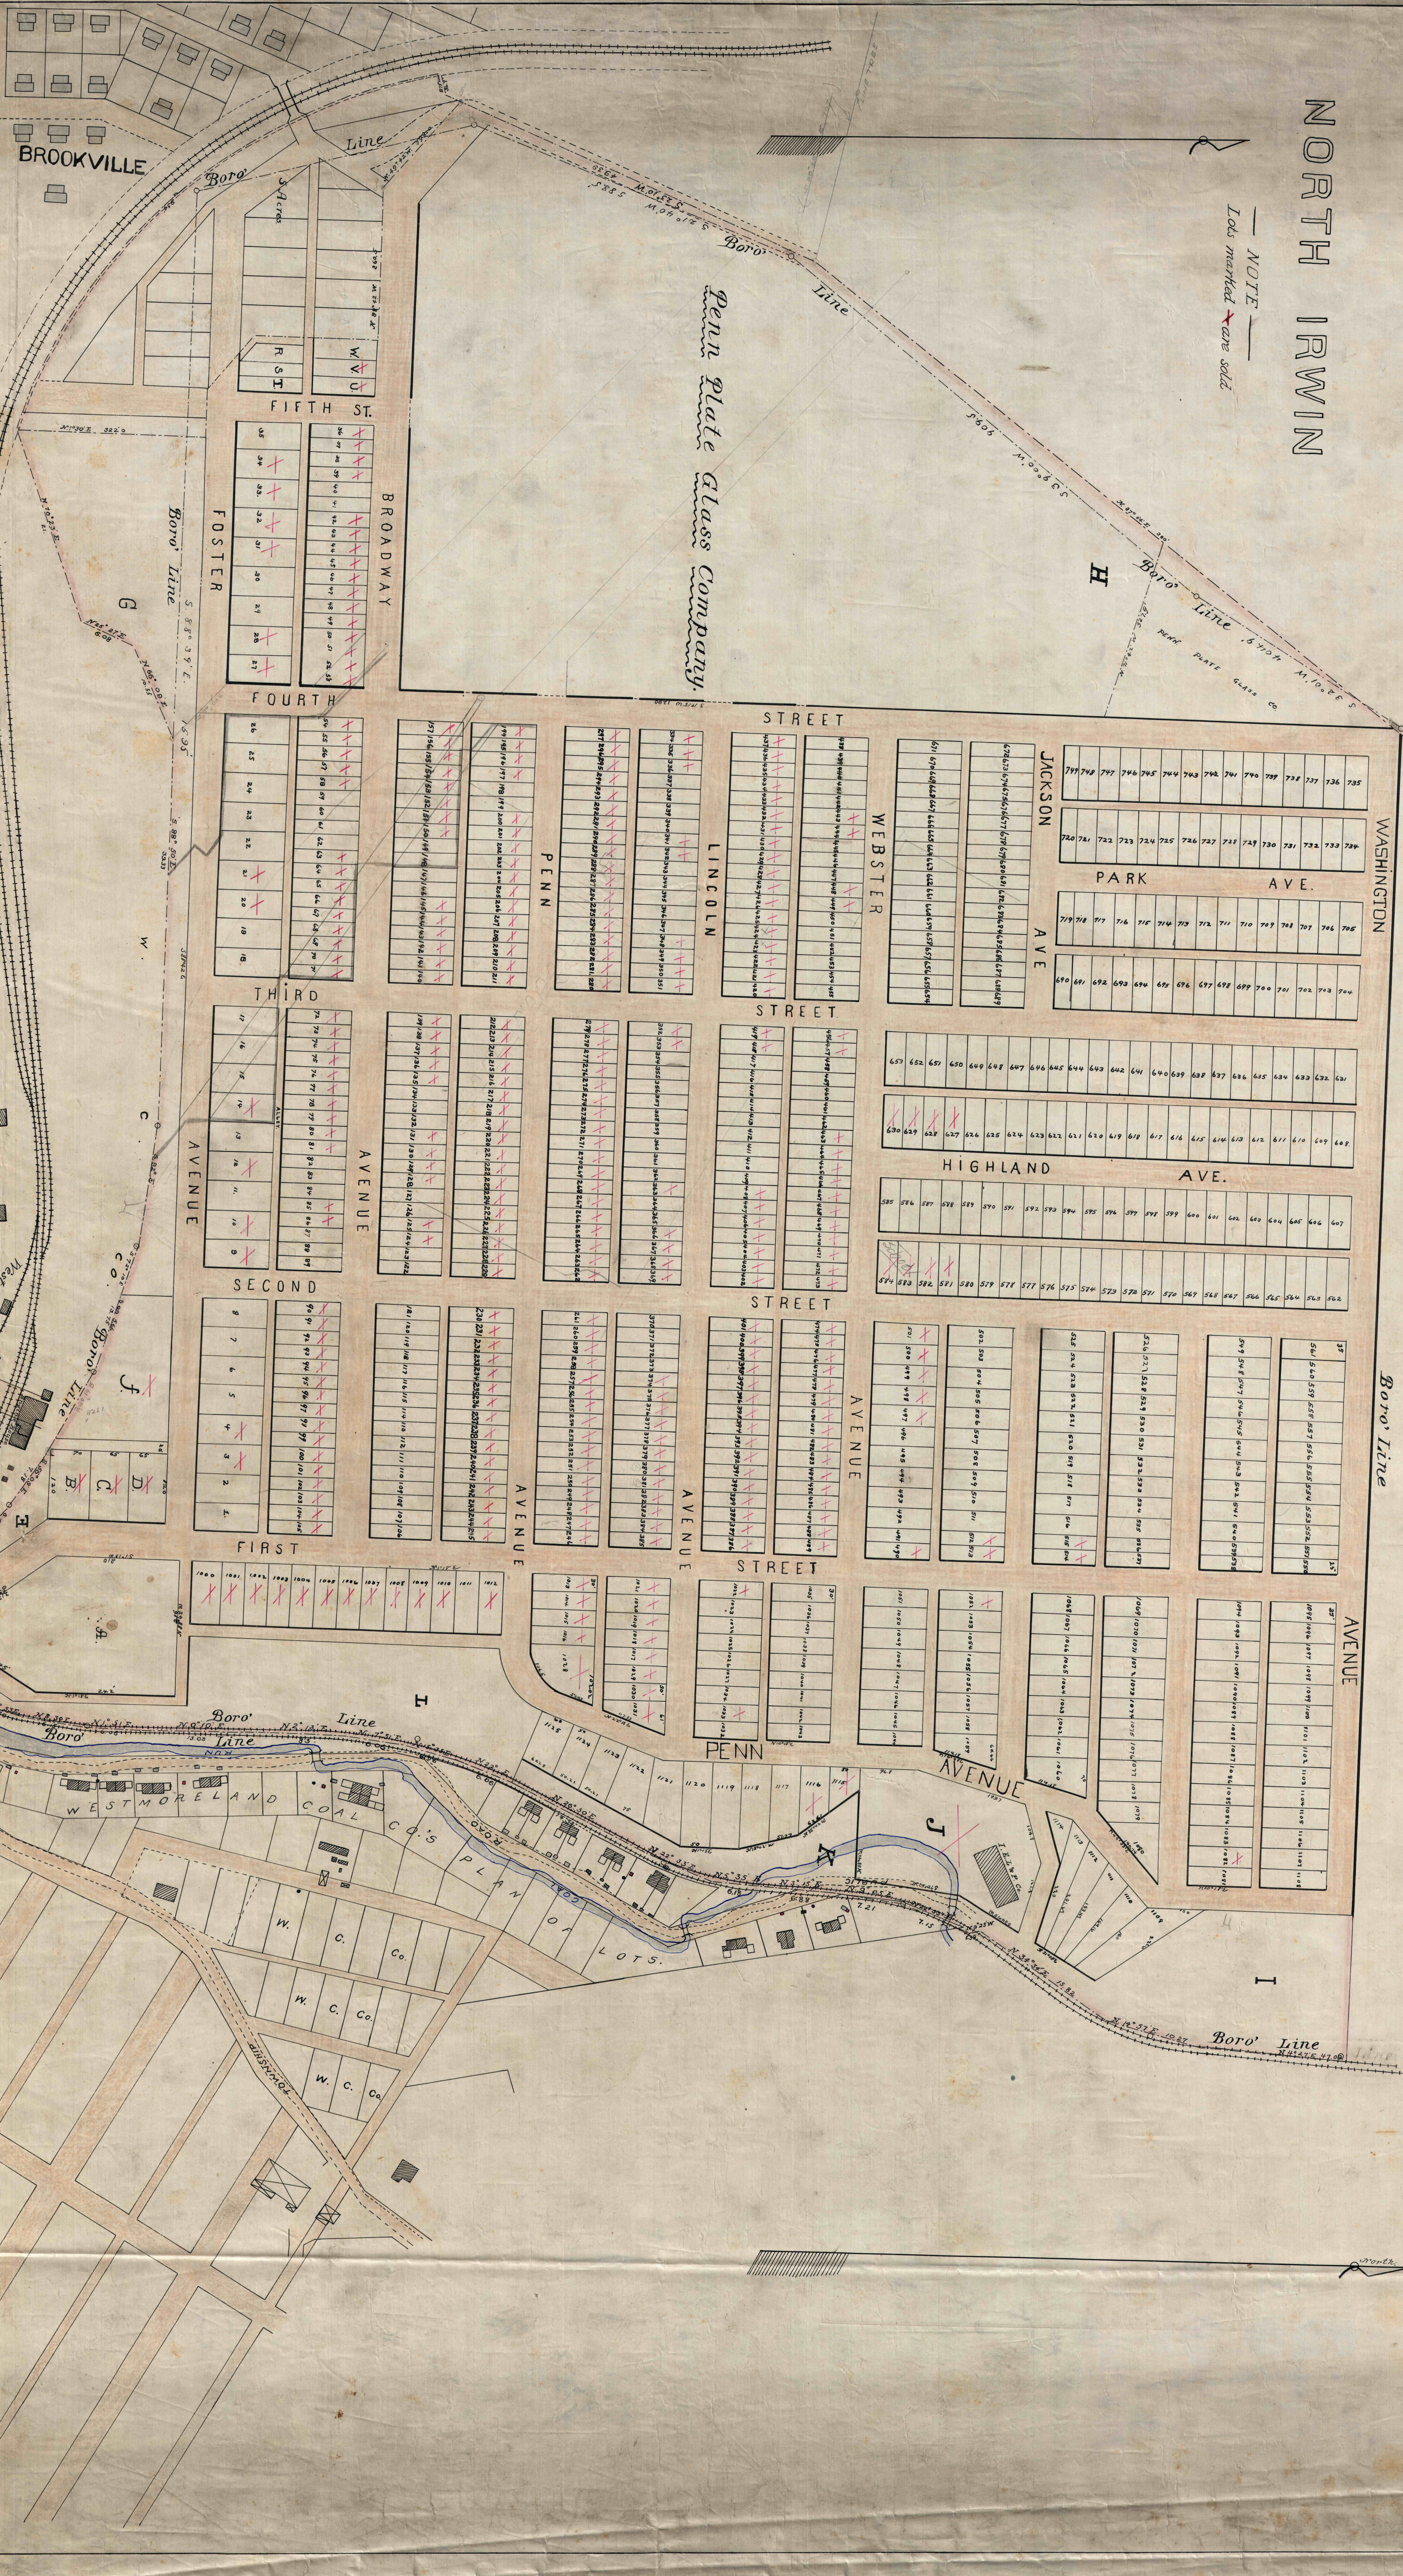


NORTH IRWIN

NOTE
Lots marked with X are sold

Penn Plate Glass Company

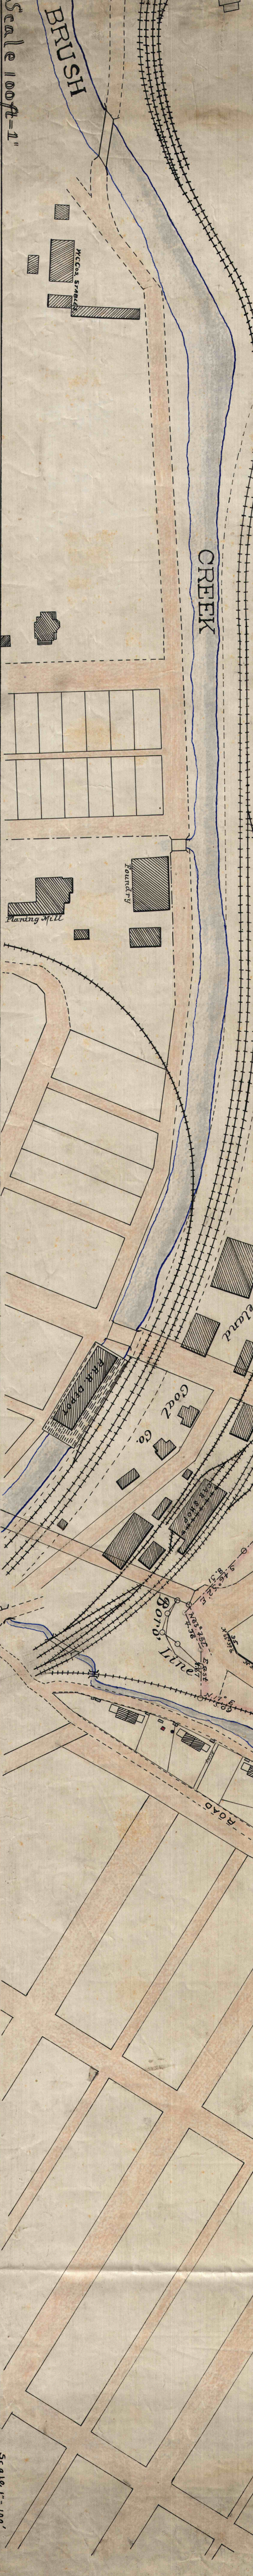

Scale 100ft=1"

Scale 100ft=1"