




MAGNETIC BEARINGS

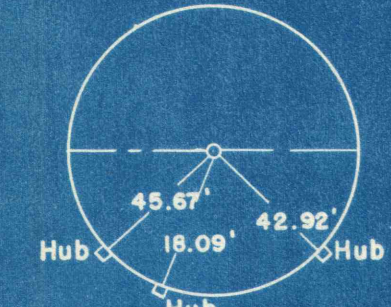


P.C. Sta. 62 + 67.47
Bk. 22861 Pg. 35

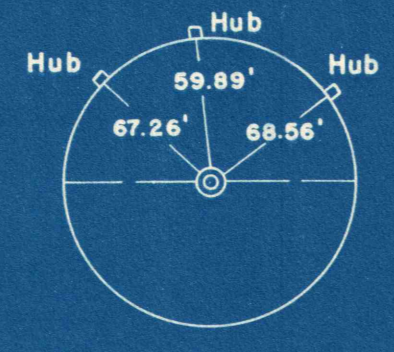

P.I. Sta. 67 + 23.09
Bk. 22861 Pg. 37
 $\Delta - 35^{\circ} 17' \text{ Rt.}$

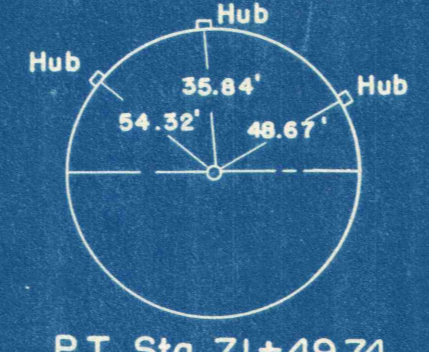

P.T. Sta. 71 + 49.74
Bk. 22861 Pg. 39

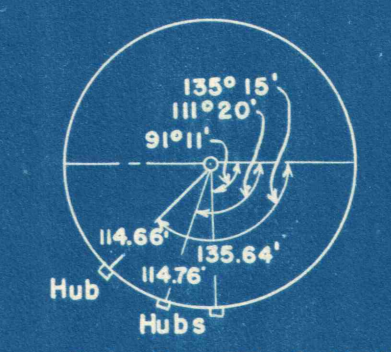

P.C. Sta. 75 + 04.74
Bk. 22861 Pg. 39

WILLIAM R. SMITH &
MARY E. SMITH (His Wife)
Irwin, Pa.

P.I. Sta. 77 + 76.45
 $\Delta - 46^{\circ} 11' \text{ Lt.}$
 $D - 9^{\circ} 00'$
 $R - 637.27'$
 $T - 271.71'$
 $L - 513.67' \text{ (Arc)}$
Bk. 22861 Pg. 41

WILLIAM R. SMITH &
MARY E. SMITH (His Wife)
Irwin, Pa.

P.I. Sta. 67 + 23.09
 $\Delta - 35^{\circ} 17' \text{ Rt.}$
 $D - 4^{\circ} 00'$
 $R - 1432.69'$
 $T - 455.62'$
 $L - 882.27' \text{ (Arc)}$
Bk. 22861 Pg. 37

