


The PITTSBURGH COAL LAND COMPANY
hereby adopts this PLAN of LOTS,
Witness the Common and Corporate
Seal of said Corporation duly attested
by its President and Secretary this
3rd Day of April A.D. 1916.

By: W. K. Field
President
Attest: W. K. Field
Secretary

STATE OF PENNSYLVANIA)
COUNTY OF ALLEGHENY) SS

On the 3rd Day of April A.D. 1916 Before me
the Subscriber a Notary Public in and for said County
and State, personally appeared: F. J. LeMoine
Secretary of the said PITTSBURGH COAL LAND COM-
PANY who being duly sworn according to Law says that
he was personally present at the execution of the adop-
tion of the PLAN of LOTS, attached hereto, and saw the
Common or Corporate Seal of said Corporation duly affixed
thereto, that the seal so affixed thereto is the common or
corporate seal of the said Corporation, that the said
adoption of PLAN of LOTS was duly sealed and delivered
by W. K. Field President of said Corpora-
tion as and for the adoption of the PLAN of LOTS
offered said Corporation for the uses and purposes
therein mentioned. And that the name of this de-
ponent as Secretary and of W. K. Field
President of said Corporation subscribed to the
said adoption in attestation of its due execution and
delivery, are of their and each of their respective
handwriting.

Sworn to and subscribed Before me the day and Year
aforesaid WITNESS my hand and Notarial Seal.

Robert G. Schmidt
Notary Public

My Commission Expires January 21, 1919

SECTION "B"

CLARKSVILLE PLAN OF LOTS

LAID OUT BY THE

PITTSBURGH COAL LAND CO.

SITUATE IN

PENN TWP ALLEGHENY CO. PA.


SCALE 1"=100' FEB. 1916

TRAJZET'S B
See Plan B-516-D-7

File # 517

Allegheny County) SS.
Recorded in Recorder's Office
in said County in Plan Book Vol. 27 Pages 82-83
Given under my hand and seal this 11th day
of May A.D. 1916
John A. Williams
Recorder

Note -
Names in parcel maps
with whom agreements have
been made to sell
4/17/16

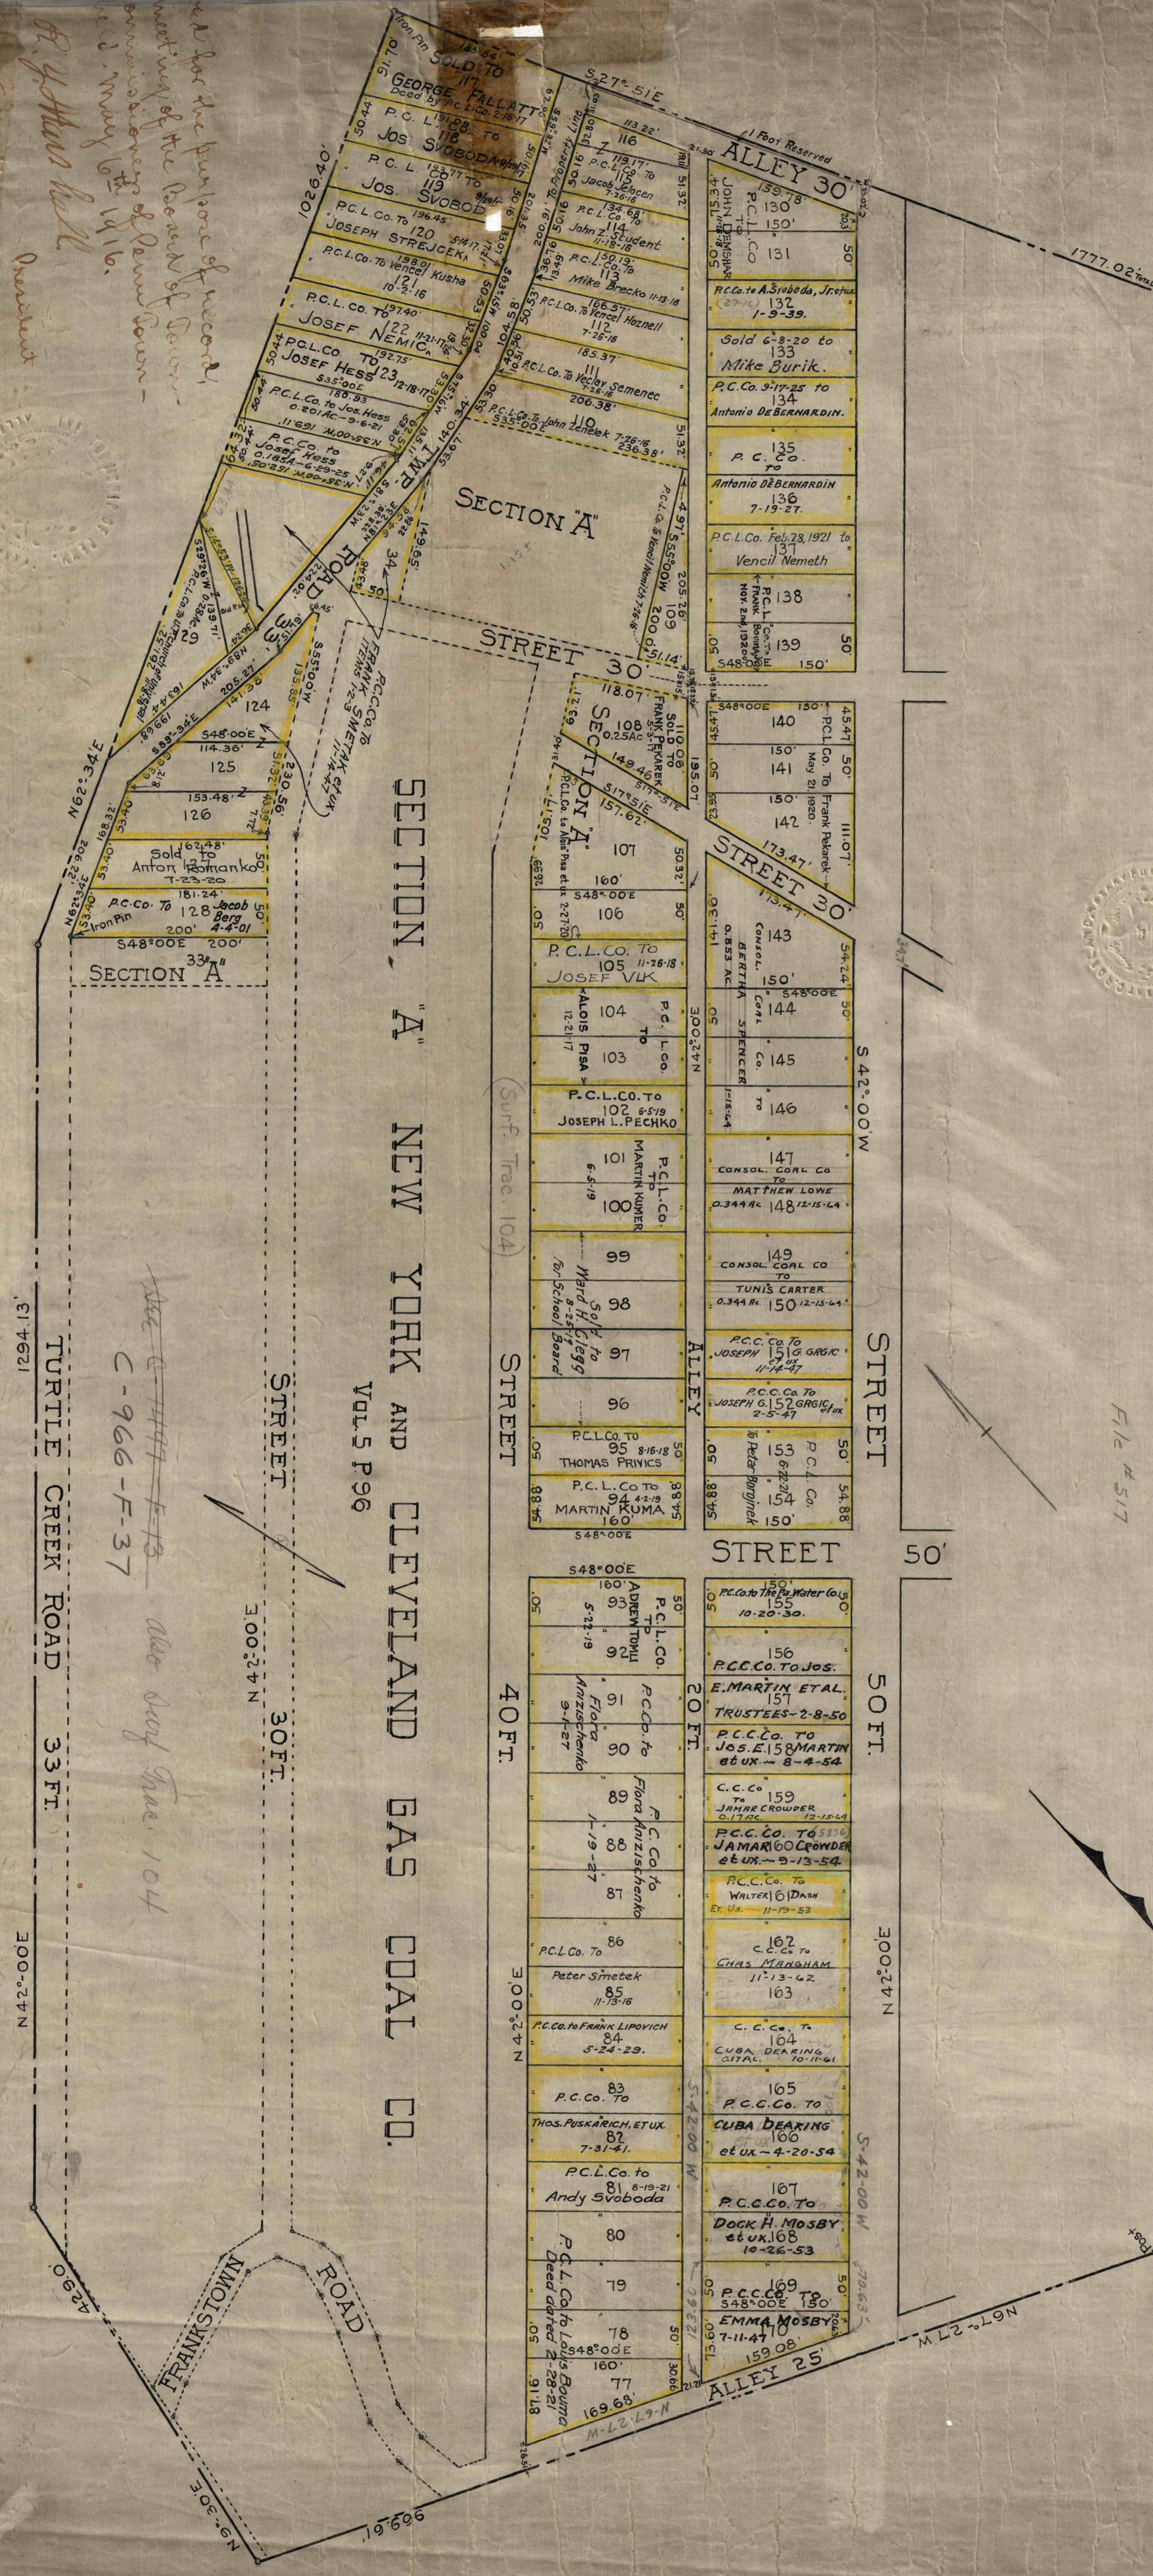

Approved for the purpose of record
R. J. Adams
President

C-966-F-37

C-2040-33