
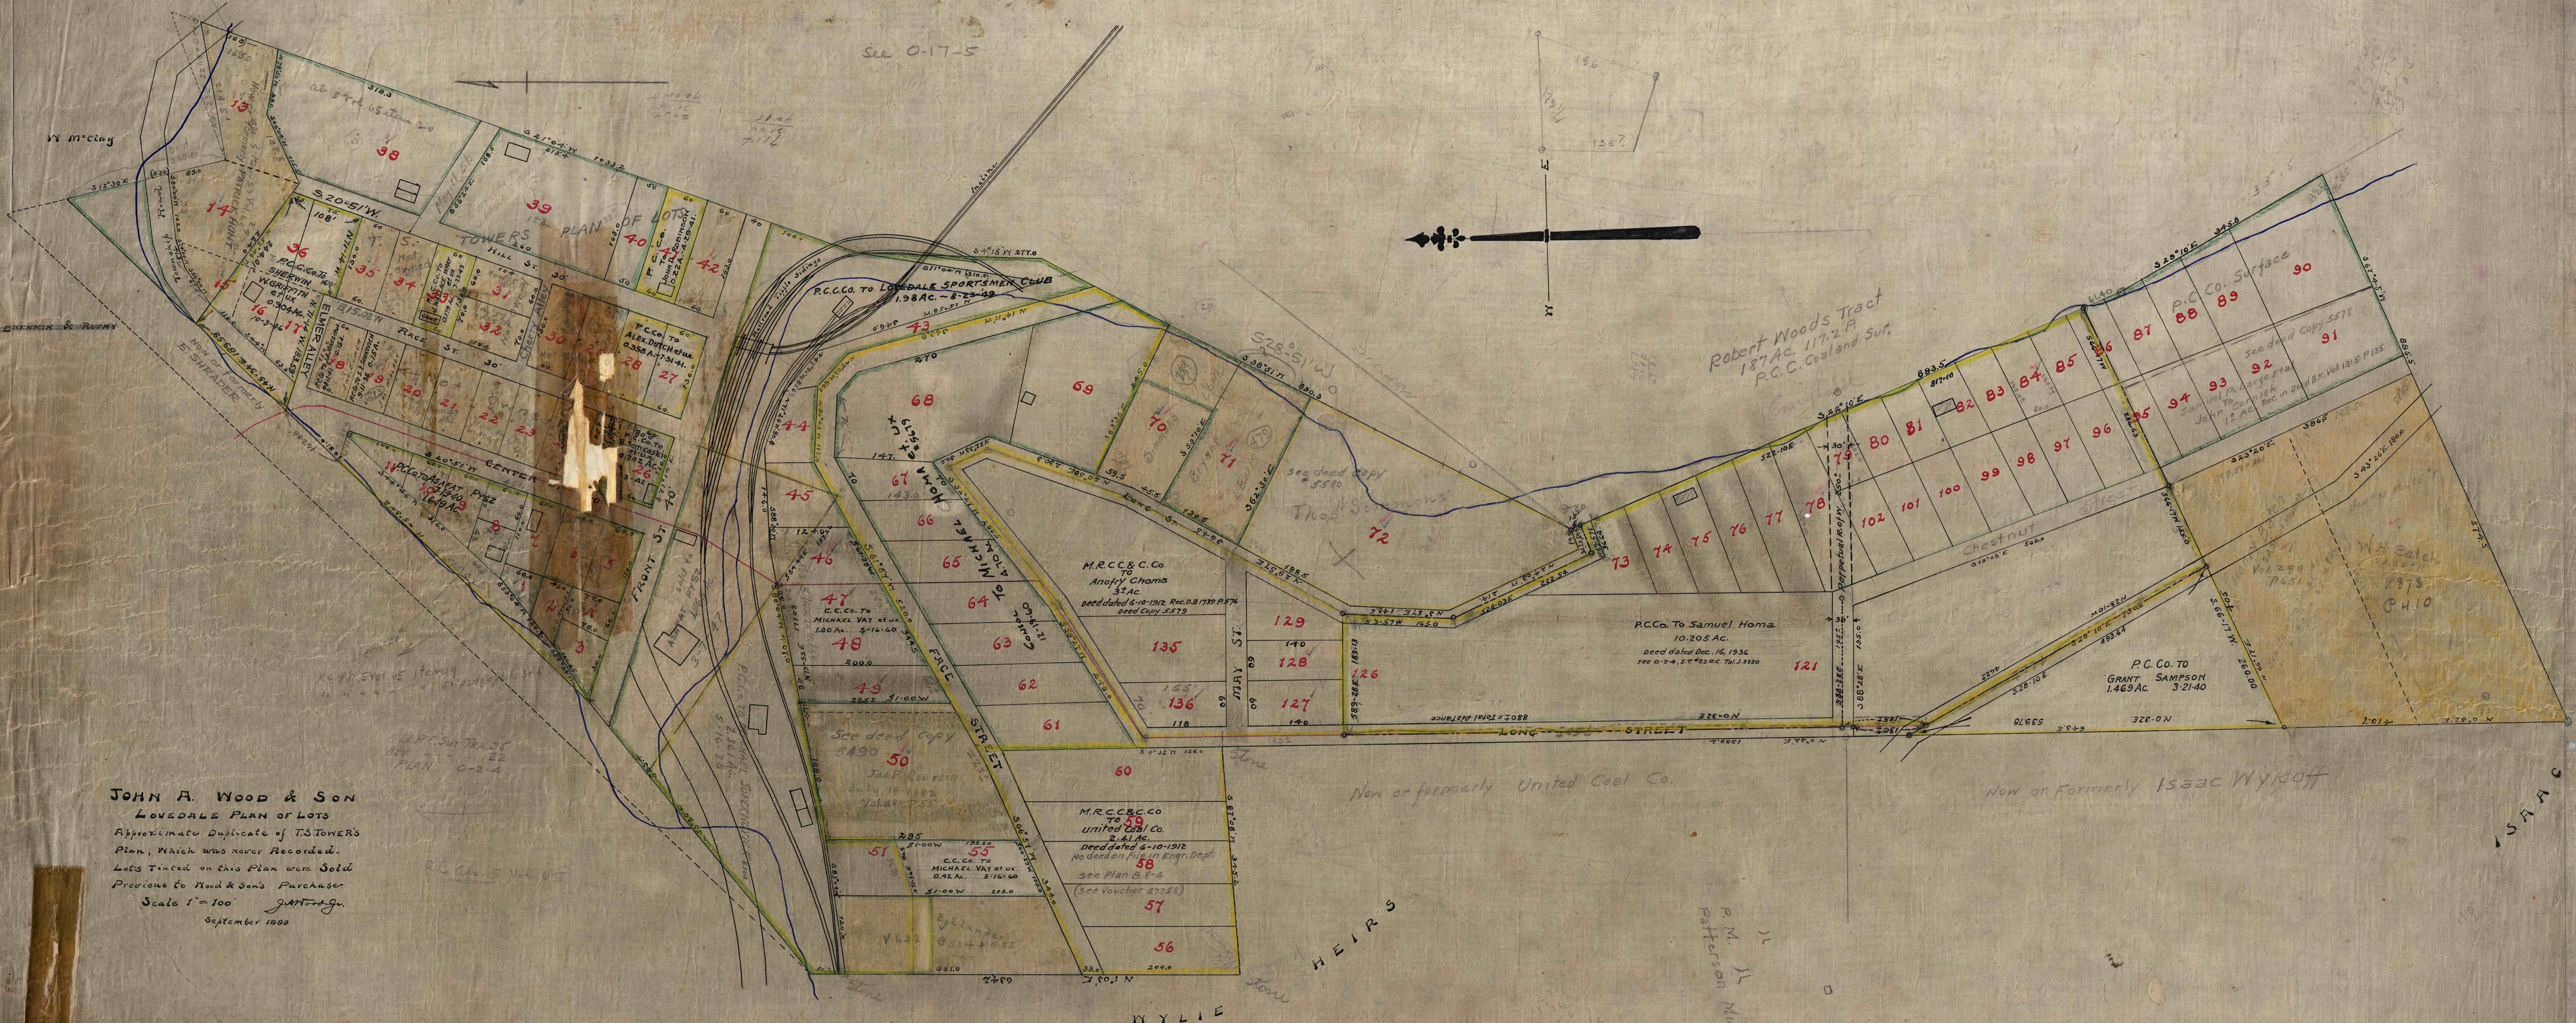


See O-17-5

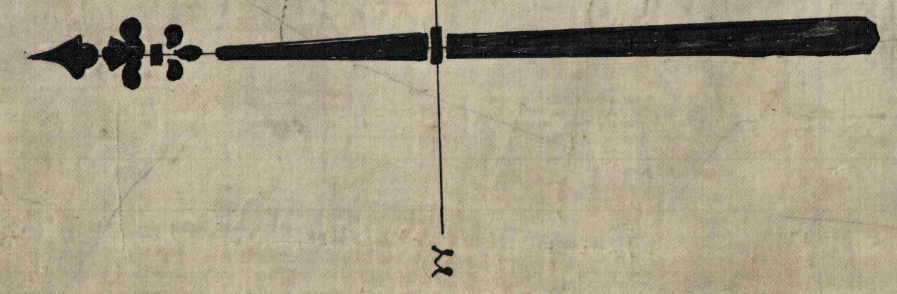

JOHN A. WOOD & SON
LOVEDALE PLAN OF LOTS
Plan, which was never Recorded.
Lots tinted on this Plan were Sold
Previous to Wood & Son's Purchase.
Scale 1" = 100' J.A.W. & S.
September 1889

R.C. Co. 5 Vol 65

M.R.C.C. & C. Co.
TO
United Coal Co.
2.41 Ac.
Deed dated 6-10-1912
No deed on file in Engr. Dept.
see Plan B-4
(See Voucher 67758)

Now or formerly United Coal Co.

Now or formerly ISEEC Wyckoff

WYLLIE

HEIRS

P.M. Patterson Mine


