



lot not sold  
lot sold

Now or Formerly  
Josiah Kistler

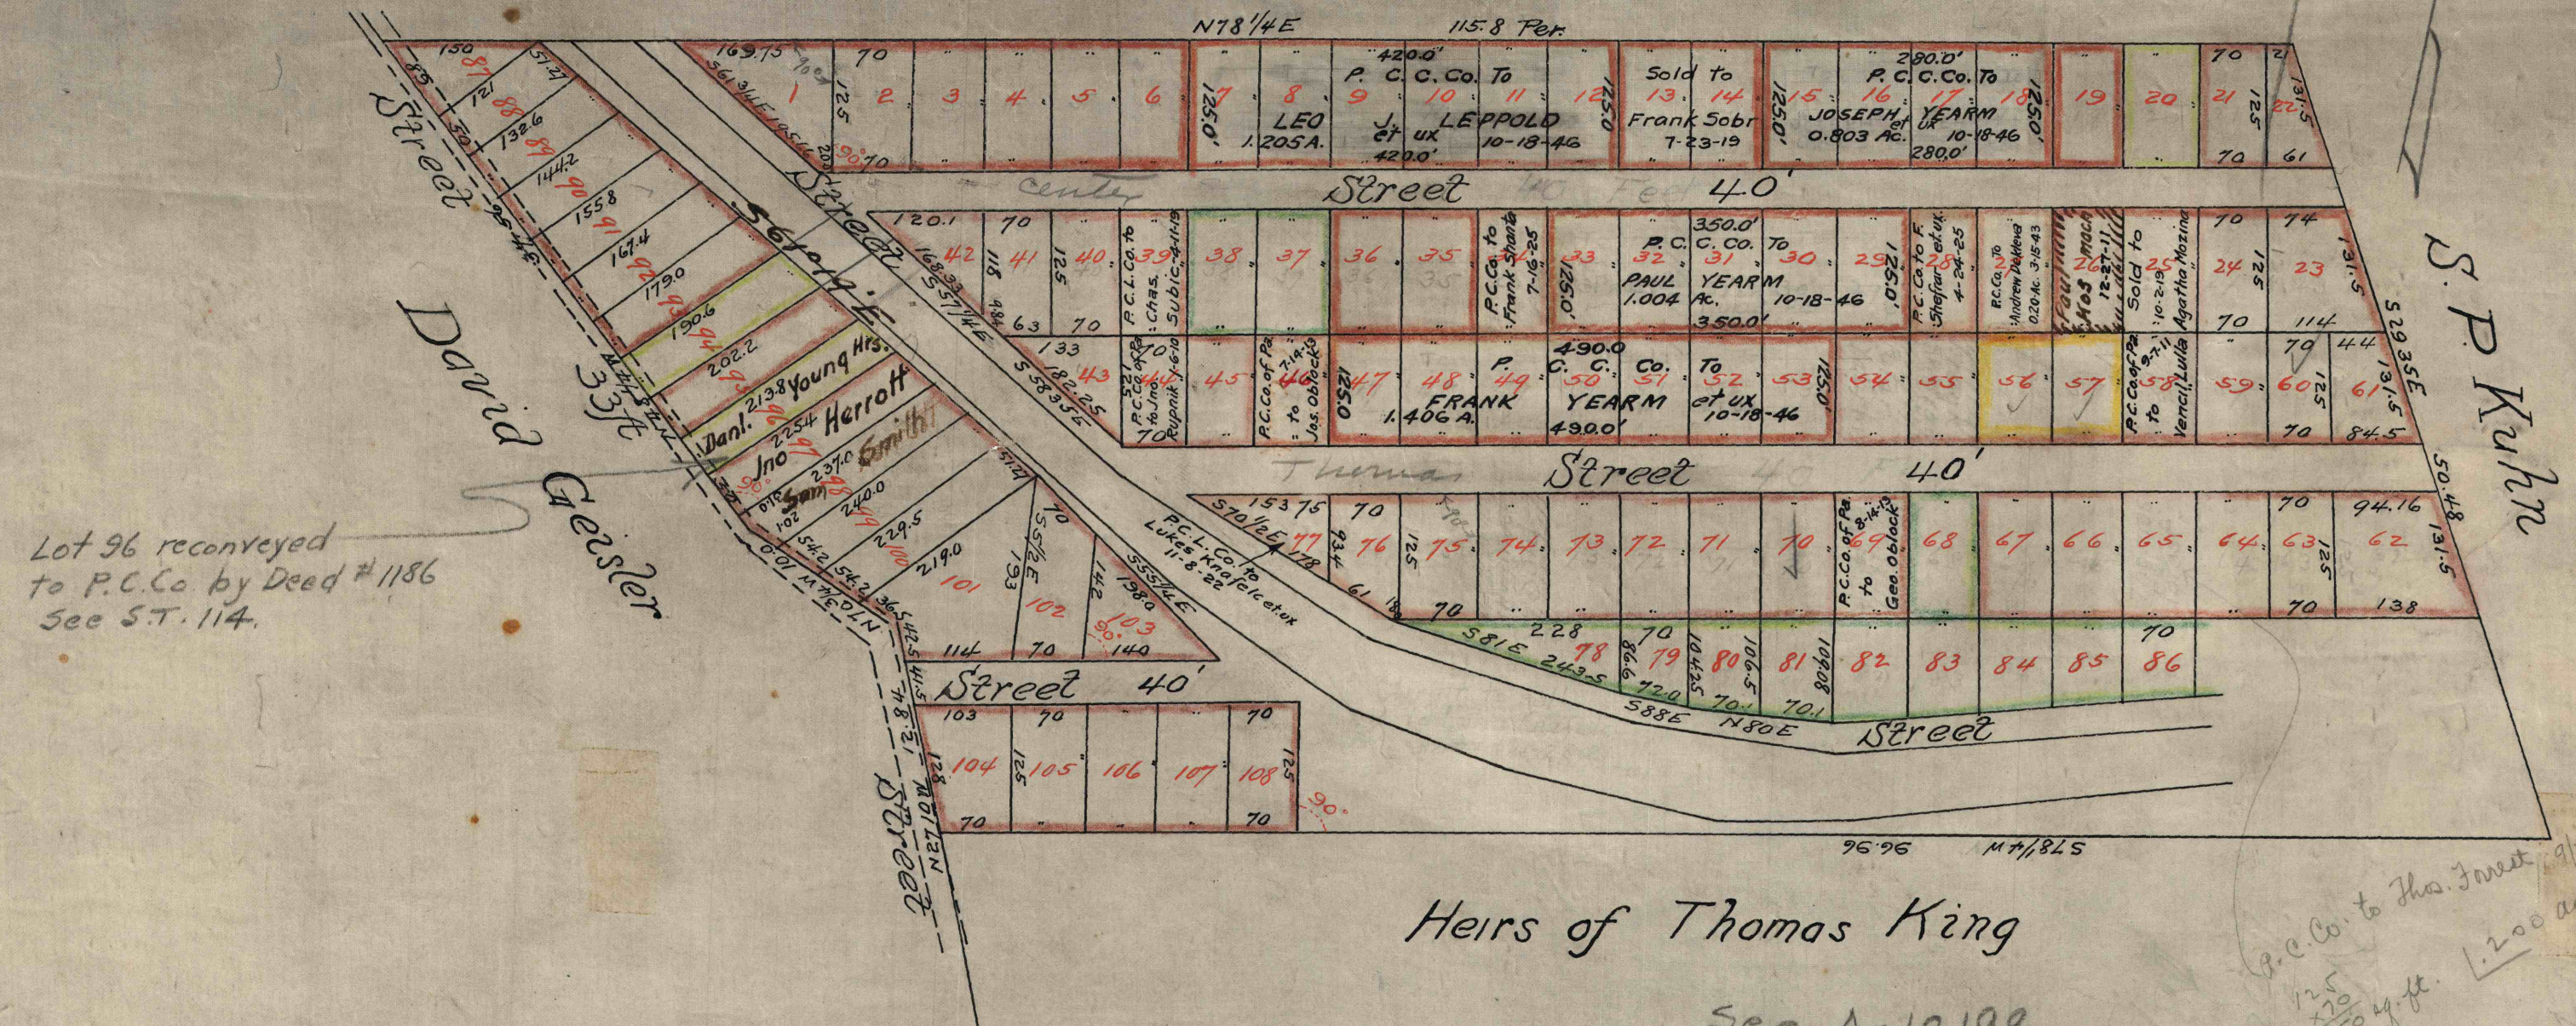

**PLAN OF LOTS**  
Laid out for  
*New York and Cleveland*  
*Gas Coal Co.*  
Near Centre School House  
*Plum Twp. Alleg. Co.*  
Plan Book Vol. 6 Page 125

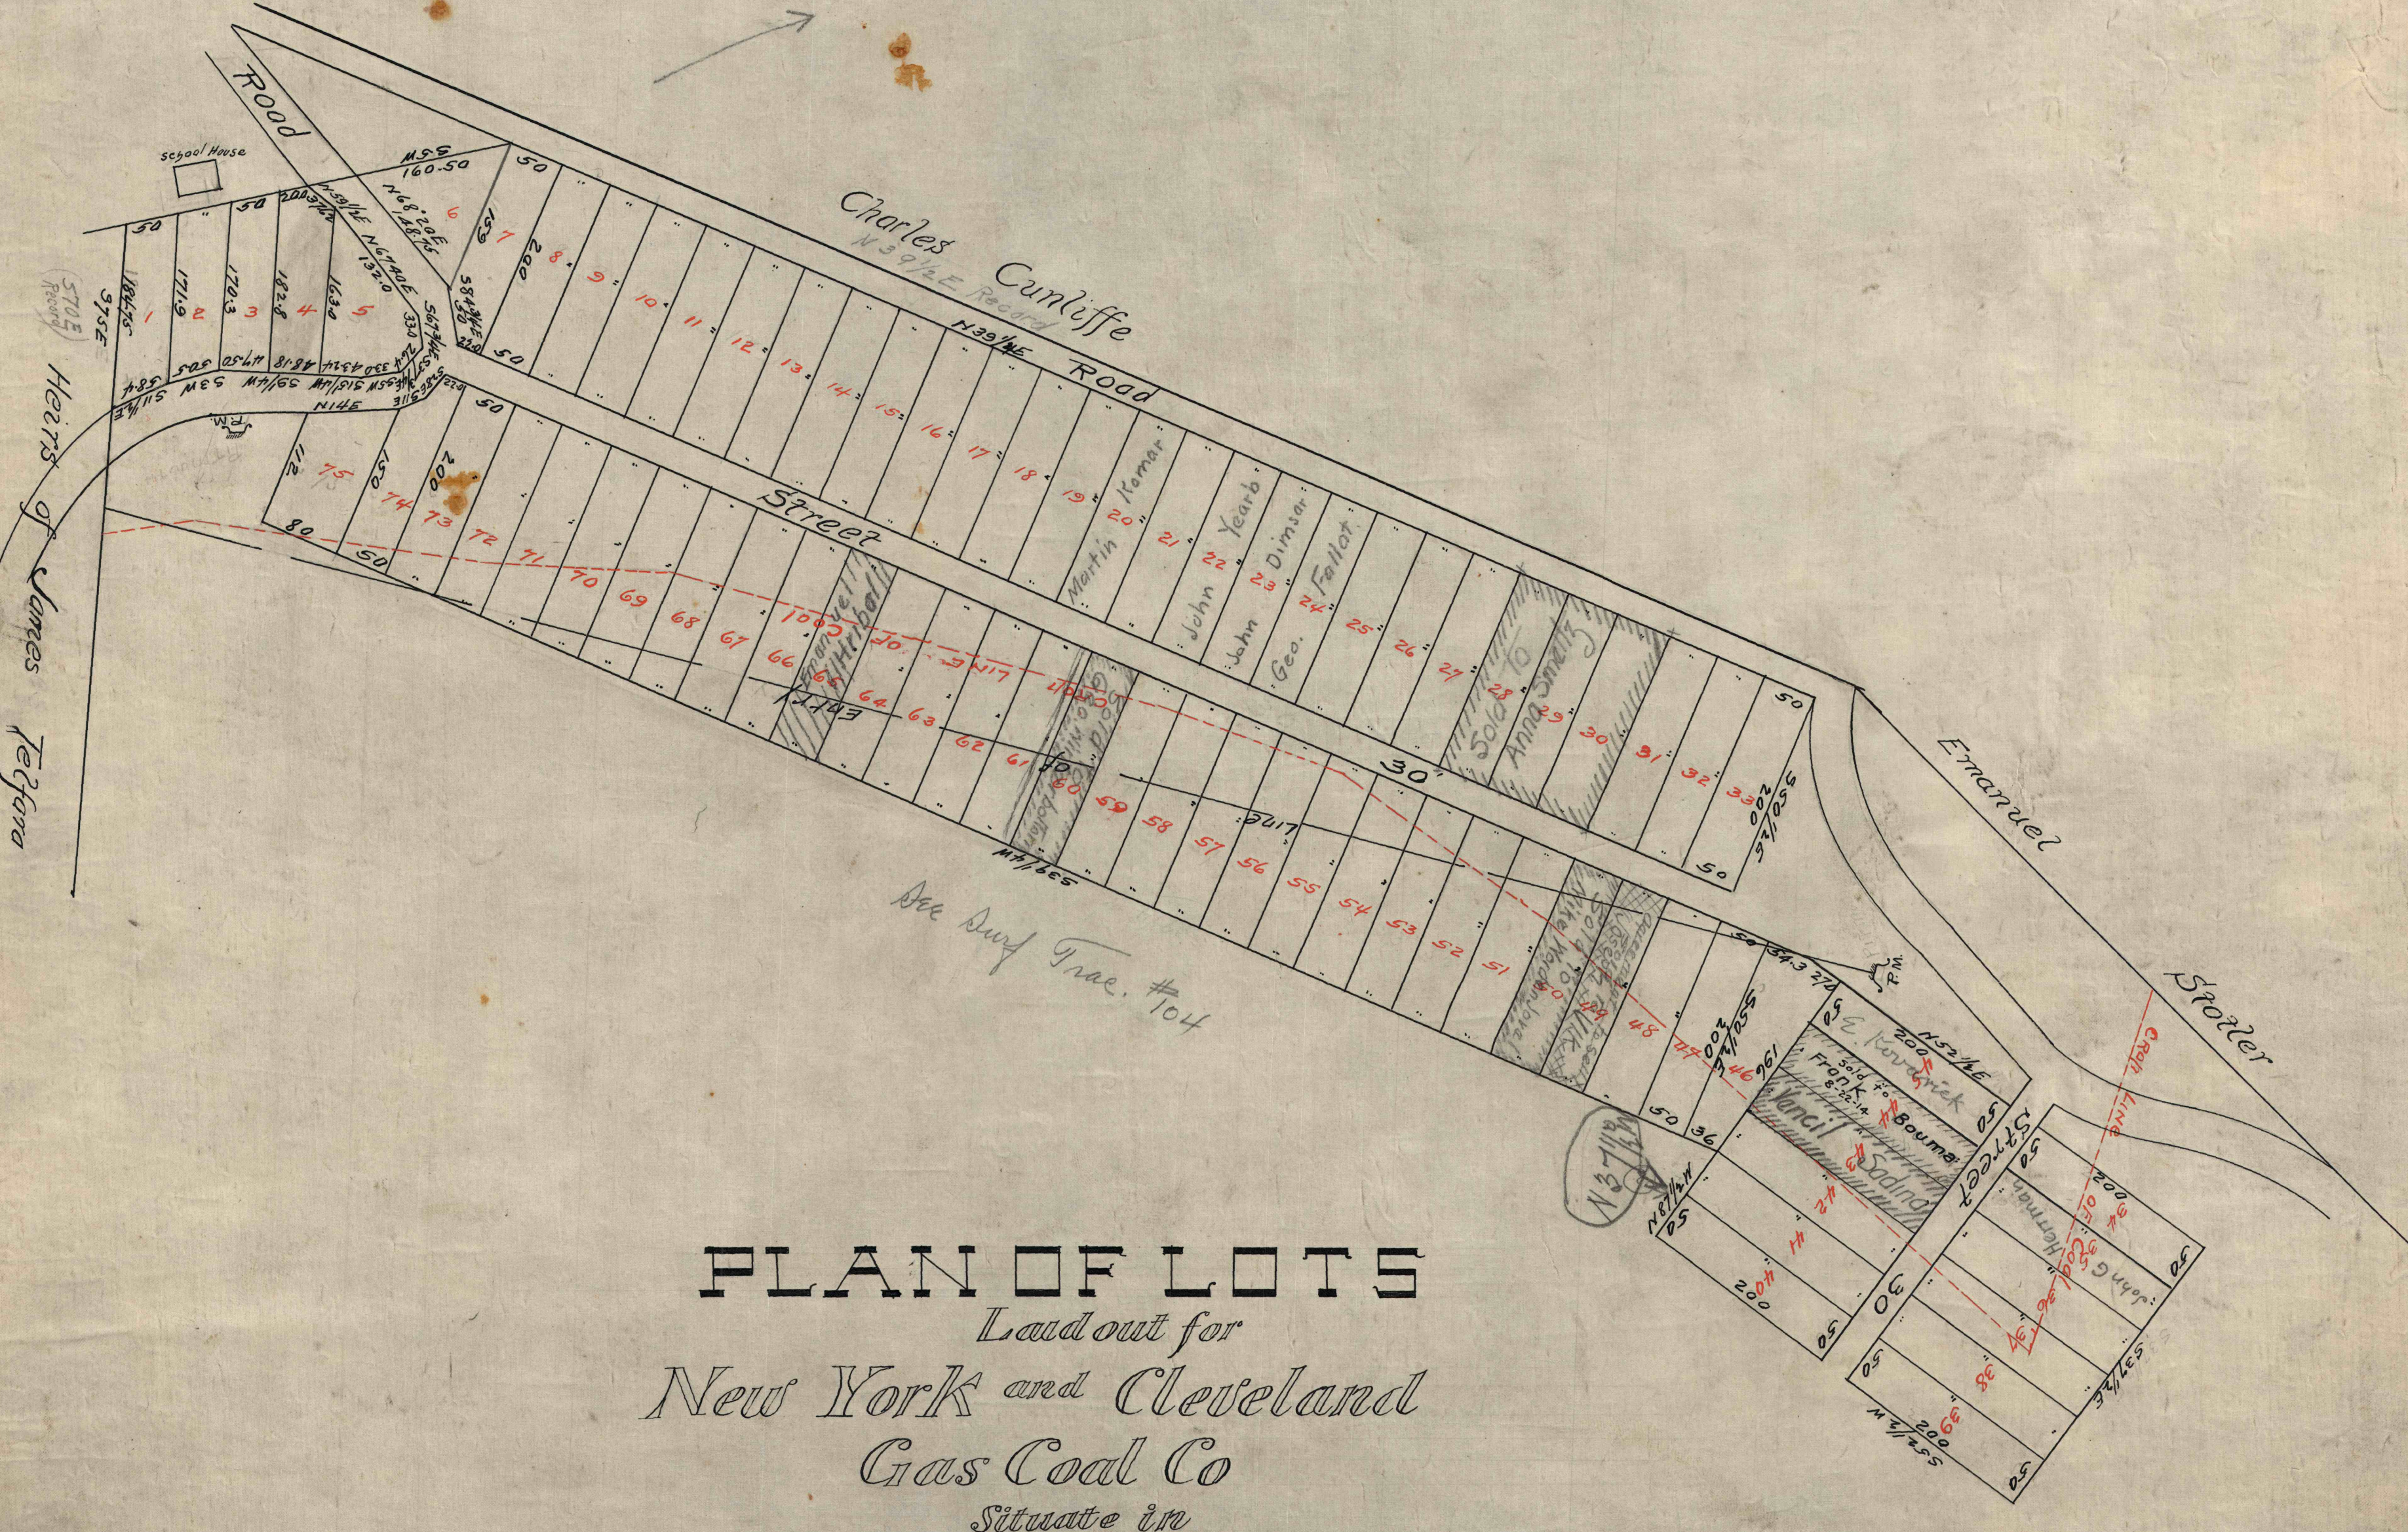

**PLAN OF LOTS**  
Laid out for  
*New York and Cleveland*  
*Gas Coal Co.*  
Situate in  
*Perin Twp. Alleg. Co.*  
Plan Book Vol. 5 Page 96