



Morgan's Addition
 California, Pa.
 Surveyed Sept. 1, 1873.
 BY C.E. White, C.E.
 Plan Book 1, Page 103.

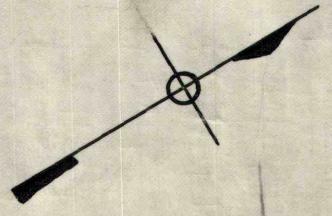

S.W. Normal Grounds.

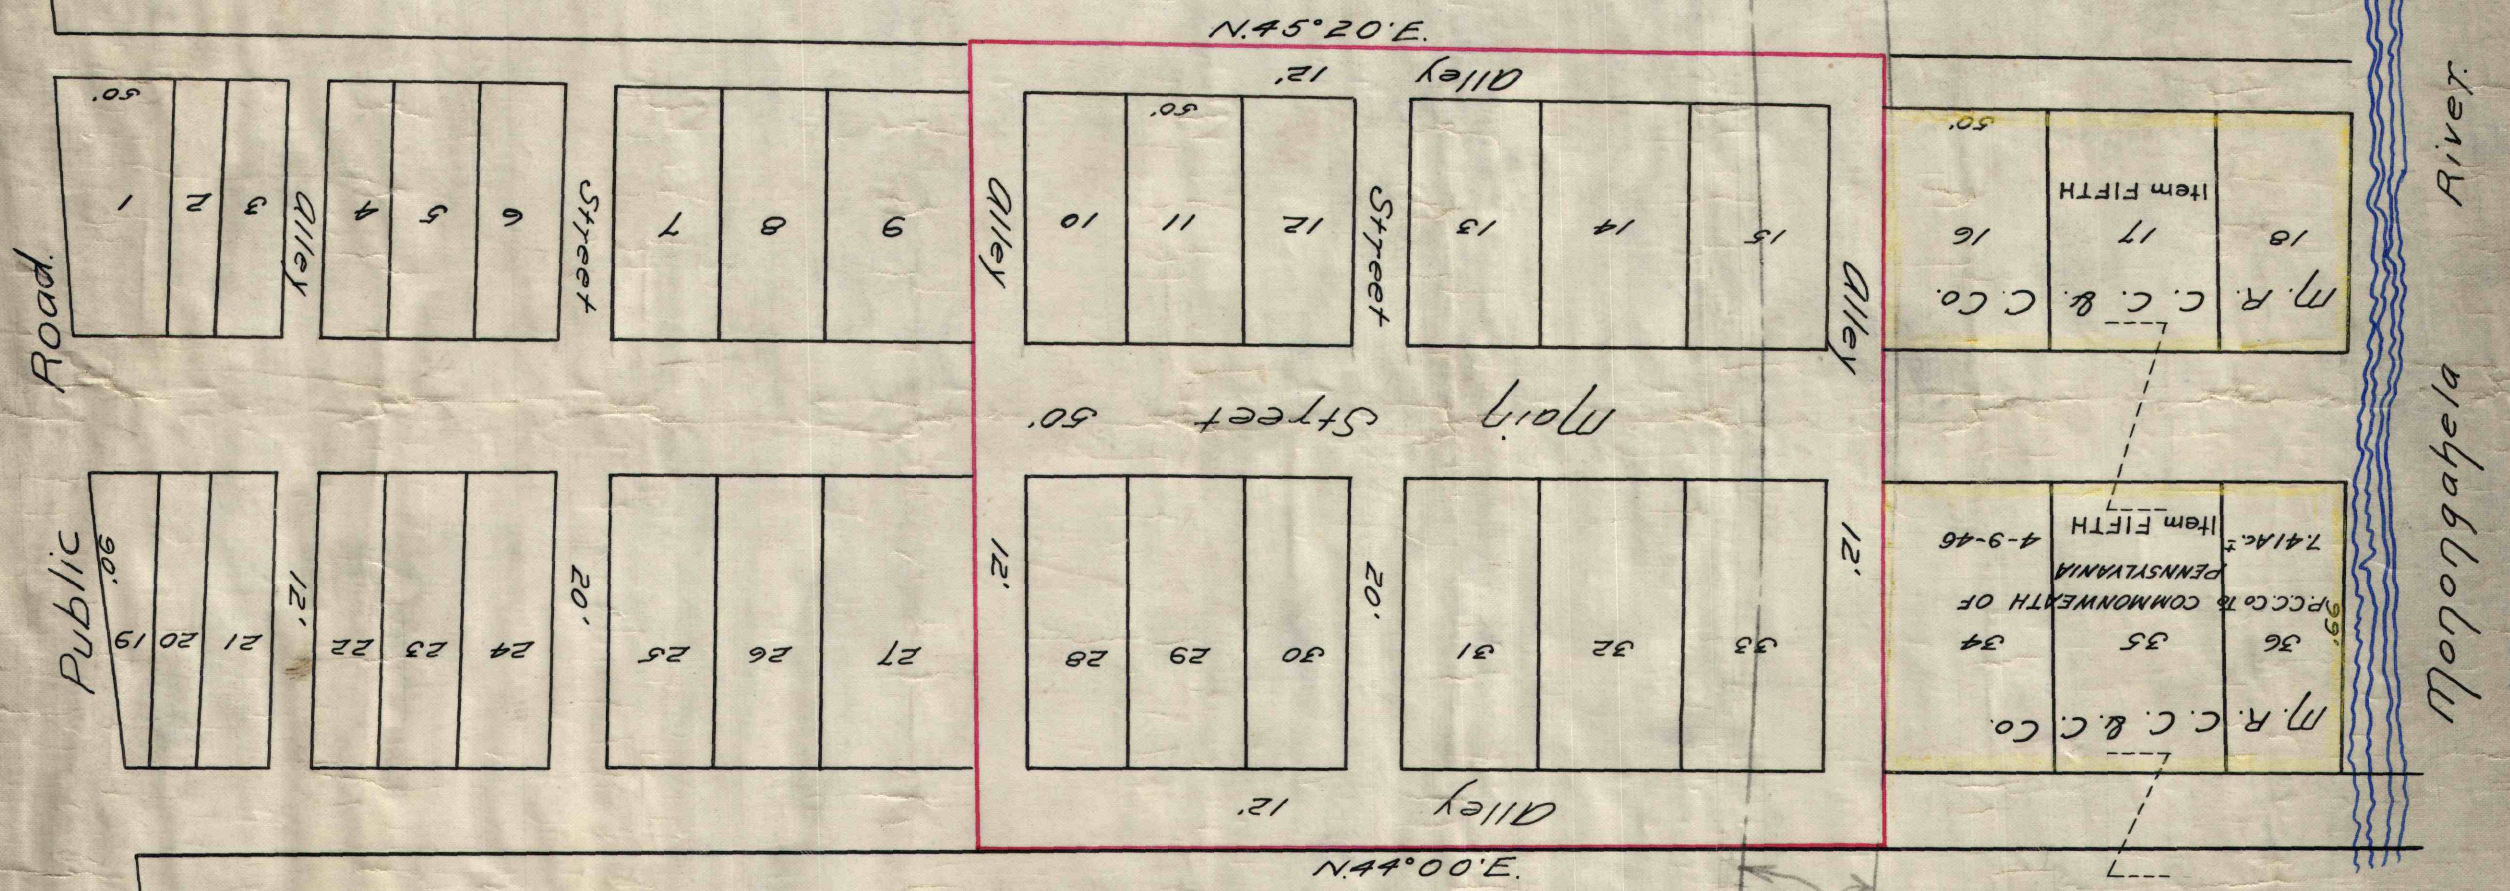

Approx. Location
 of R.R. R/W

N44°00'E.

Main Street 50'

N45°20'E.

Road.

Public

River.

Monongahela

M.R.C. & C. Co.
 Item FIFTH
 16

M.R.C. & C. Co.
 34
 35
 36
 741Ac. Item FIFTH
 4-9-46
 PENNSYLVANIA
 COMMONWEALTH OF

Alley 12'
 Street 12'
 10
 11
 12

Alley 12'
 Street 20'
 28
 29
 30

Street 20'
 7
 8
 9

Street 20'
 25
 26
 27

Alley 12'
 4
 5
 6

Alley 12'
 22
 23
 24

Alley 12'
 1
 2
 3

Alley 12'
 19
 20
 21