Buildings at Penn Mine

Scale 100'=1" Irwin Pa. 7-17-26.

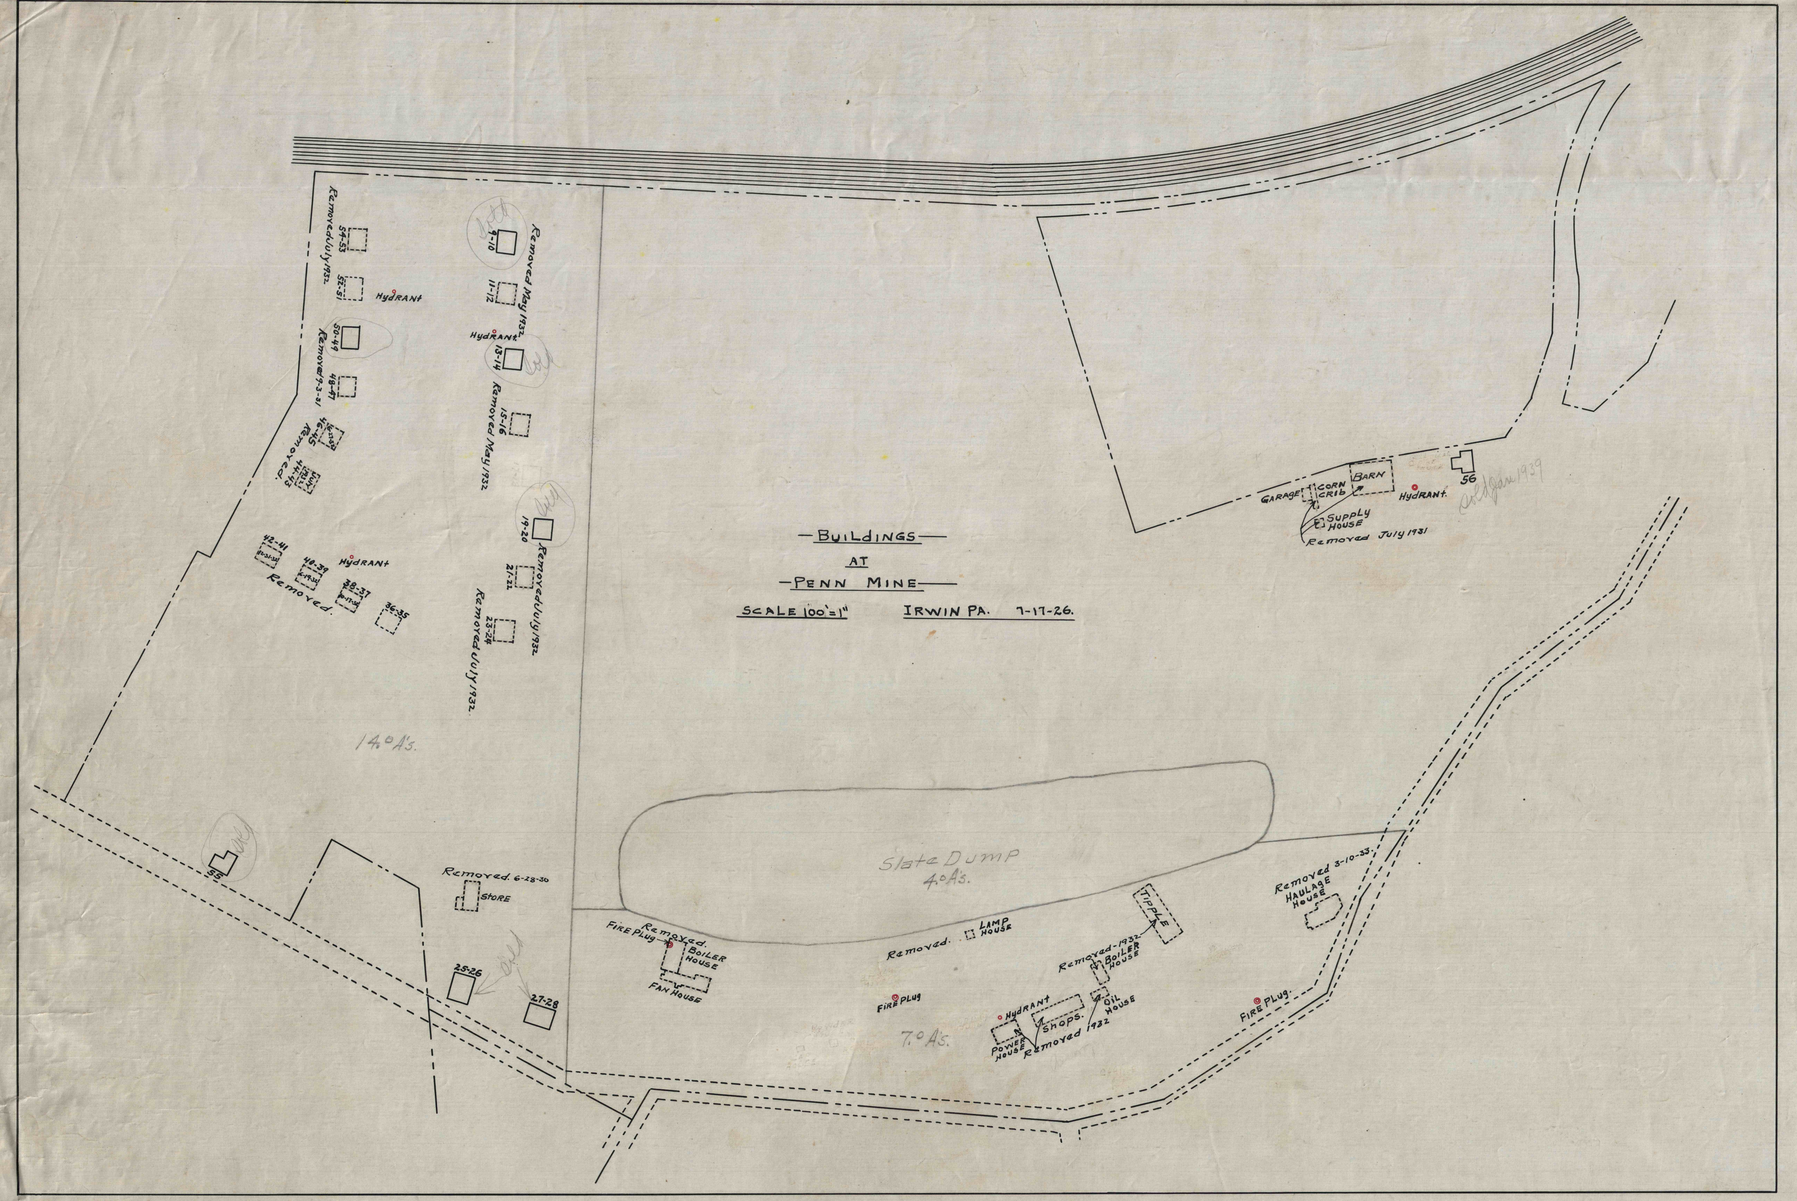

Buildings at Youghiogheny Mine

Scale 100'=1" Irwin Pa. 7-21-26.

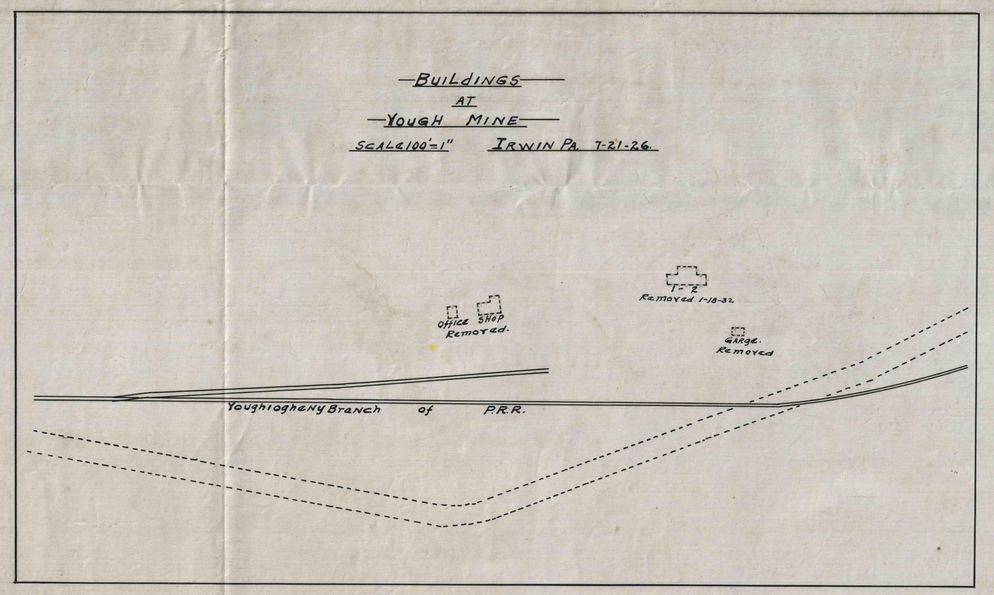

Buildings on McGrew Farm at Rilton

Scale 100'=1" Irwin Pa. 7-21-26.

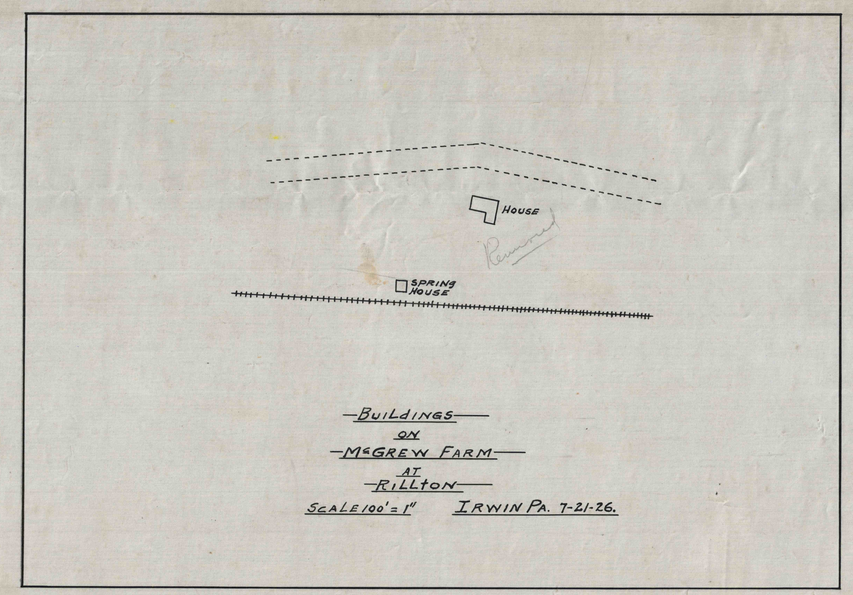

Buildings on Irwin Borough

Scale 100'=1" Irwin Pa. 7-21-26

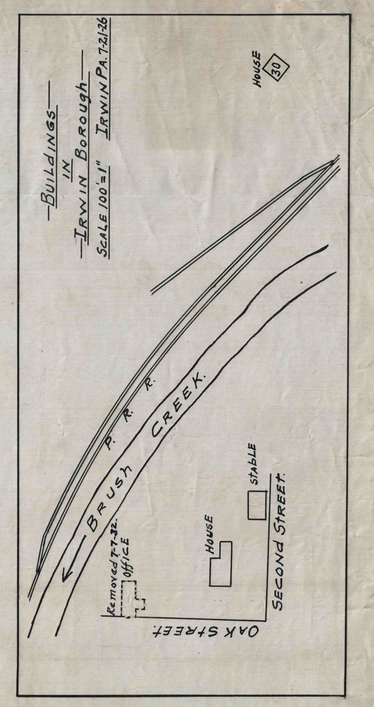

Buildings at Gratztown

Scale 100'=1" Irwin Pa. 7-20-26.

Buildings on Irwin Farm

Scale 100'=1" Irwin Pa. 7-28-26

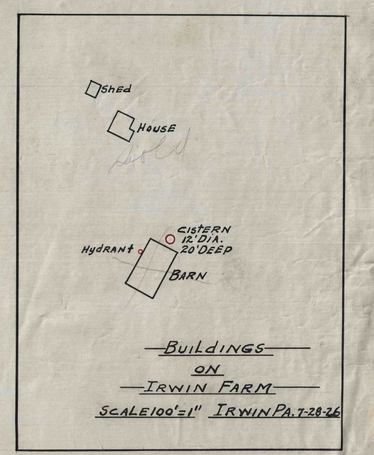

Buildings at Marchand Mine
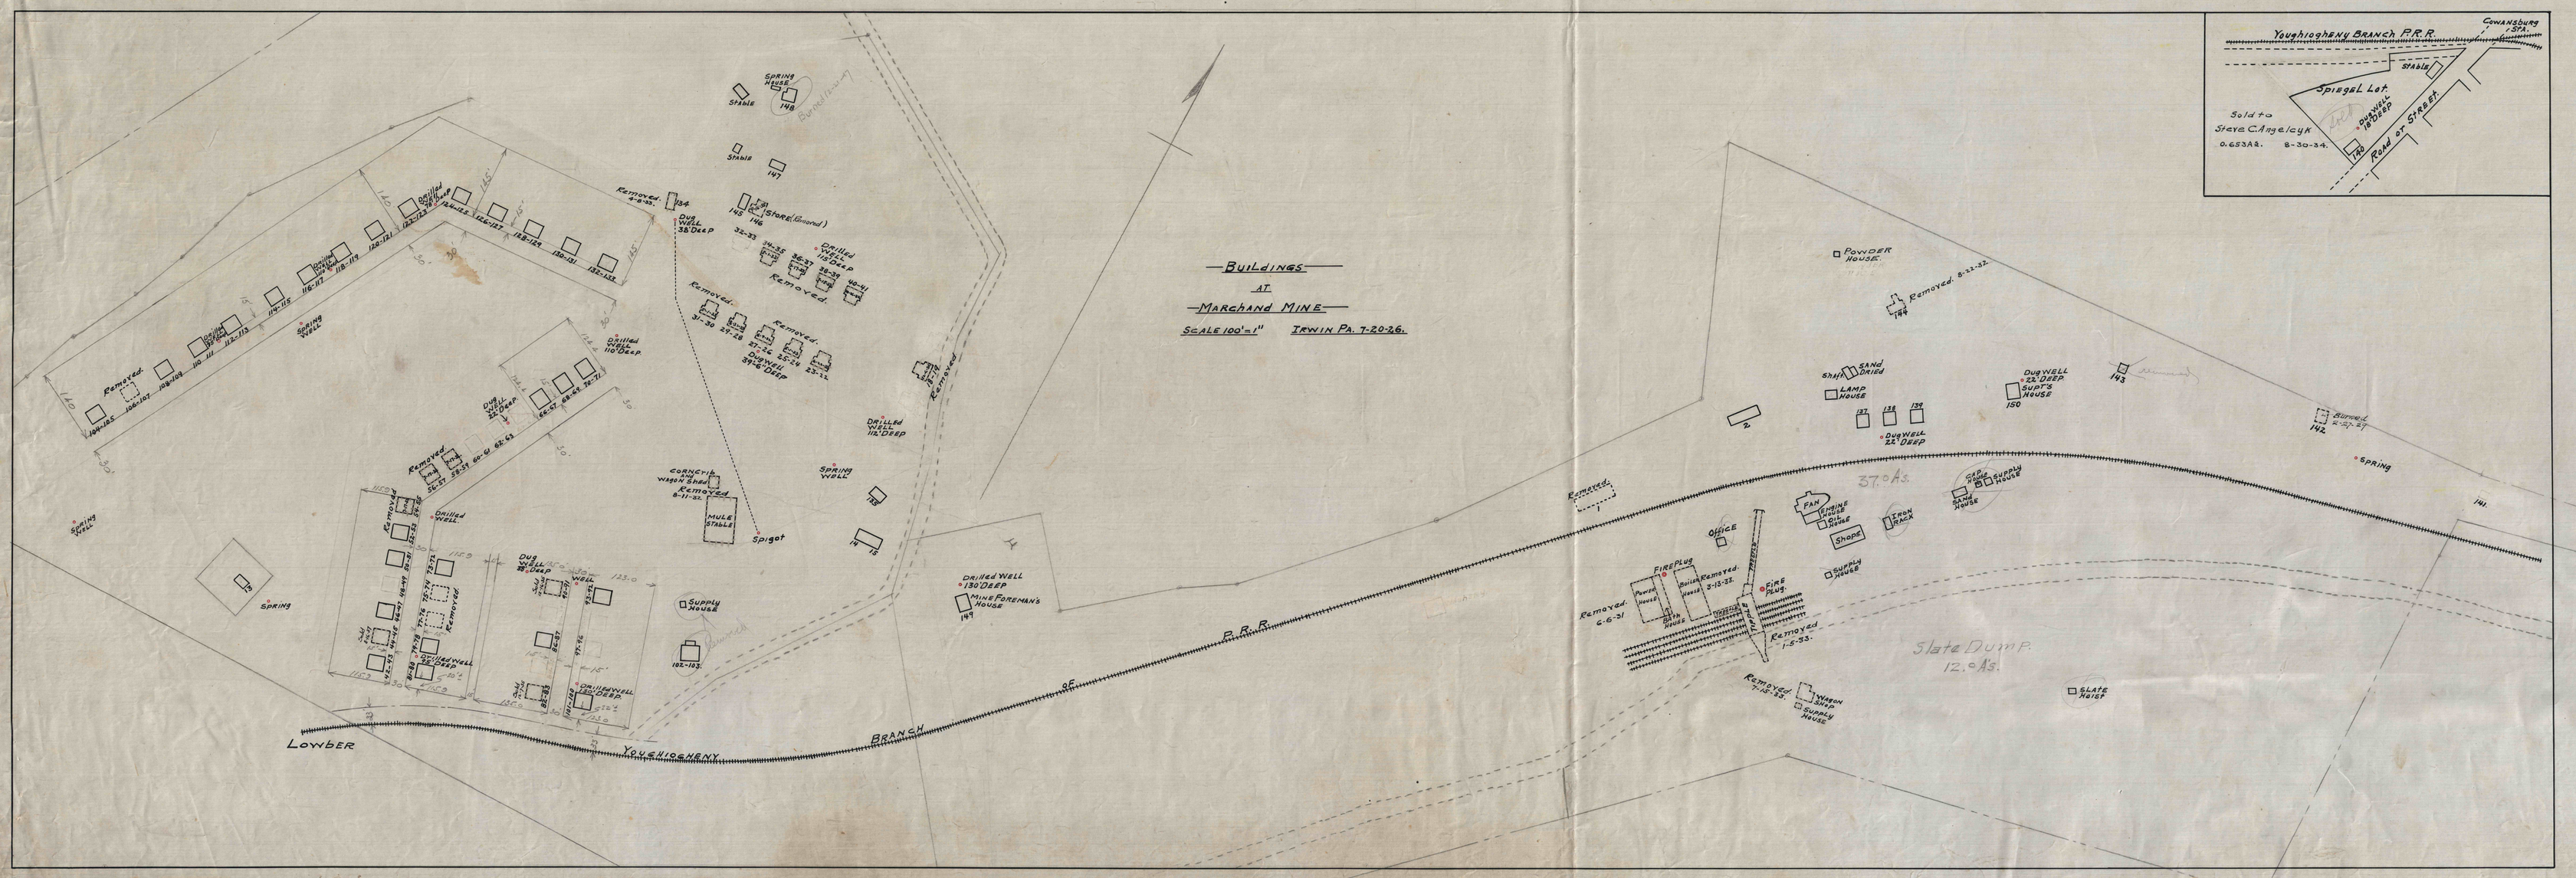
Scale 100'=1" Irwin Pa. 7-20-26.