


V A L L E Y C A M P C O A L C O .  
(MINE NO. 5)

L O R A I N C O A L & D O C K C O .

V A L L E Y C A M P C O A L C O .

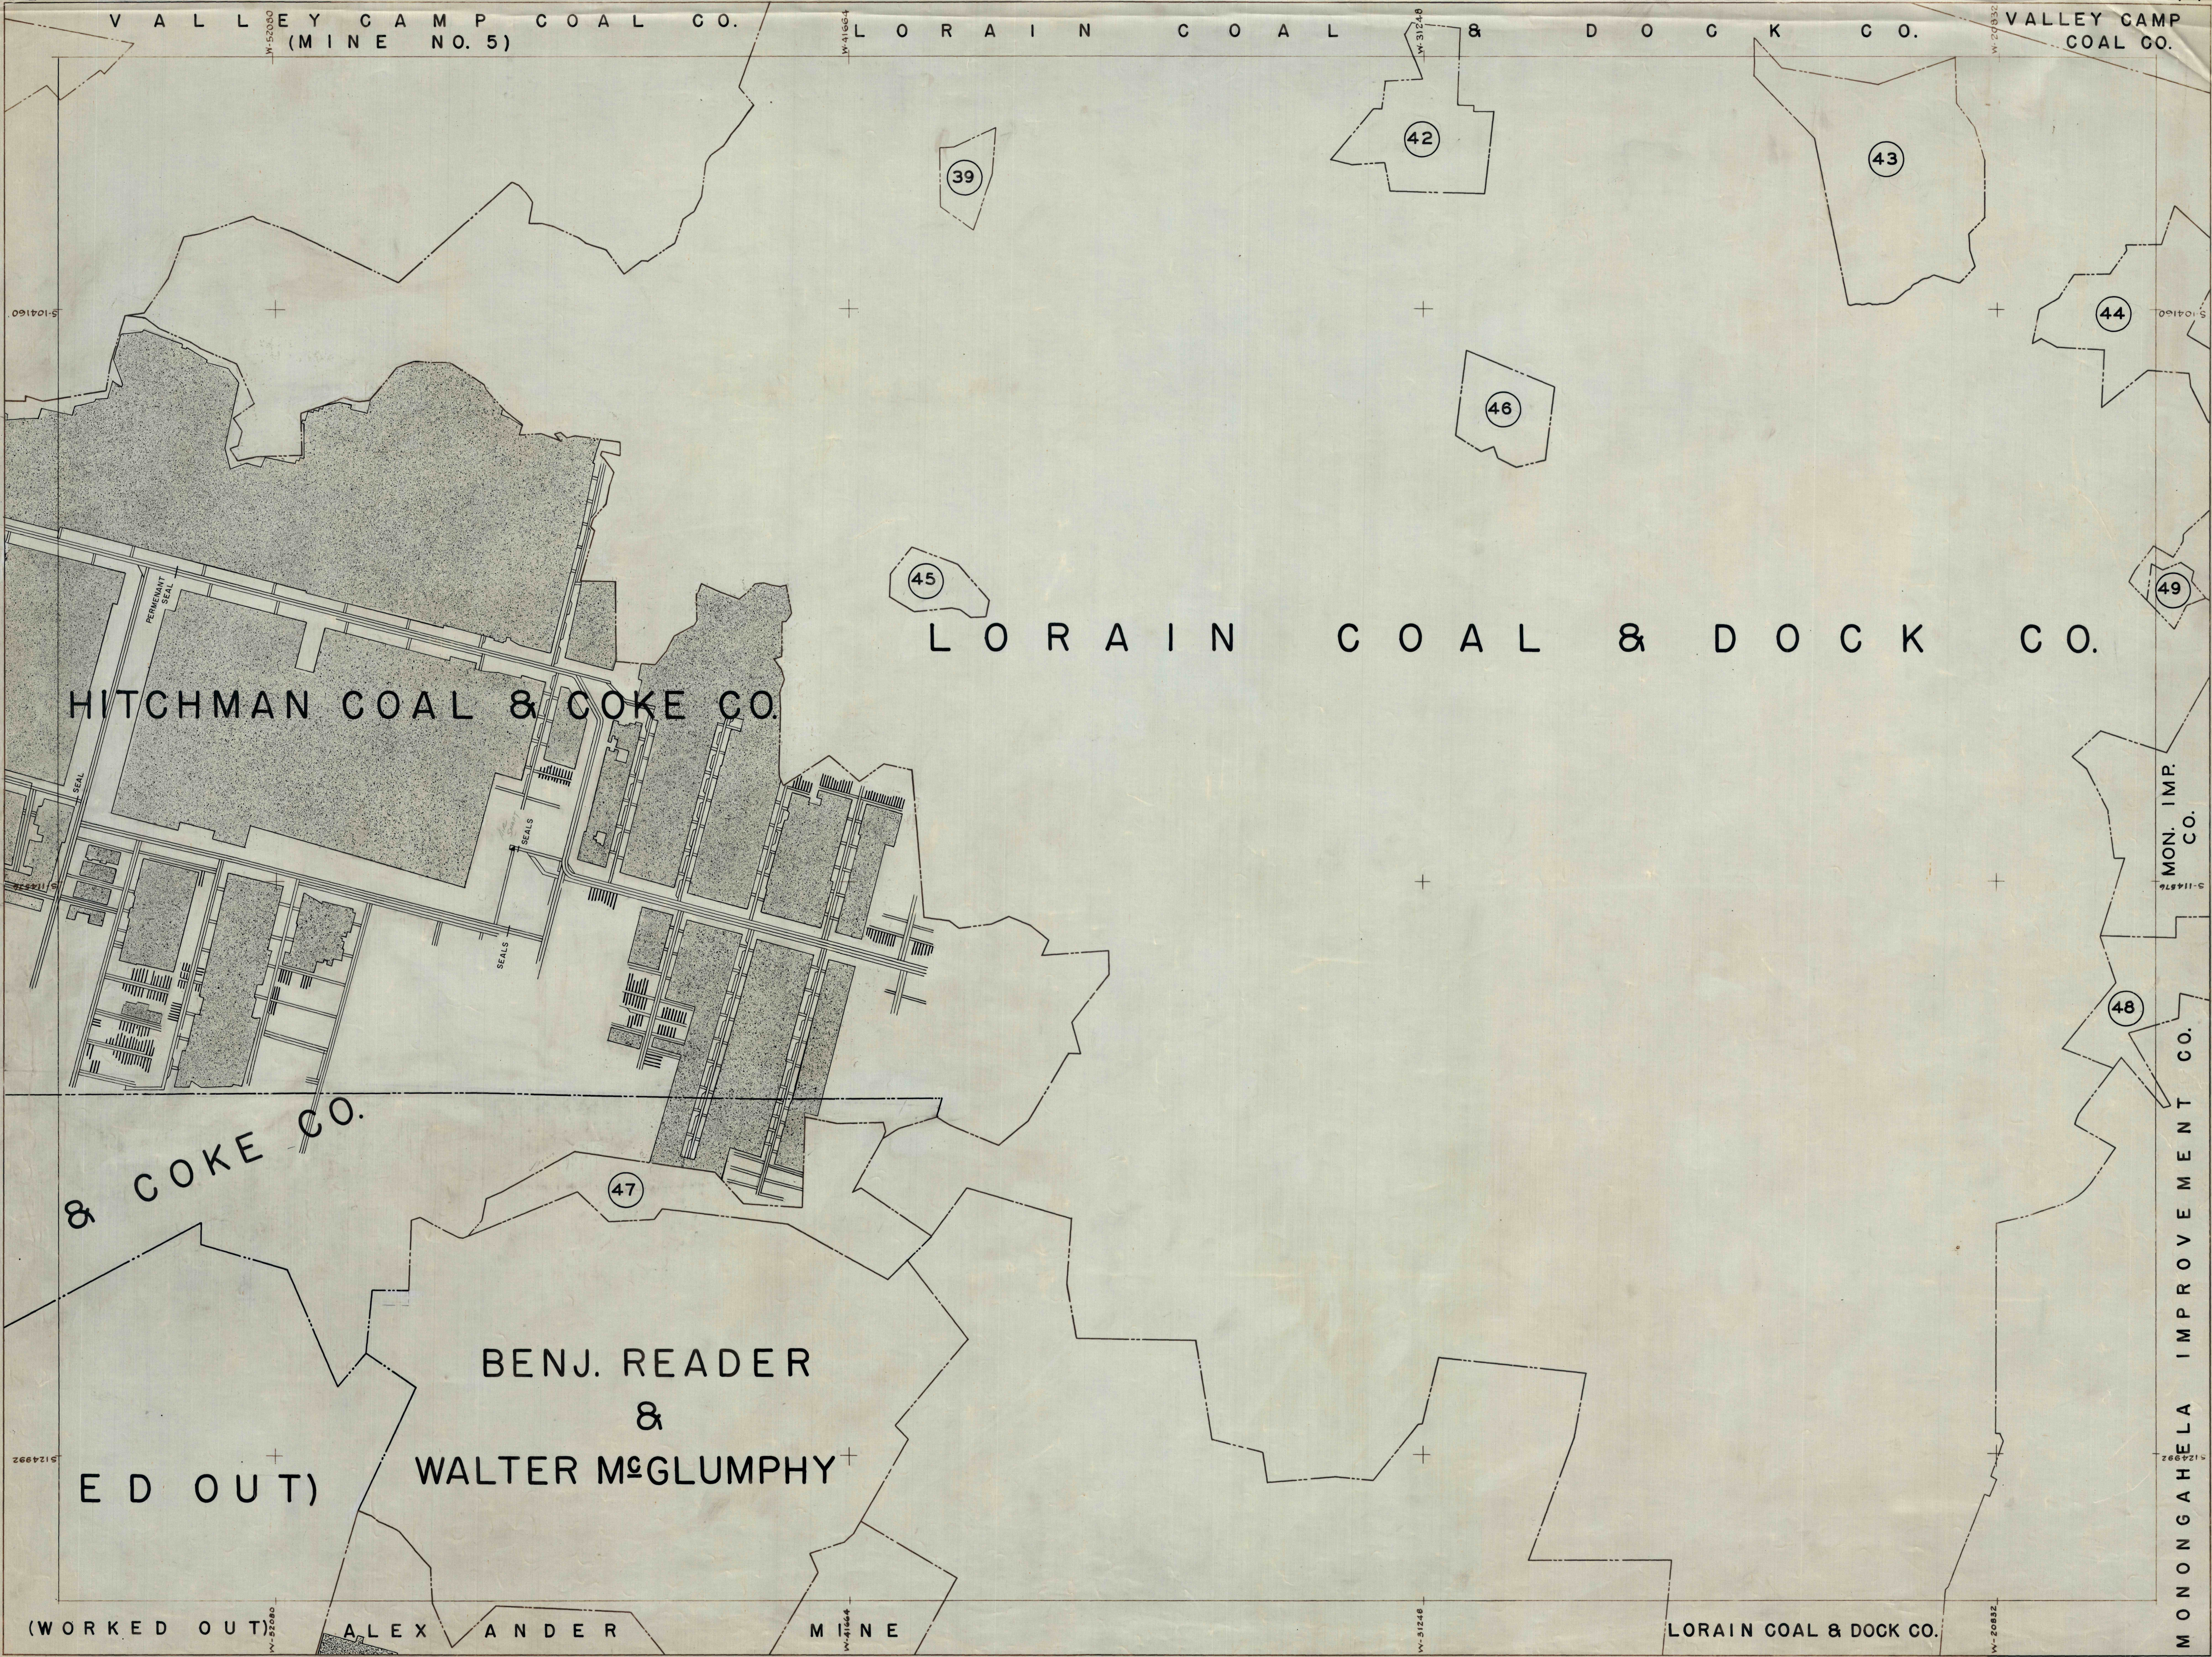

L O R A I N C O A L & D O C K C O .

HITCHMAN COAL & COKE CO.

BENJ. READER  
&  
WALTER MCGLUMPHY

(WORKED OUT)

ALEXANDER MINE

LORAIN COAL & DOCK CO.

MON. IMP. CO.

MONONGAHELA IMPROVEMENT CO.