

PLAN OF CENTER LOTS

Coon Tract

Situated in Plum Twp., Alleg. Co.

Scale 1 in = 100 Ft.
Twp. of Acrs. 12644

See plan B 103-N-13
also see { C 966-F-37
C 920-F-37
for Recorded Plans


Now or Formerly
THOS. KING HRS.

Now or Formerly
THOS. KING HRS.

P.C.L. CO TO 1-25-19
John Haas
9.715 Acres.

P.C.L. CO TO

P.C.C. CO TO
SLOVANIAN ASSOCIATION OF CENTER, PA
4.739 Ac. 2-5-47

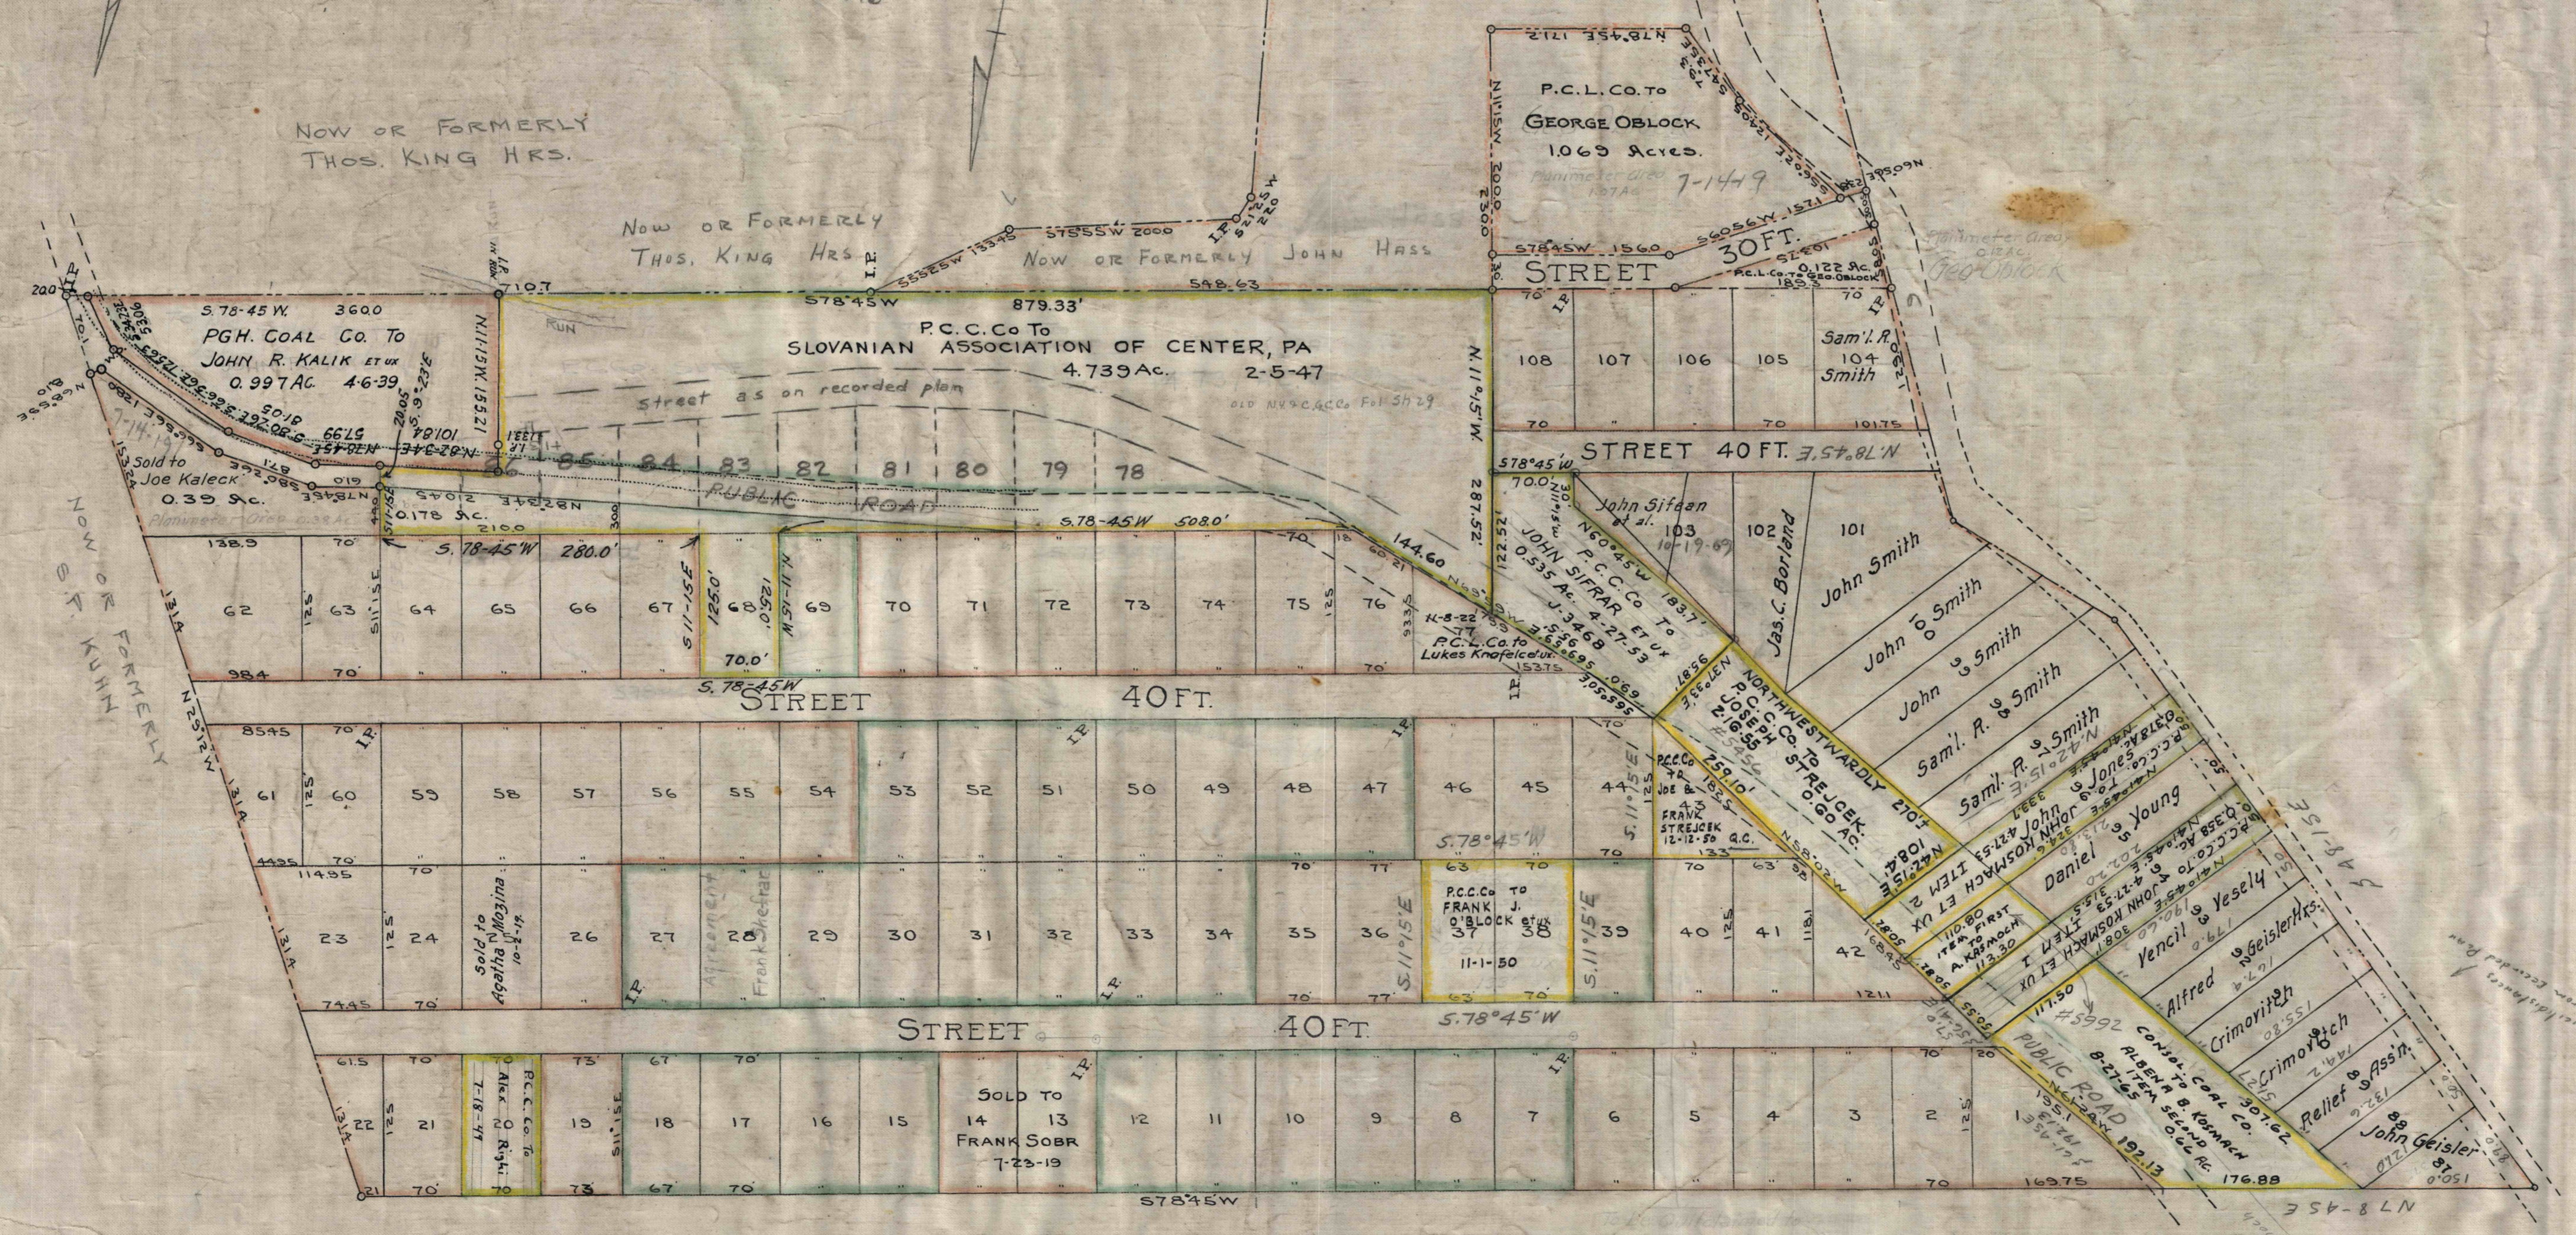

File 517

green = orig. owned by P.C. Co.
brown = not owned by P.C. Co.

C-920-F-37