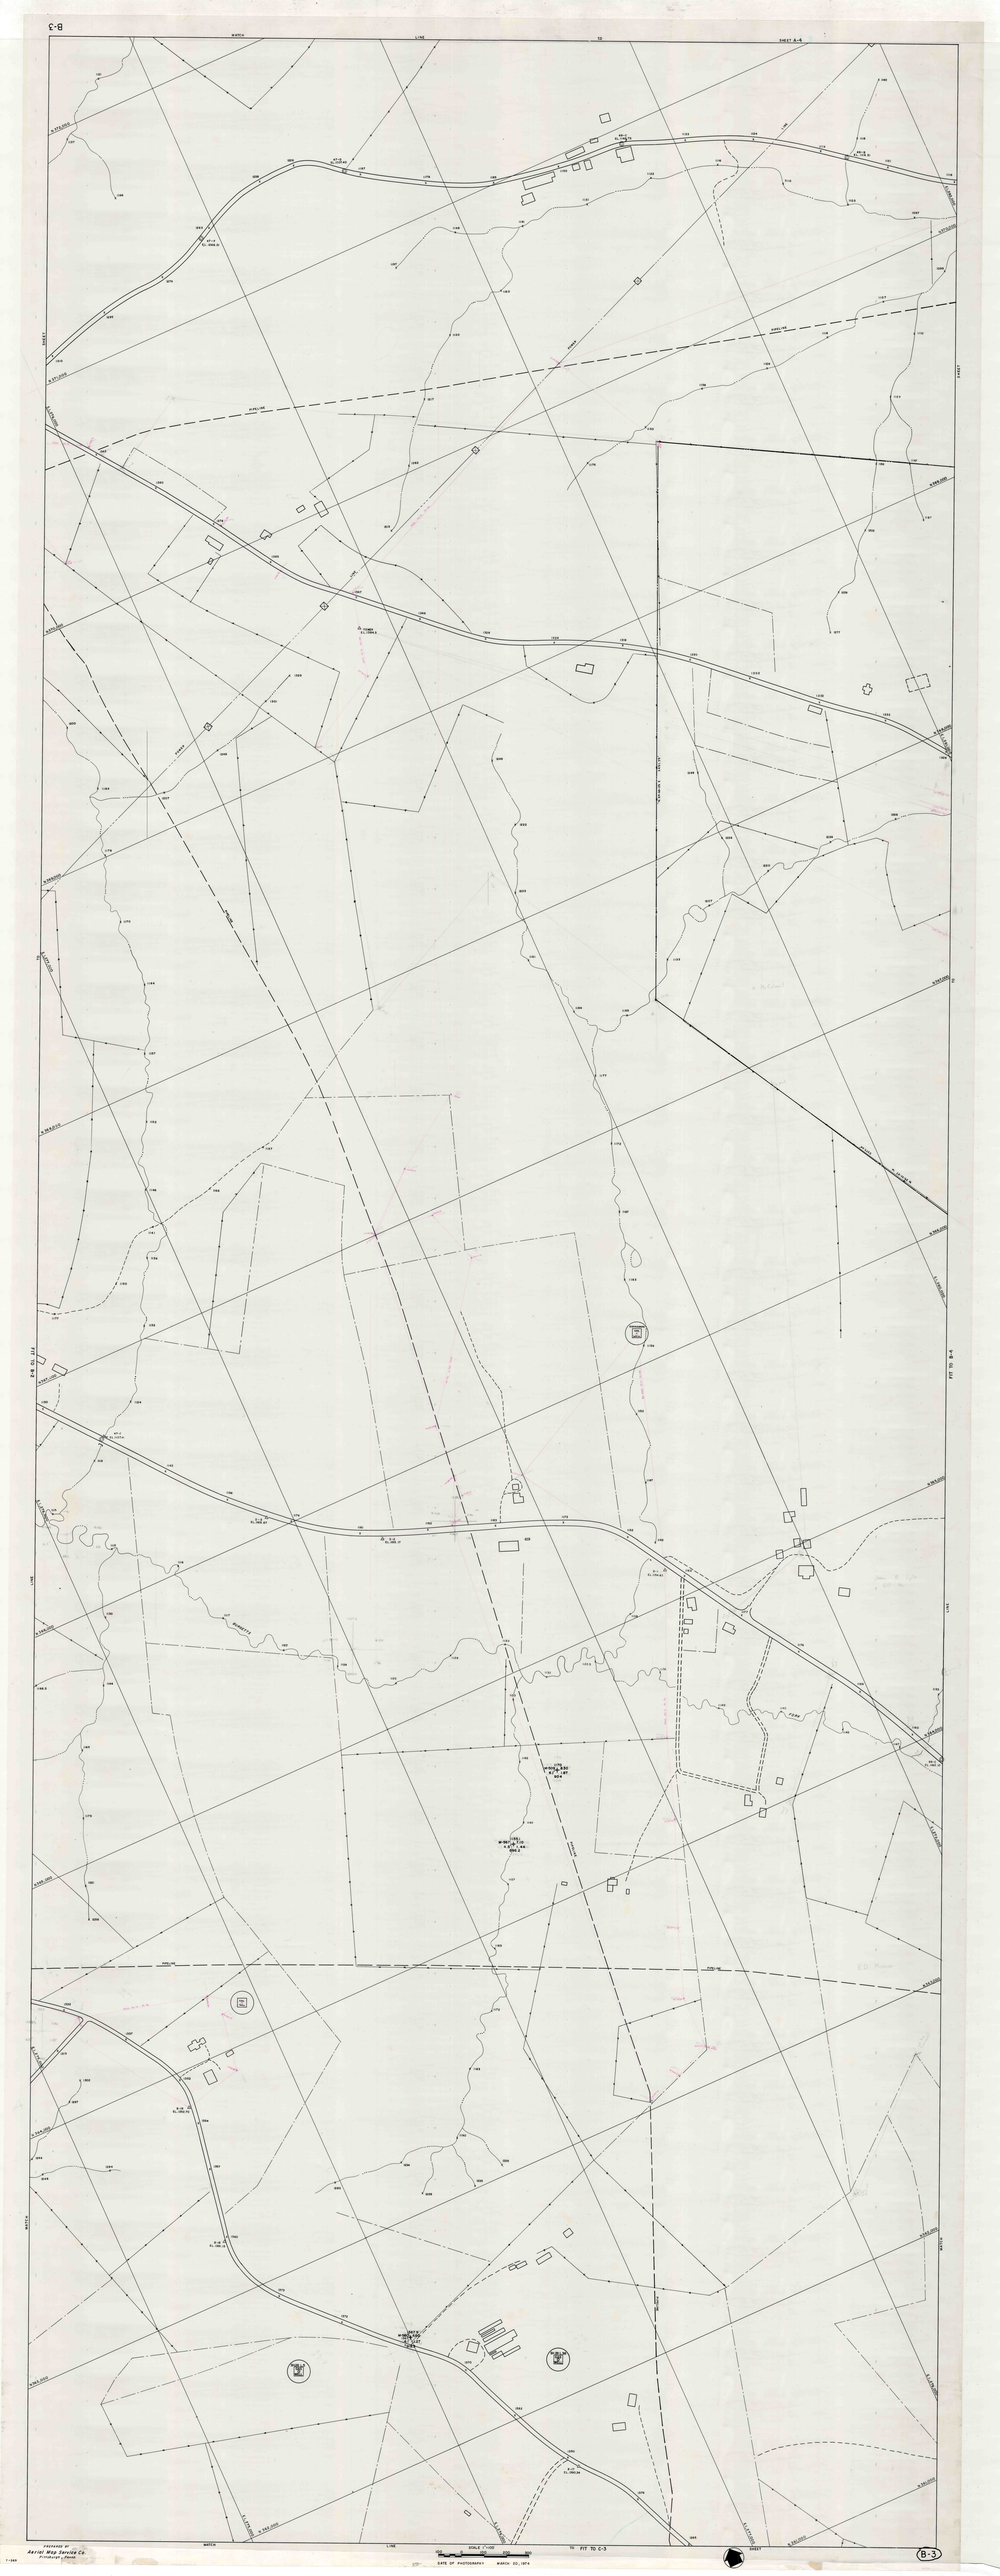
B-3
MATCH LINE TO SHEET A-4
FIT TO C-3
FIT TO A-4
SCALE 1"=400'
DATE OF PHOTOGRAPHY MARCH 20, 1974
B-3