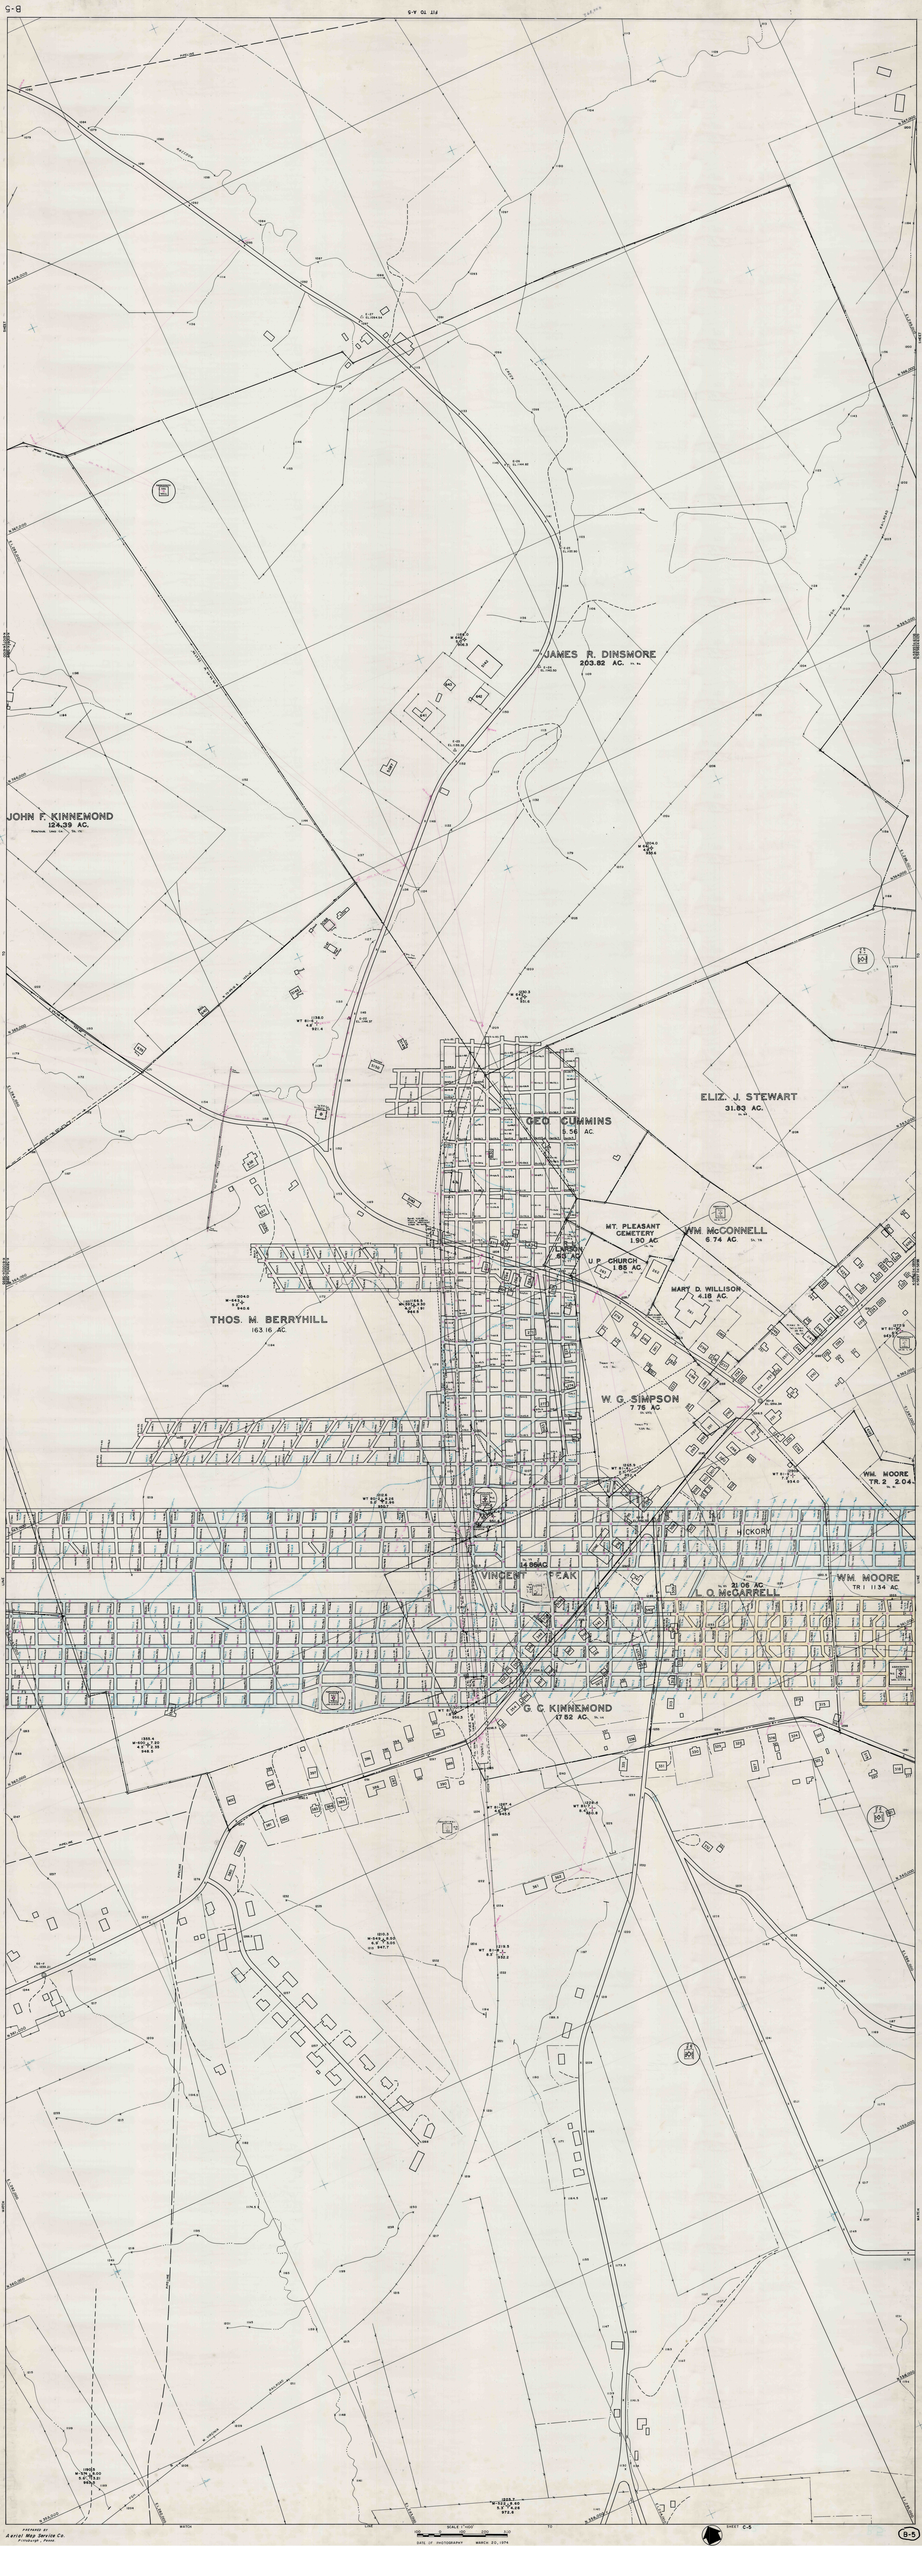
JAMES R. DINSMORE
203.82 AC.
JOHN F. KINNEMOND
124.39 AC.
ELIZ. J. STEWART
31.83 AC.
GEO. CUMMINS
1.56 AC.
MT. PLEASANT CEMETERY
1.90 AC.
WM. McCONNELL
6.74 AC.
U.P. CHURCH
1.88 AC.
MARY D. WILLISON
4.18 AC.
THOS. M. BERRYHILL
163.16 AC.
W. G. SIMPSON
7.76 AC.
WM. MOORE
TR. 2 2.04
HICKORY
VINCENT PEAK
L. O. McCARRELL
31.06 AC.
WM. MOORE
TR. 1 11.34 AC.
G. C. KINNEMOND
27.82 AC.
B-5