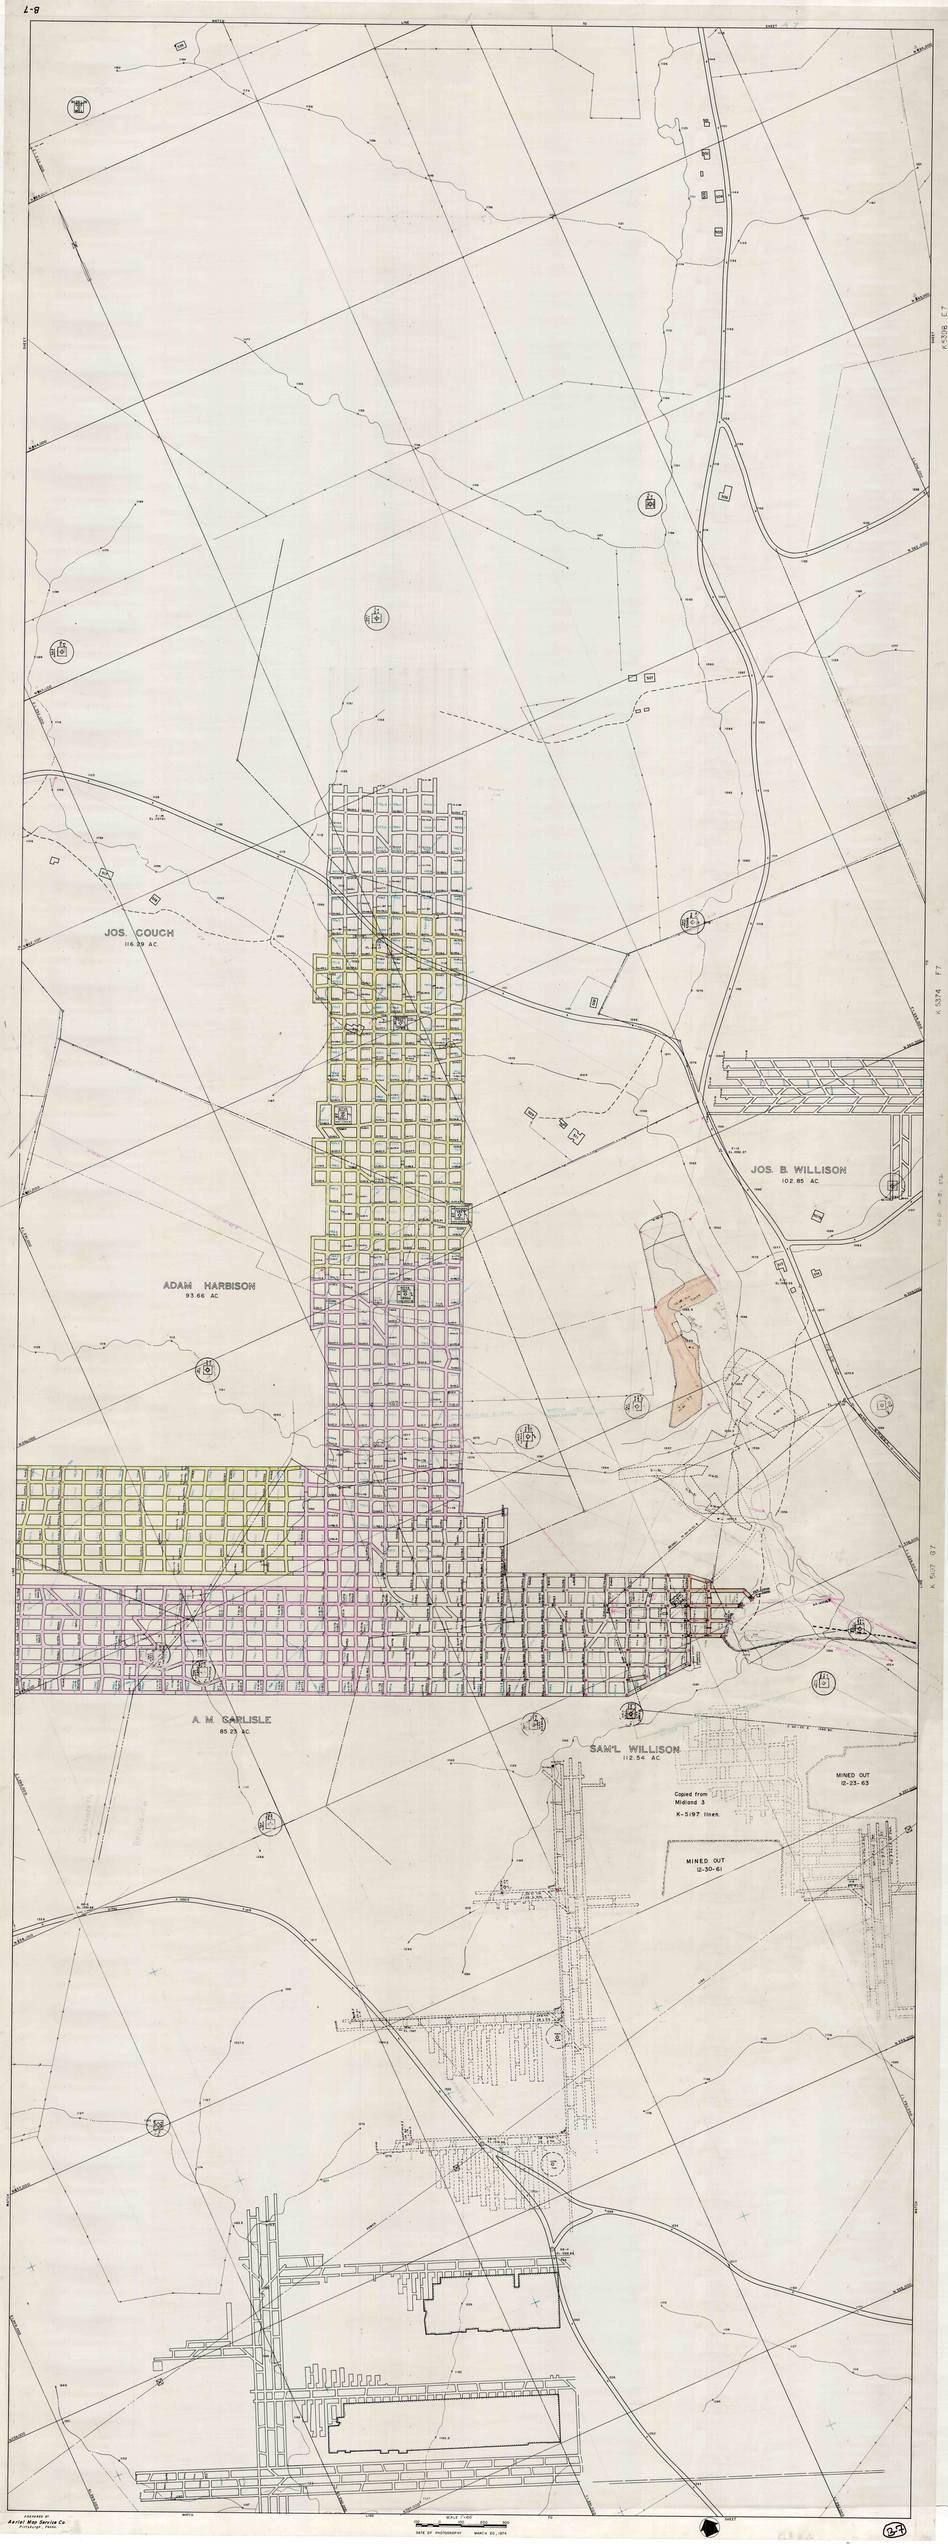
JOS. COUCH
116.29 AC.
ADAM HARBISON
93.66 AC.
JOS. B. WILLISON
102.85 AC.
A. M. CARLISLE
85.23 AC.
SAM'L WILLISON
112.54 AC.
Copied from
Midland 3
K-5197 lines.
MINED OUT
12-23-63
MINED OUT
12-30-61
K-5198 E7
K-5374 E7
K-5197 E7