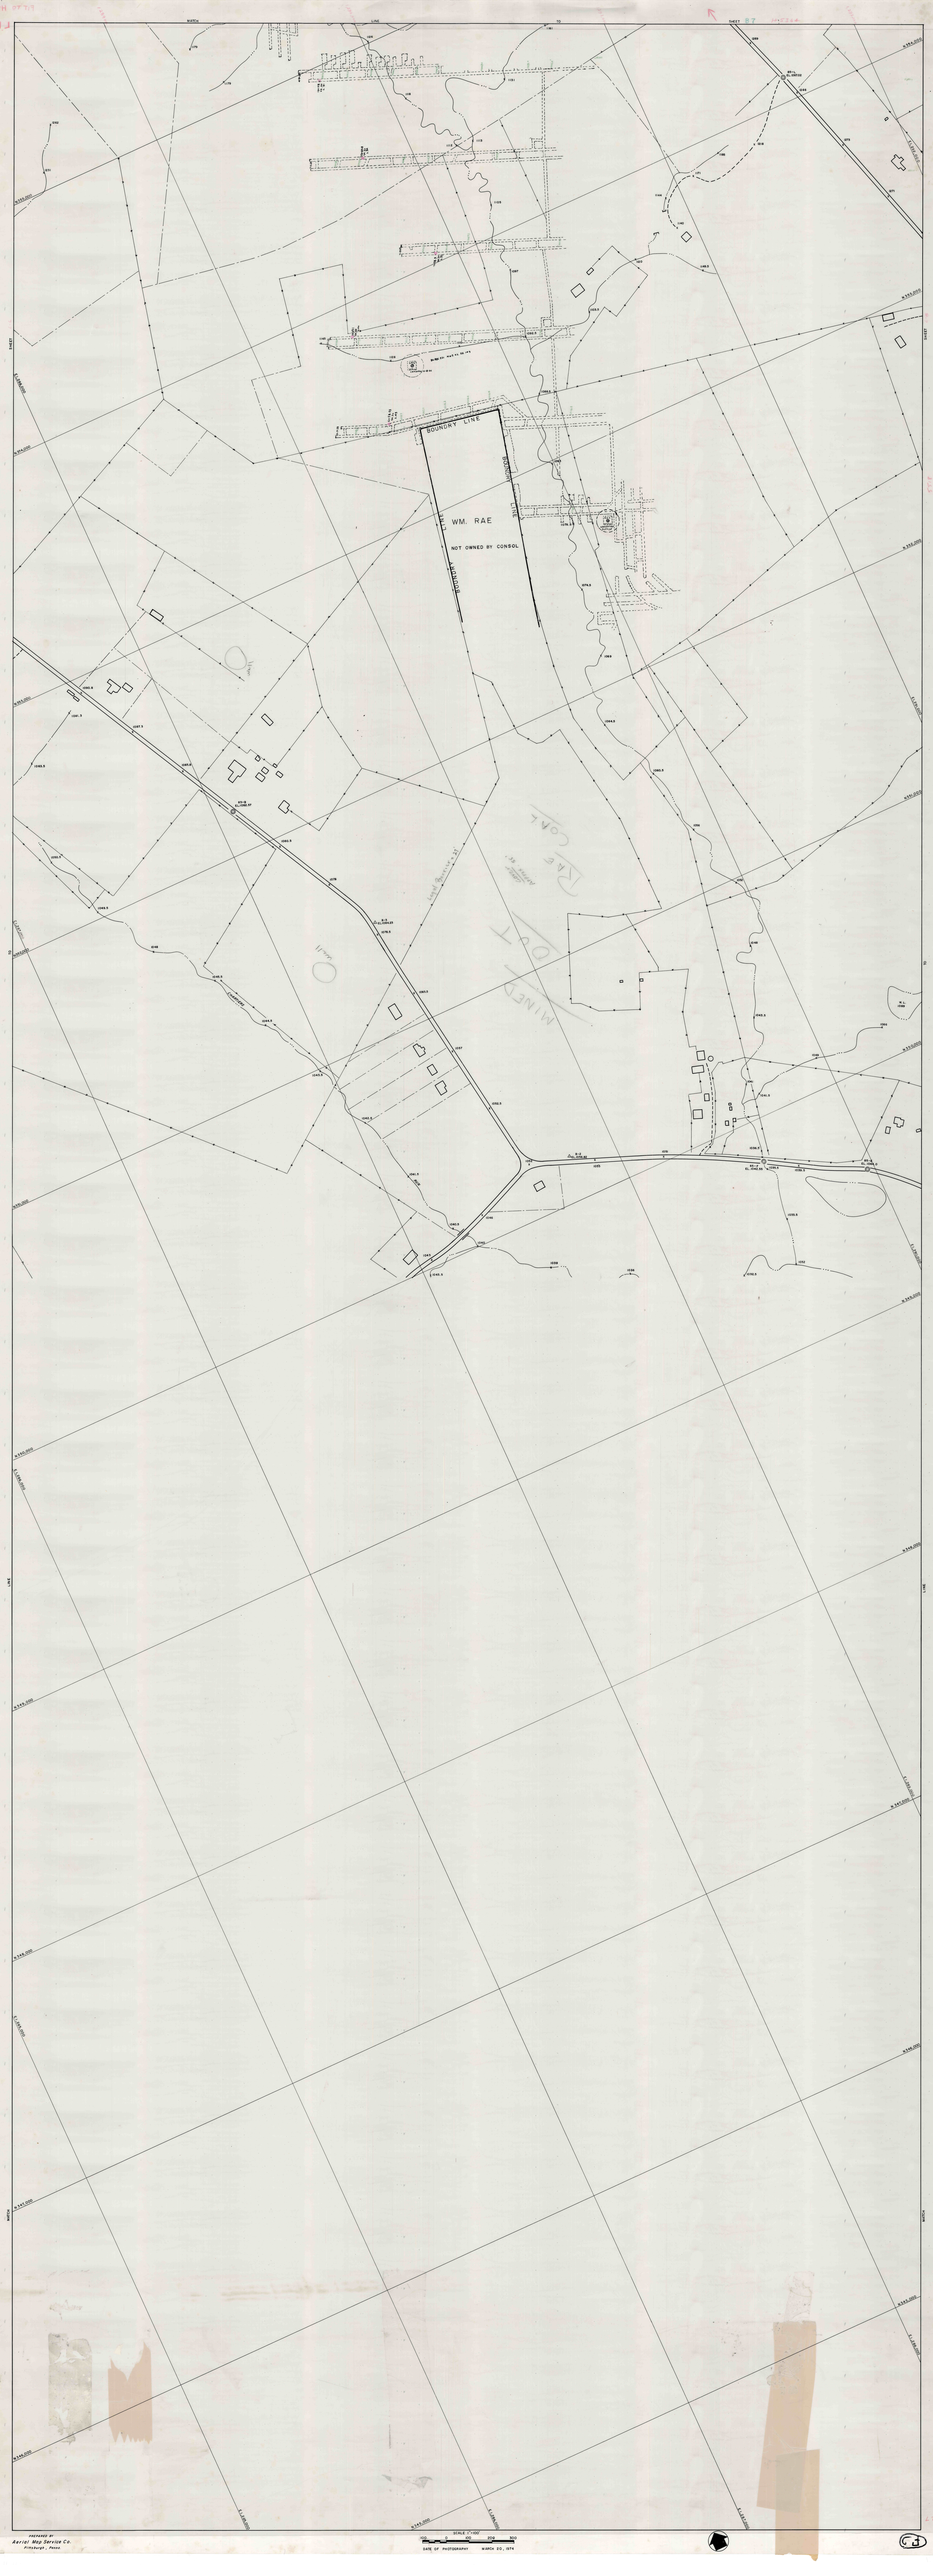

Prepared by
Aerial Map Service Co.
Pittsburgh, Penna

SCALE 1"=400'

DATE OF PHOTOGRAPHY MARCH 27, 1974