


A

B

C

D

1 2 3 4 5

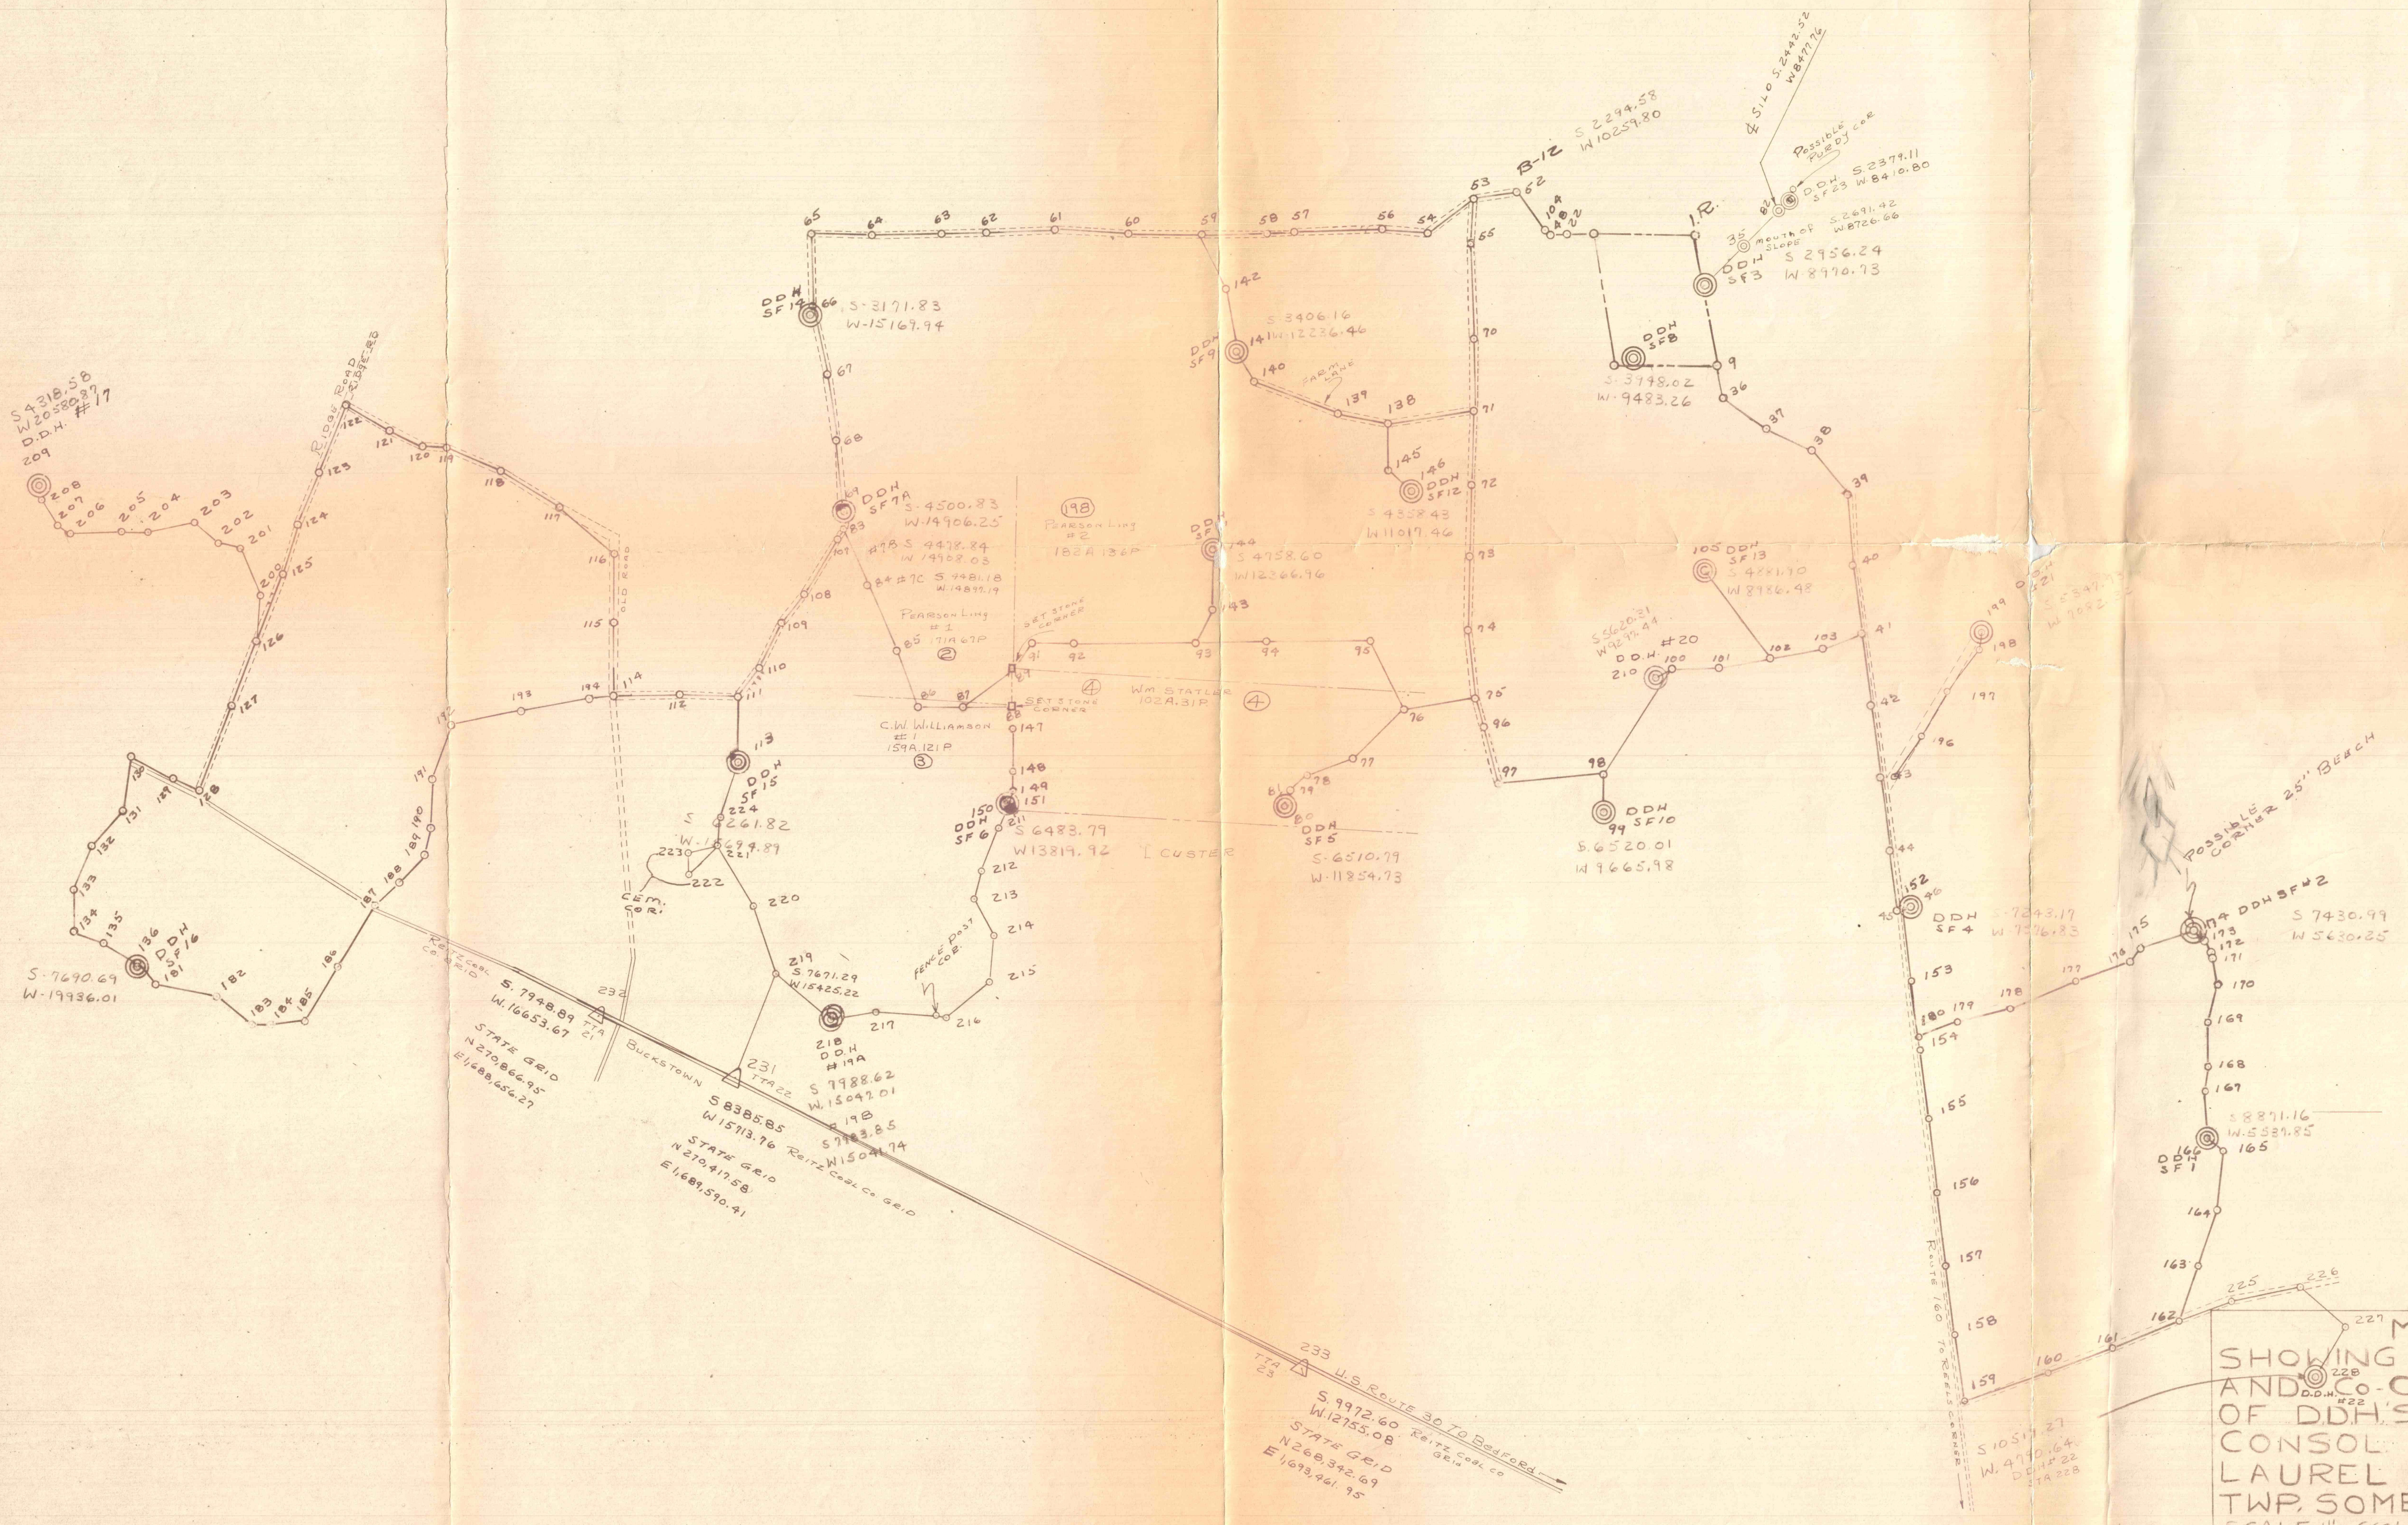

MAP
 SHOWING LOCATION
 AND CO-ORDINATES
 OF DDH'S OF THE
 CONSOL COAL CO.
 LAUREL MINE-SHADE
 TWP. SOMERSET CO.
 SCALE 1" = 660' VEERICKSON PE 7074

REVISION		
Number	Date	Initial
1	Nov 71	W.R.E.
2	Jan 72	W.R.E.
3		
4		
5		
6		
7		
8		
9		
10		

D-56
 DRAWING NO. REFERENCE

1/10"

1/8" - 1/4"

3/8" - 3/4"

1/2" - 1"

8387111782