





PK 20  
WATER TANK  
2000 GAL.

SHEET 4-C

D - Extent of mining as of last survey date Nov 30, 1975  
E - Extent of mining as of last survey date MAY 31, 1976

PREPARED BY  
Aerial Map Service Co.  
Pittsburgh, Penna.

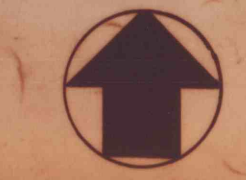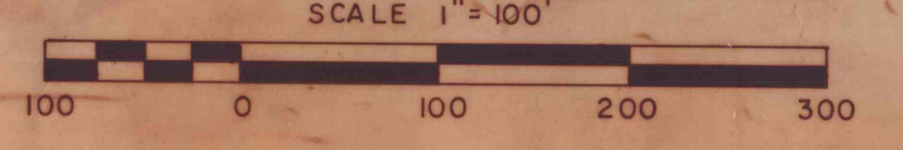

LAUREL MINE

4-D

SHEET 3-D