



WATER TANK
200,000 GAL.
EL. GR. 2596.66


SHAFT DATA
INTAKE/RETURN
20 FT. DIA.
364 FT. DEEP
8" CURTAIN WALL
150 SQ. FT. EACH SIDE

FAN DATA
JEFFREY 8HU-96 AERODYNE
8 FT. DIAMETER
500 H.P. - 885 R.P.M.
2300 VOLTS - 112 AMPS
3B-3S BLADE SETTING
2.9 INCHES WATERGAUGE

MAIN SHAFT
2420.52 EL. TOP
2056.57 EL. BOT

WEST

D -> Extent of mining as of last survey date Nov 30, 1975
E -> Extent of mining as of last survey date MAY 31, 1976

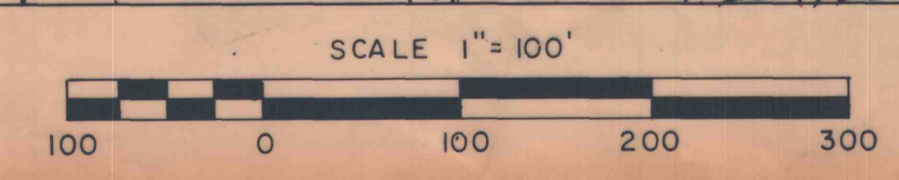

LAUREL MINE

4-D

PREPARED BY
Aerial Map Service Co.
Pittsburgh, Penna.