

MATCH LINE SHEET NO. 2



MARK MINING INC.  
MARK NO. 1 MINE  
STONYCREEK SHADE TOWNSHIPS  
SOMERSET COUNTY

SCALE: 1" = 200' DATE: Oct 18, 1979  
DATE OF LAST SURVEY: August 21, 1977  
SIN NORTH PRODUCTION: Geological Survey of Pennsylvania

RECEIVED  
DIVISION OF MINE  
SUBSIDENCE REGULATION  
OCT 18 1979  
MCMURRAY  
PENNSYLVANIA

DAVID S. MILLS, JR.  
DAVID S. MILLS, JR. 20888 G

LEGEND


CONTINUED FROM SHEET NO. 1





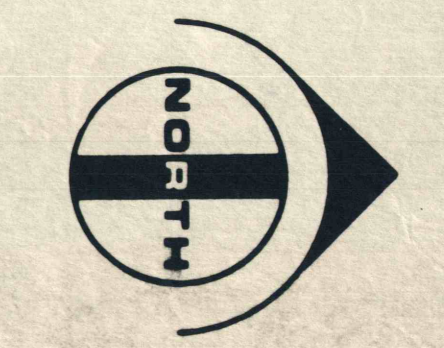

1	2	3
4	5	6

SHEET INDEX